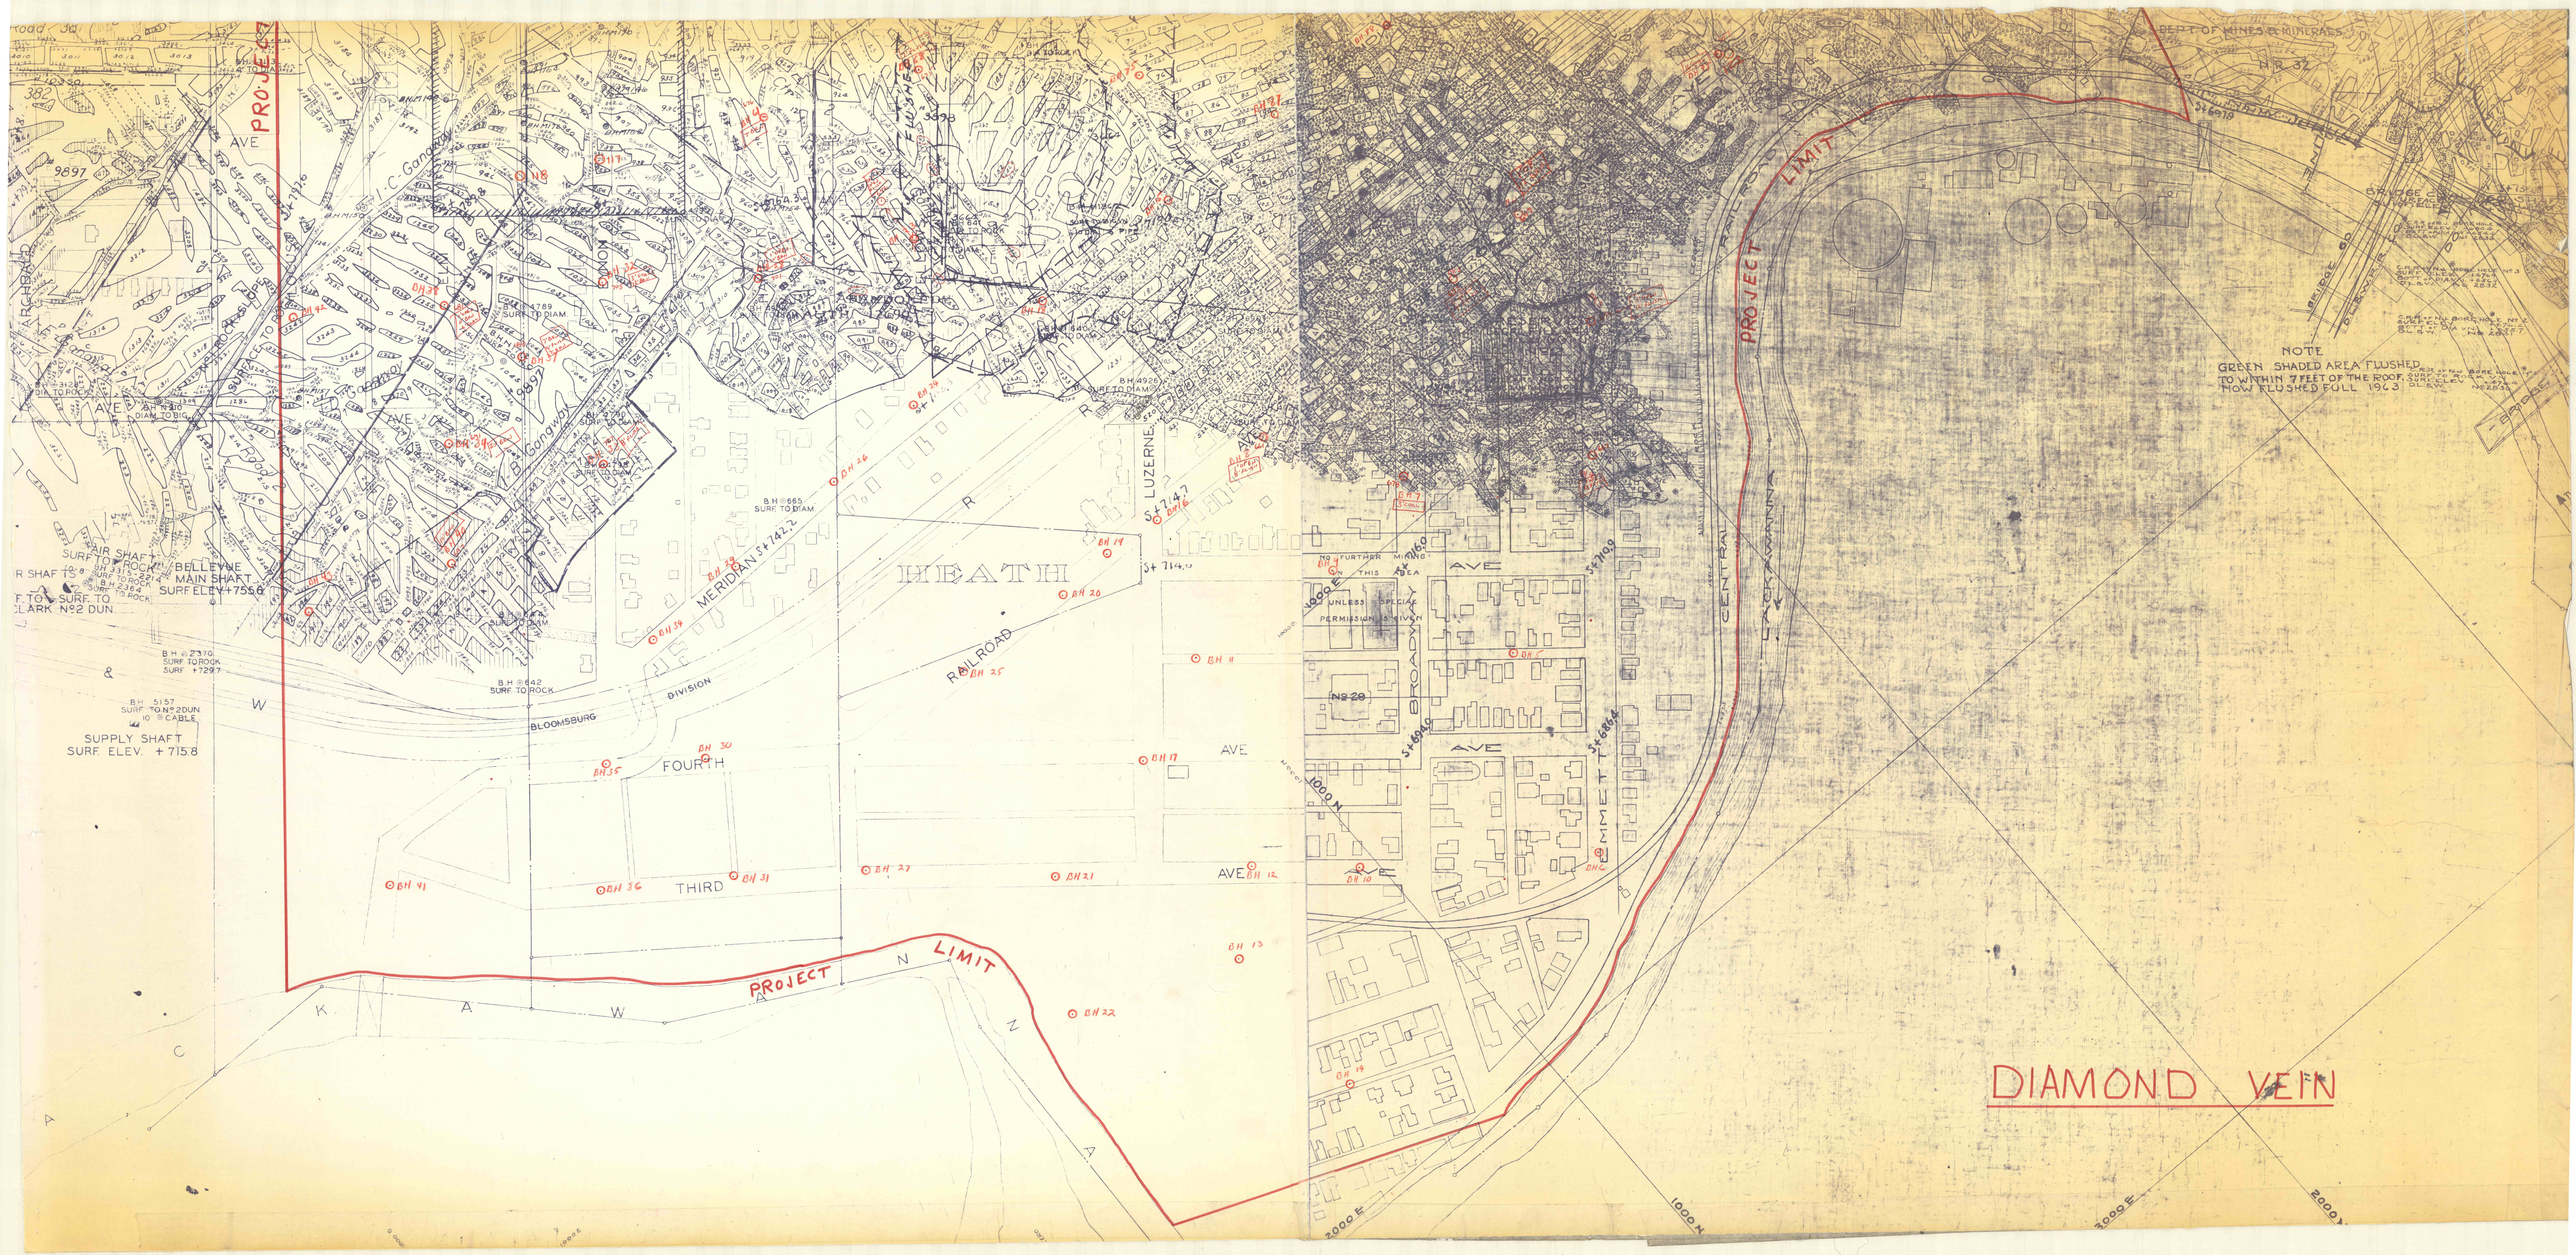
PROJECT LIMIT
PROJECT LIMIT
DIAMOND VEIN
NOTE
GREEN SHADED AREA FLUSHED TO WITHIN 7 FEET OF THE ROOF. SURF TO ROOF SURF ELEV +7558 SLARK
NOW FLUSHED FULL 1963
HEATH
FOURTH
THIRD
BROADWAY
EMMETT
AVE
BLOOMSBURG
DIVISION
RAILROAD
MERIDIAN S+142.2
S+714.0
S+771.7
S+771.09
S+694.9
S+685.4
1000 N
2000 E
SUPPLY SHAFT
SURF ELEV. +7158
AIR SHAFT
SURF TO ROCK
BELLEVUE
MAIN SHAFT
SURF ELEV+7558
SURF TO SURF TO
CLARK N82 DUN
B.H. 5157
SURF TO N82DUN
10 CABLE
B.H. 2370
SURF TO ROCK
SURF +7297
B.H. 642
SURF TO ROCK
B.H. 665
SURF TO DIAM
B.H. 4926
SURF TO DIAM
B.H. 4789
SURF TO DIAM
B.H. 2760
SURF TO DIAM
B.H. 3128
DIA TO ROCK
B.H. 3164
SURF TO ROCK
B.H. 3315
SURF TO ROCK
B.H. 2214
DIAM TO BIG
B.H. 3310
DIAM TO BIG
B.H. 3124
DIA TO ROCK
B.H. 3126
DIA TO ROCK
B.H. 3127
DIA TO ROCK
B.H. 3129
DIA TO ROCK
B.H. 3130
DIA TO ROCK
B.H.