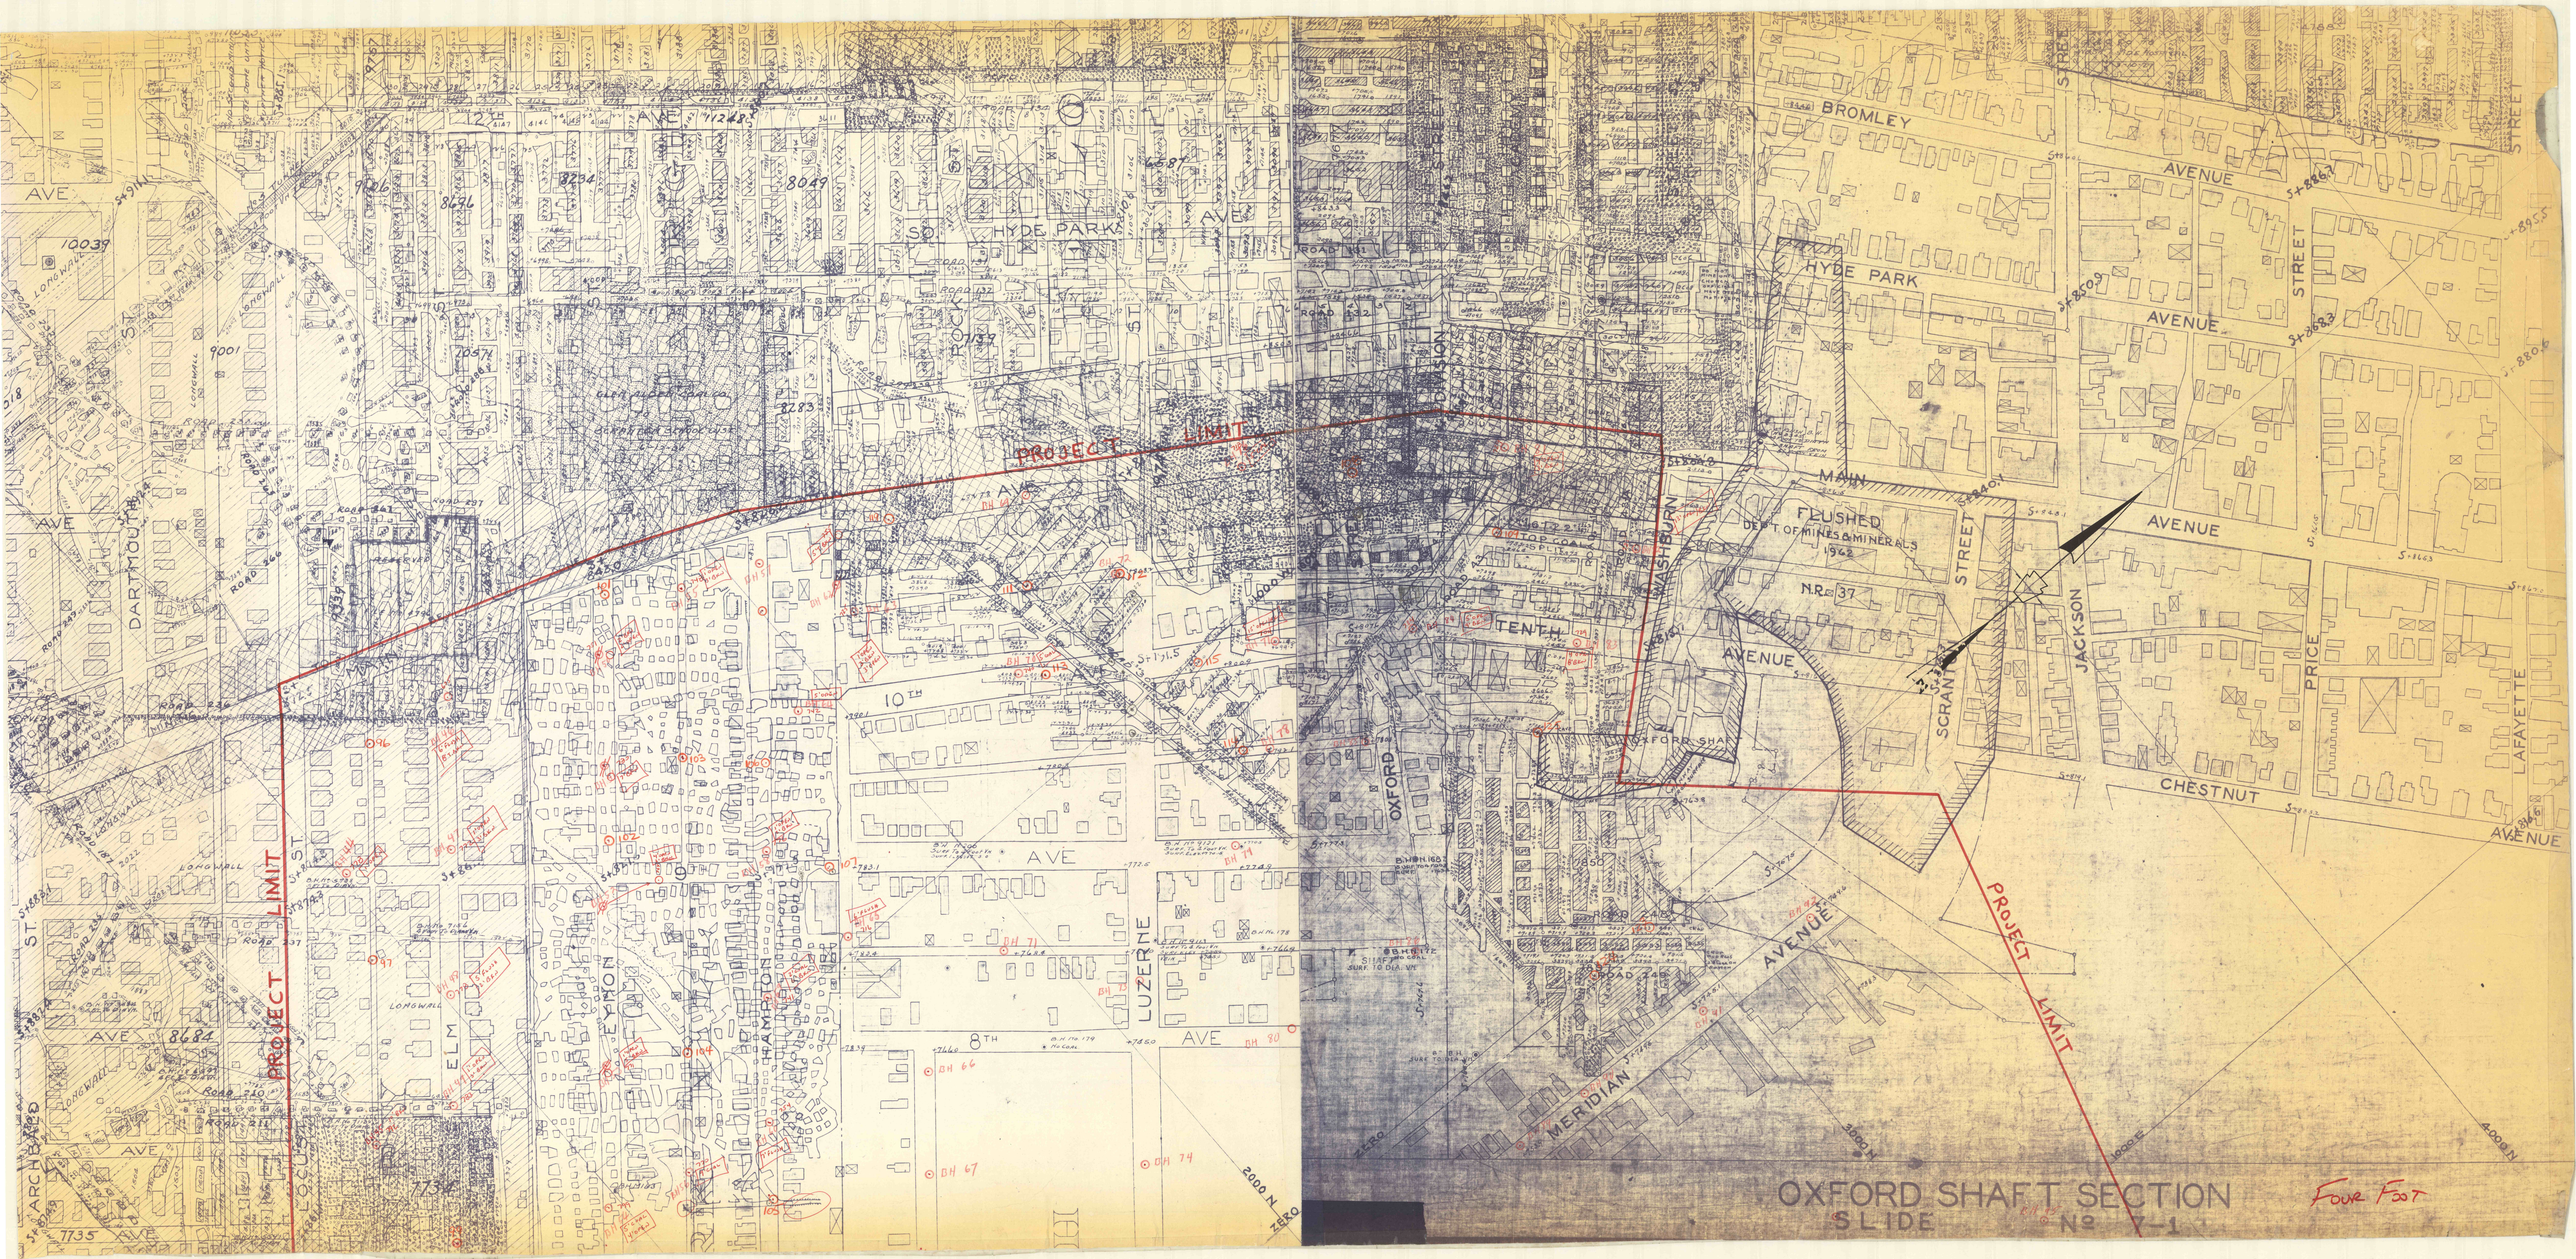
PROJECT LIMIT
PROJECT LIMIT
HYDE PARK
BROMLEY
AVENUE
STREET
MAIN
AVENUE
TENTH
AVENUE
CHESTNUT
AVENUE
DARTMOUTH
ELM
LUZERNE
OXFORD
WASHBURN
JACKSON
PRICE
LAFAYETTE
SCRANTON
FLUSHED
DEPT. OF MINES & MINERALS
1962
N.R. 37
OXFORD SHAFT
MERIDIAN
8TH
10TH
AVE
ROAD 240
ROAD 241
ROAD