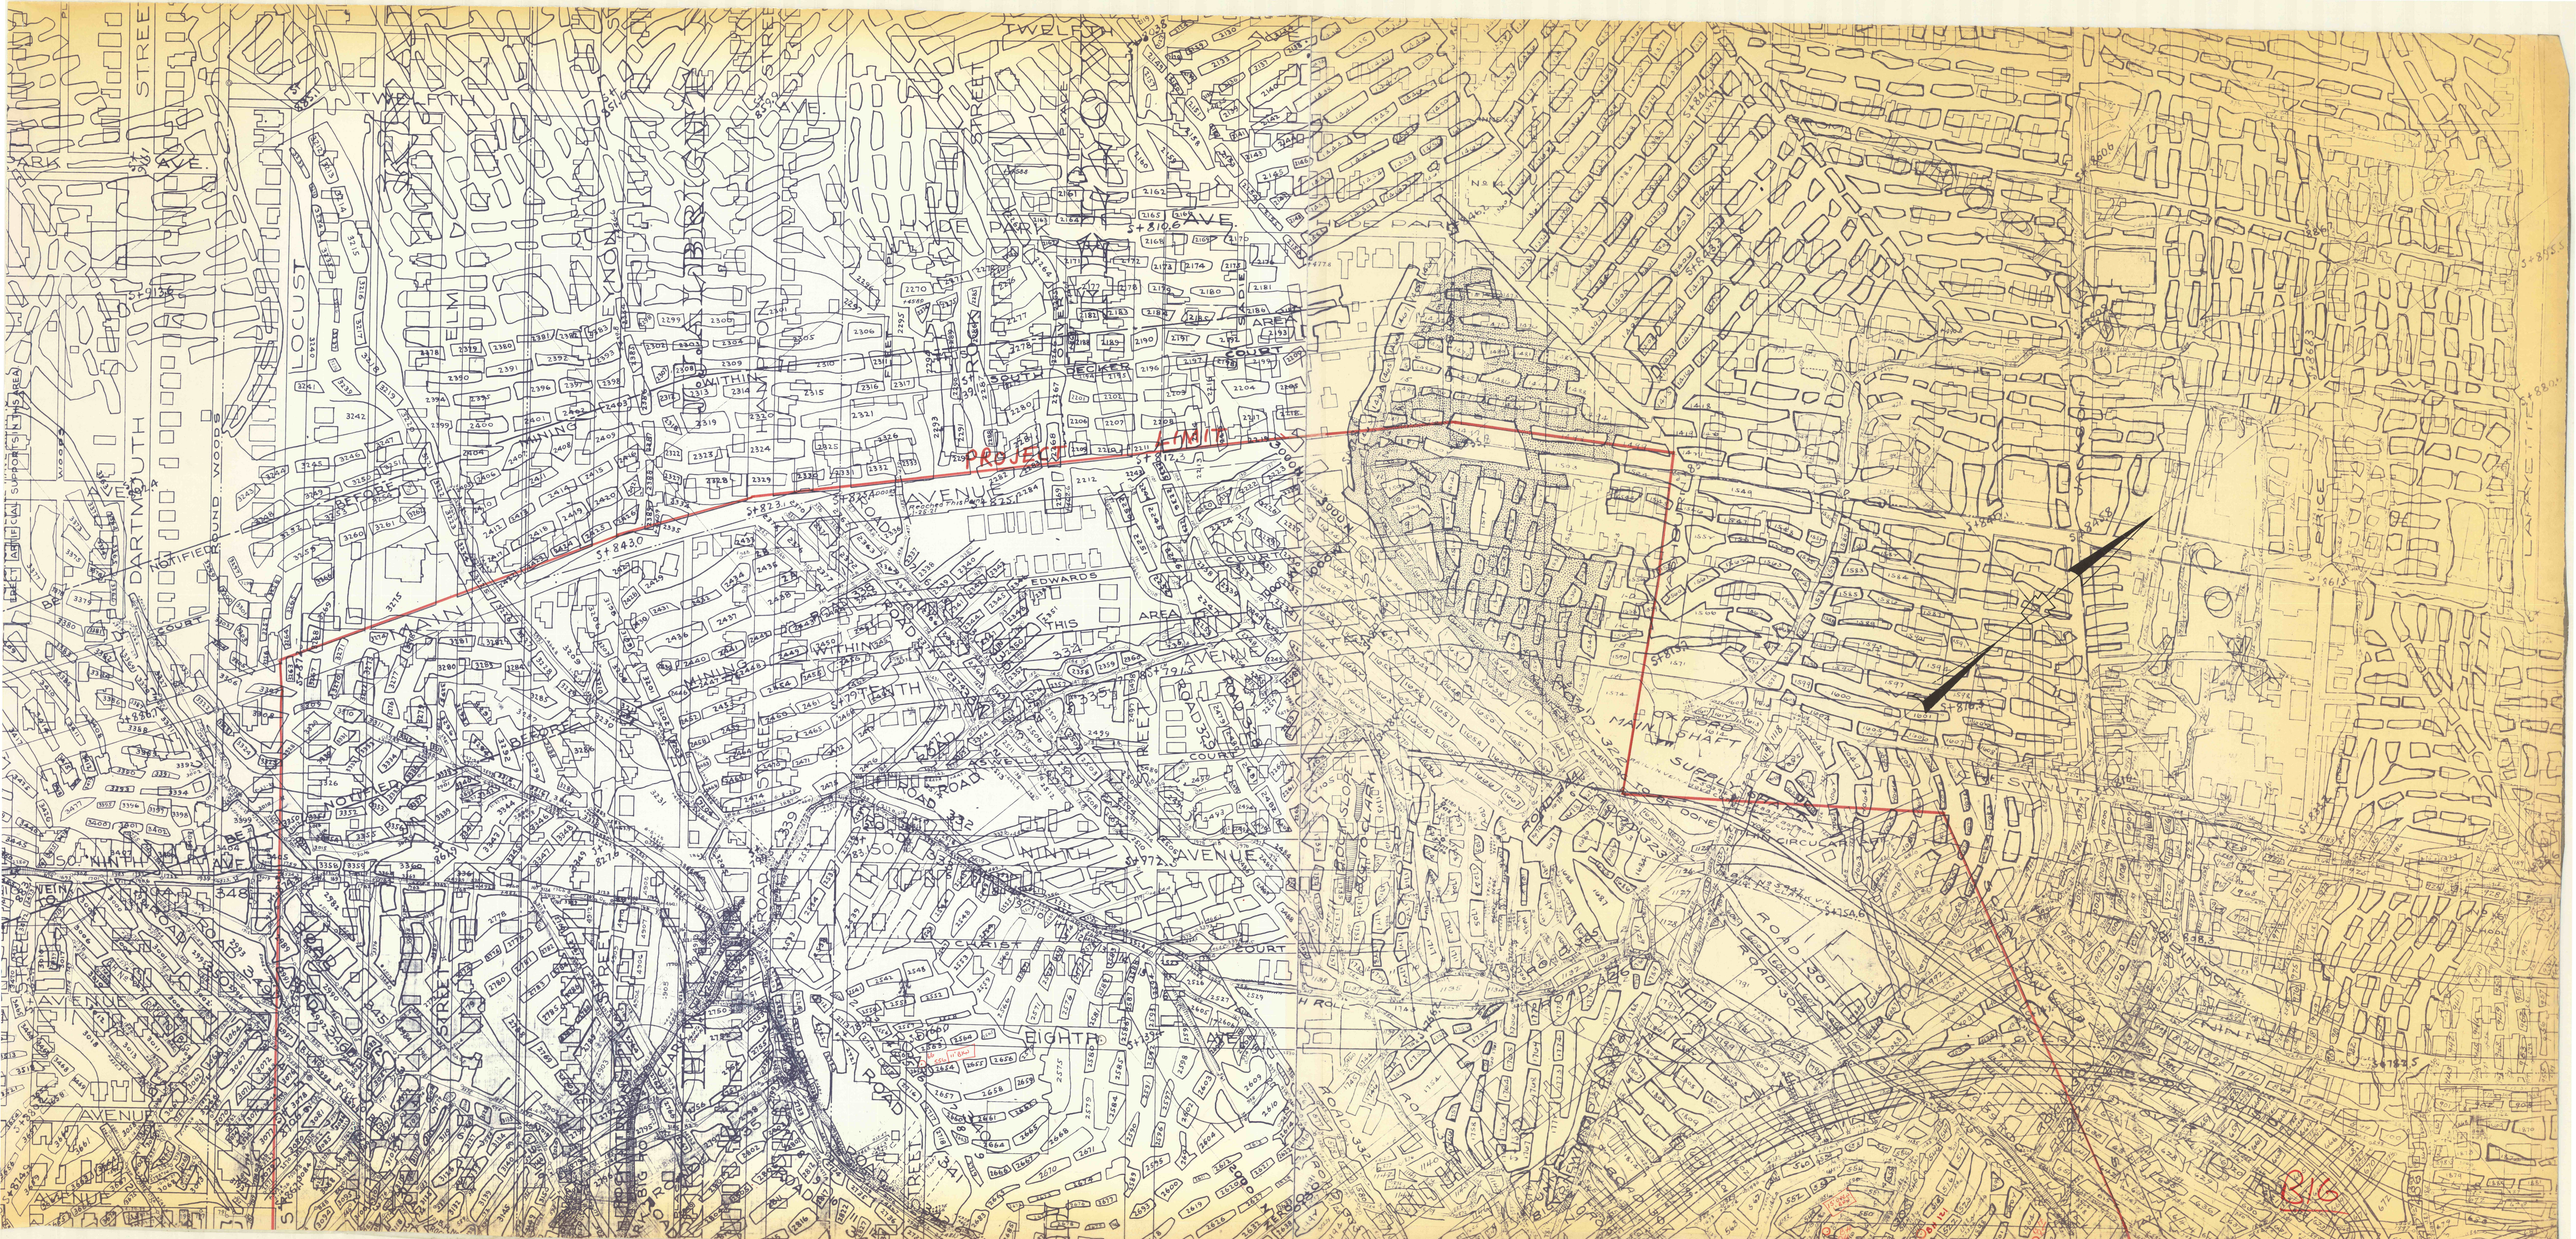

PROJECT LIMIT
TWELFTH AVE.
PARK AVE.
HYDE PARK AVE.
LOCUST
ELM
STREET
PLACE
FLEET
ROCK
OLIVER
SADIE
SOUTH DECKER COURT
DARTMOUTH
WOODS
AVE.
COURT
ERECT ARTIFICIAL SUPPORTS IN THIS AREA
NOTIFIED BEFORE MINING WITHIN THIS AREA
NOTIFIED BEFORE
MINING WITHIN
MAIN
AVENUE
Reached This Point 1-28-21
EDWARDS
COURT
THIS AREA
TENTH AVENUE
SO. NINTH AVE.
NINTH AVENUE
EIGHTH AVE.
CHRIST COURT
ROAD 348
ROAD 349
ROAD 338
ROAD 339
ROAD 332
ROAD 329
ROAD 328
ROAD 334
ROAD 335
ROAD 341
ROAD 345
ROAD 346
ROAD 323
ROAD 322
ROAD 324
ROAD 326
ROAD 301
ROAD 302
ROAD 332
ROCK SLOPE
BIG TO CLARK
CLARK
BIG TO CLARK
ZERO
2000 N
3000 N
1000 W
H ROLL
OXFORD
MAIN SHAFT
SUPPLY SHAFT
MINING TO BE DONE WITHIN CIRCULAR SHAFT
RAIL IN VEIN ABOVE C
OFF BOTTOM OF CUT
B.H. No 5947 TO CLARK VN.
CHESTNUT
SCHOOL
PRICE
LAFAYETTE
AVE
No 14
S+885.1
S+851.6
S+859.9
S+913.6
S+924
S+823.1
S+825.4
S+825.1
S+843.0
S+810.6
S+812.3
S+846.2
S+841.1
S+843.3
S+860.6
S+886.7
S+895.5
S+868.3
S+880.0
S+850.8
S+840.1
S+845.8
S+861.5
S+813.7
S+810.7
S+808.3
S+782.5
S+833.3
S+754.6
S+791.5
S+772.5
S+739.4
S+779
S+783.50
S+827.6
S+861.9
S+874
S+886.7
S+814.9
S+862
S+806
66
556
11' BKN
15' OPEN 5' BKN
BH 121
B16