F-232-2

F-232-2

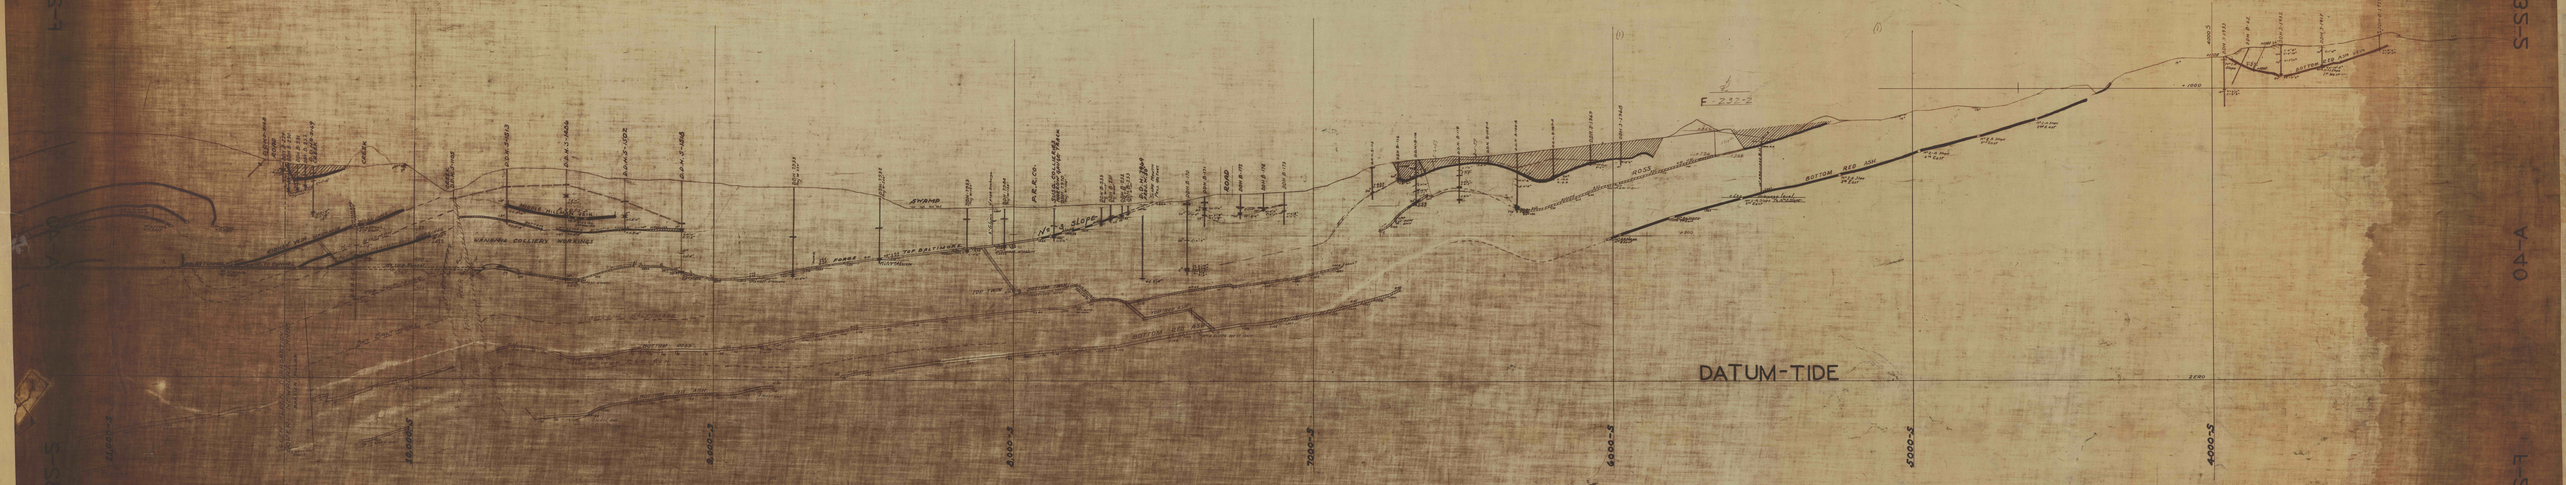

S-535-5

S-535-5

S-535-5

S-535-5

OA-A