

F-133-1

F-133-1

F-133-1


F-133-1

A-42

A-42

F-133-1

F-133-1

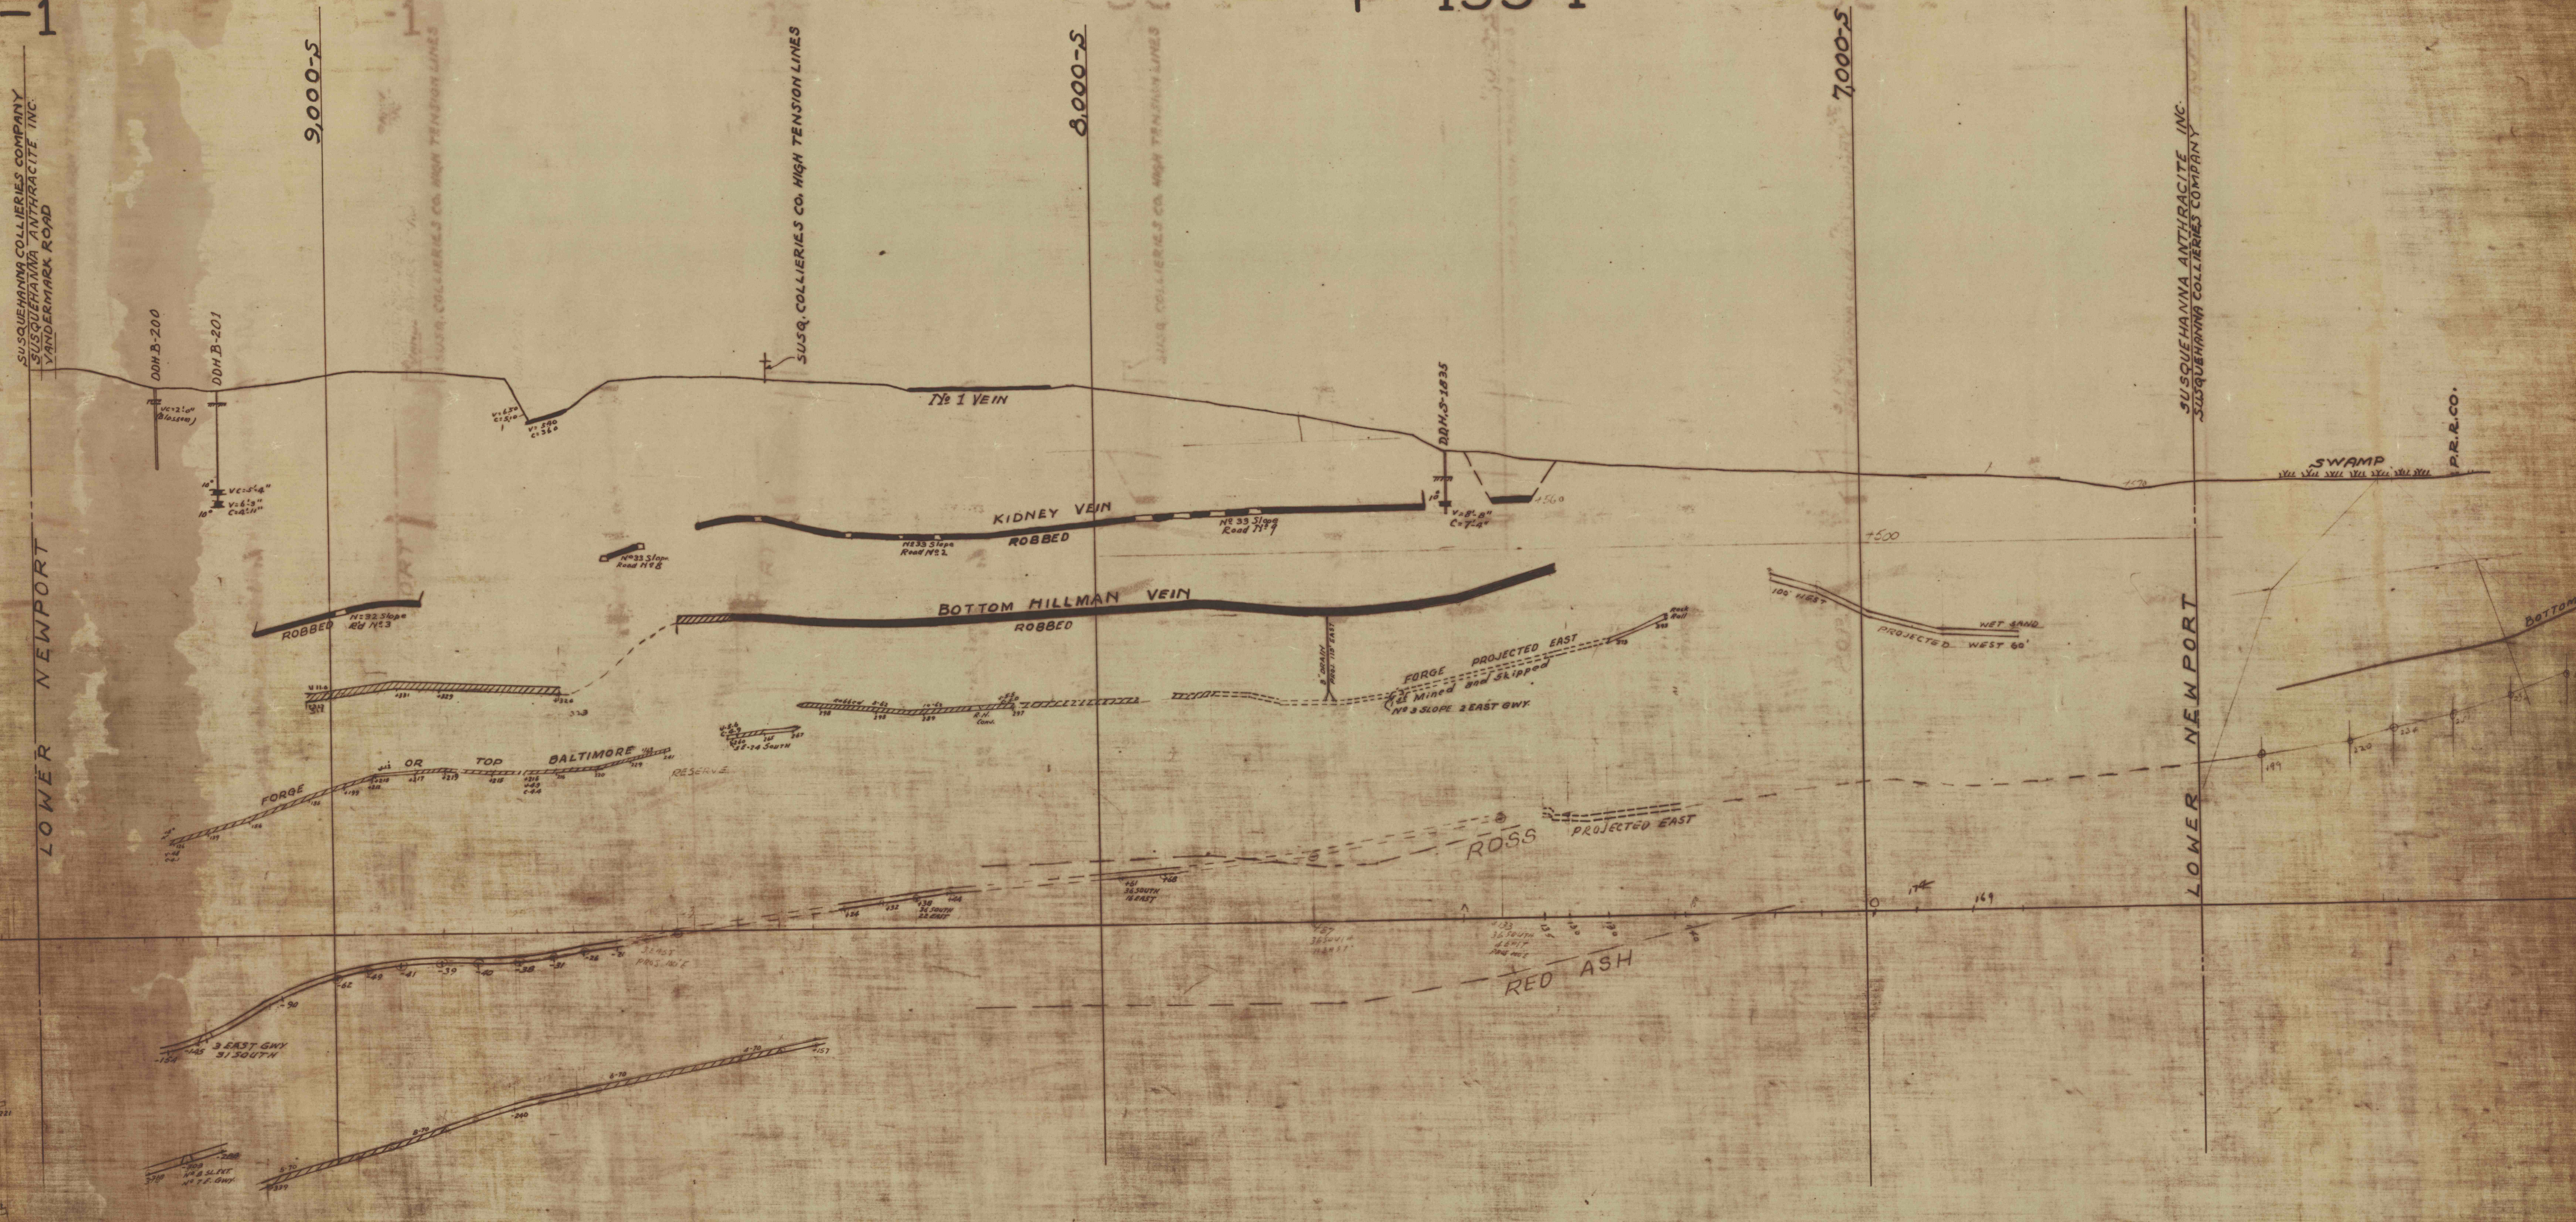

SUSQUEHANNA COLLIERIES COMPANY  
SUSQUEHANNA ANTHRACITE INC.  
VANDERMARK ROAD

DDH B-200  
DDH B-201  

SUSQ. COLLIERIES CO. HIGH TENSION LINES

SUSQ. COLLIERIES CO. HIGH TENSION LINES

SUSQUEHANNA ANTHRACITE INC.  
SUSQUEHANNA COLLIERIES COMPANY

P.R.R.CO.

ROBBED

ROBBED

ROBBED

FORGE PROJECTED EAST  
Not Mined and Skipped  

ROSS PROJECTED EAST

RED ASH

SWAMP

BOTTOM BALTIMORE (SOUTH BOWTWIN) VEIN  

FORGE OR TOP BALTIMORE RESERVE

PROJECTED WEST 60'

EAST GWY  
MARKER  
N 75 SLOPE 1 SOUTH





9,000-S

8,000-S

7,000-S

LOWER NEWPORT

LOWER NEWPORT