

F-134-1

F-134-1


F-134-1

N#7 COLLIERY
SUSQ. COLLIERIES COMPANY
SUSQUEHANNA ANTHRACITE INC.
VANDERMARK ROAD

SUSQ. COLLIERIES CO. HIGH TENSION LINES

SUSQUEHANNA ANTHRACITE INC.
SUSQUEHANNA COAL CO.
N#7 COLLIERY

LOWER NEWPORT

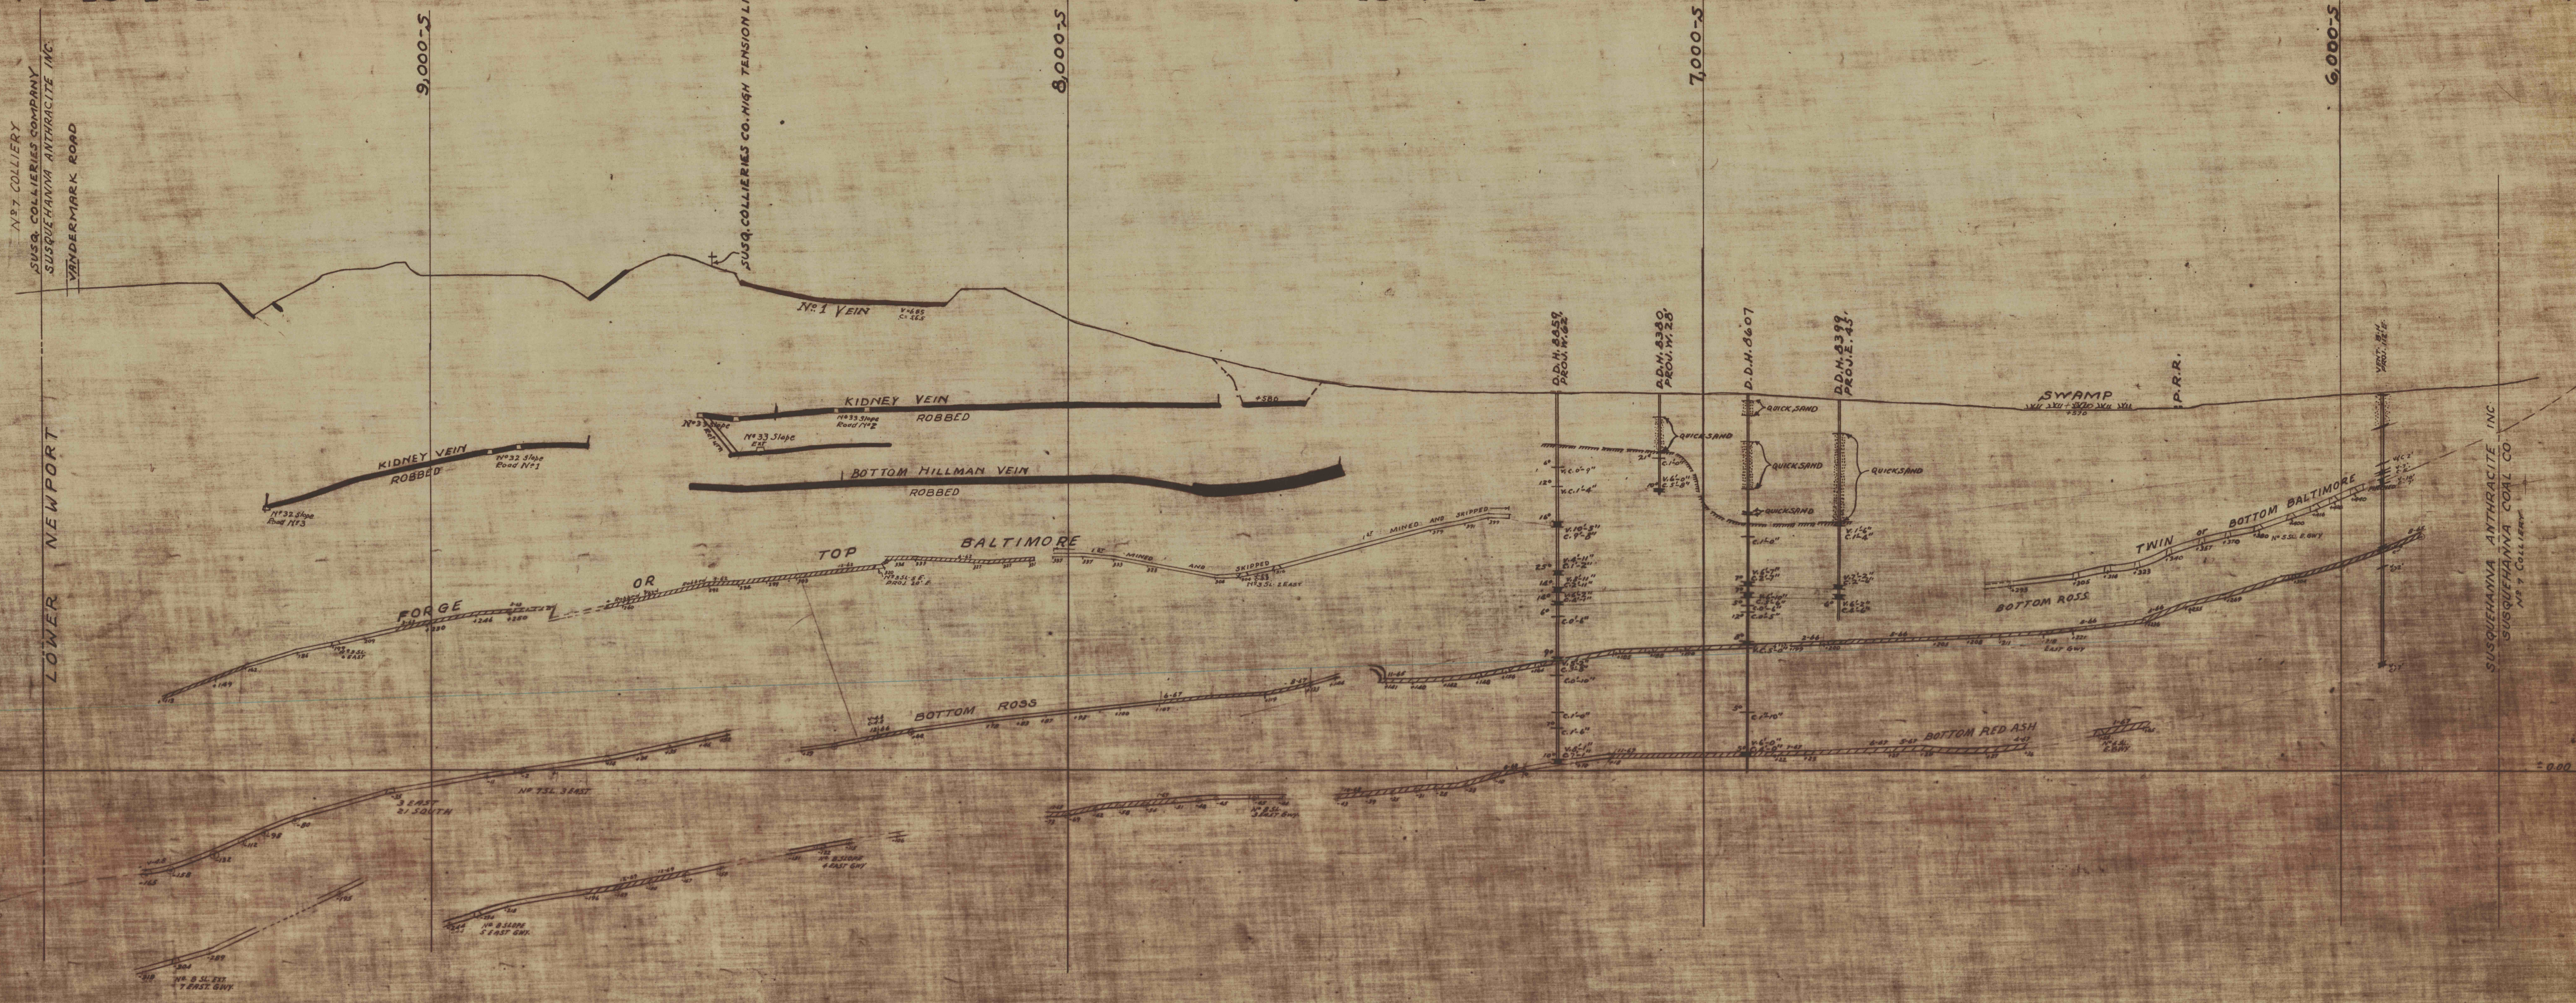

LLIERY
100
F-134-1

V-447

F-134-1

F-134-1

V-447

F-134-1