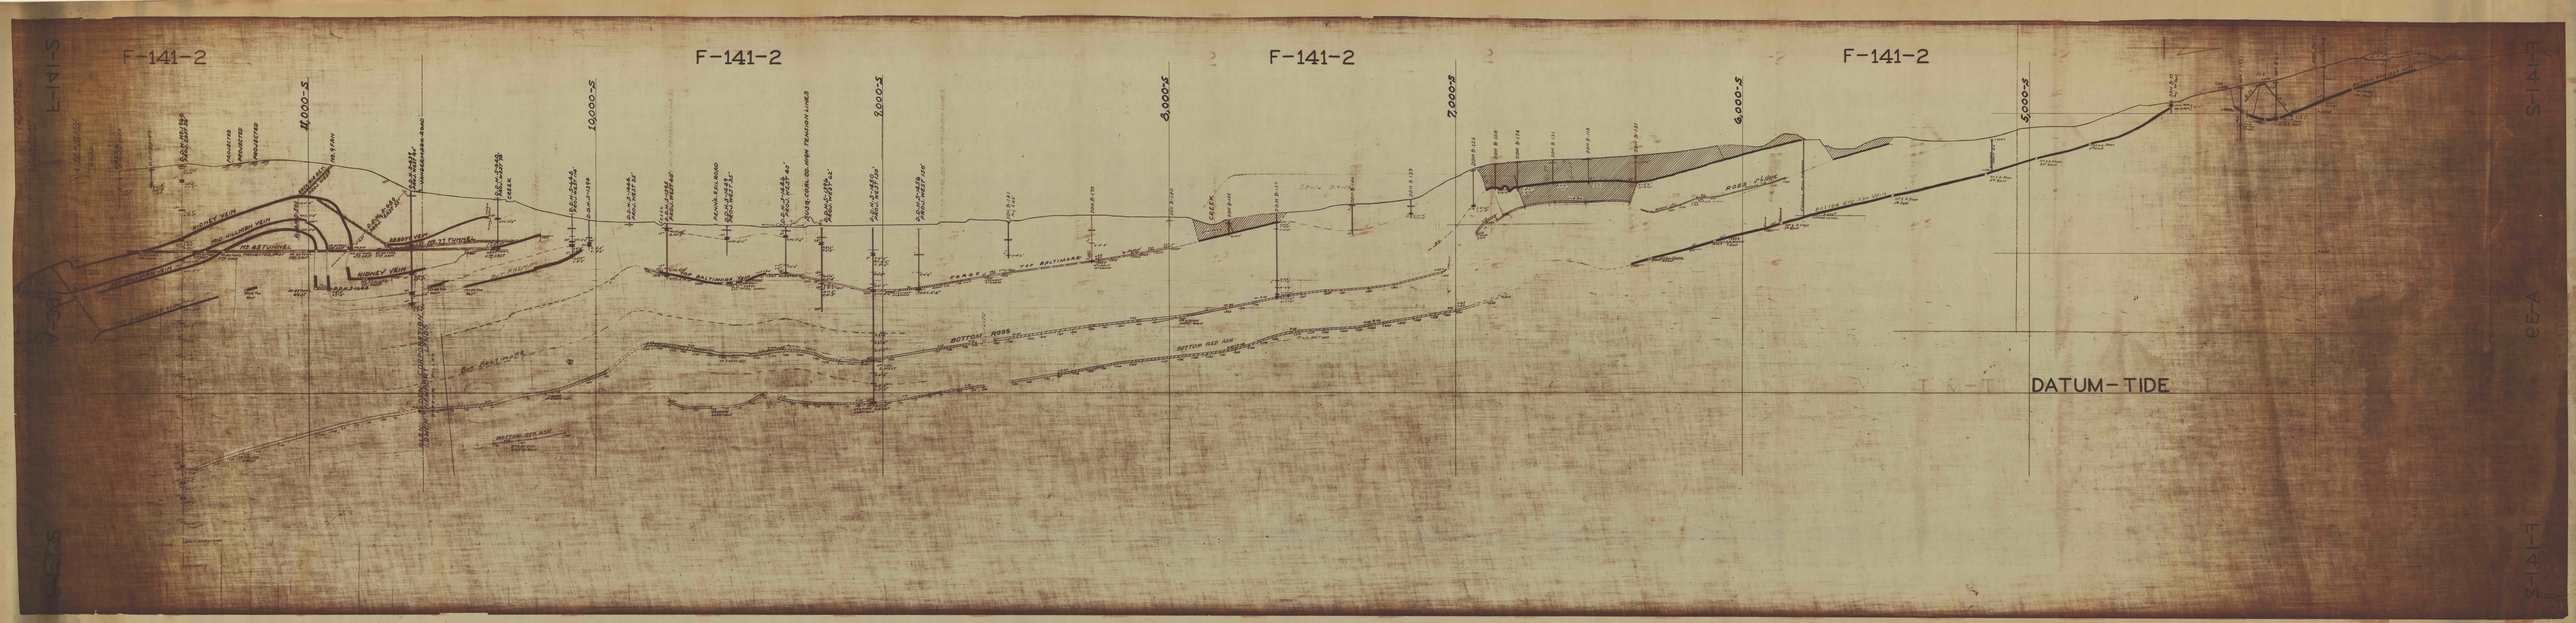
F-141-2
F-141-2
F-141-2
F-141-2
11,000-S
10,000-S
9,000-S
8,000-S
7,000-S
6,000-S
5,000-S
KIDNEY VEIN
KIDNEY VEIN
BOTTOM ROSS
BOTTOM RED ASH
DATUM-TIDE