


F-134-2

F-134-2

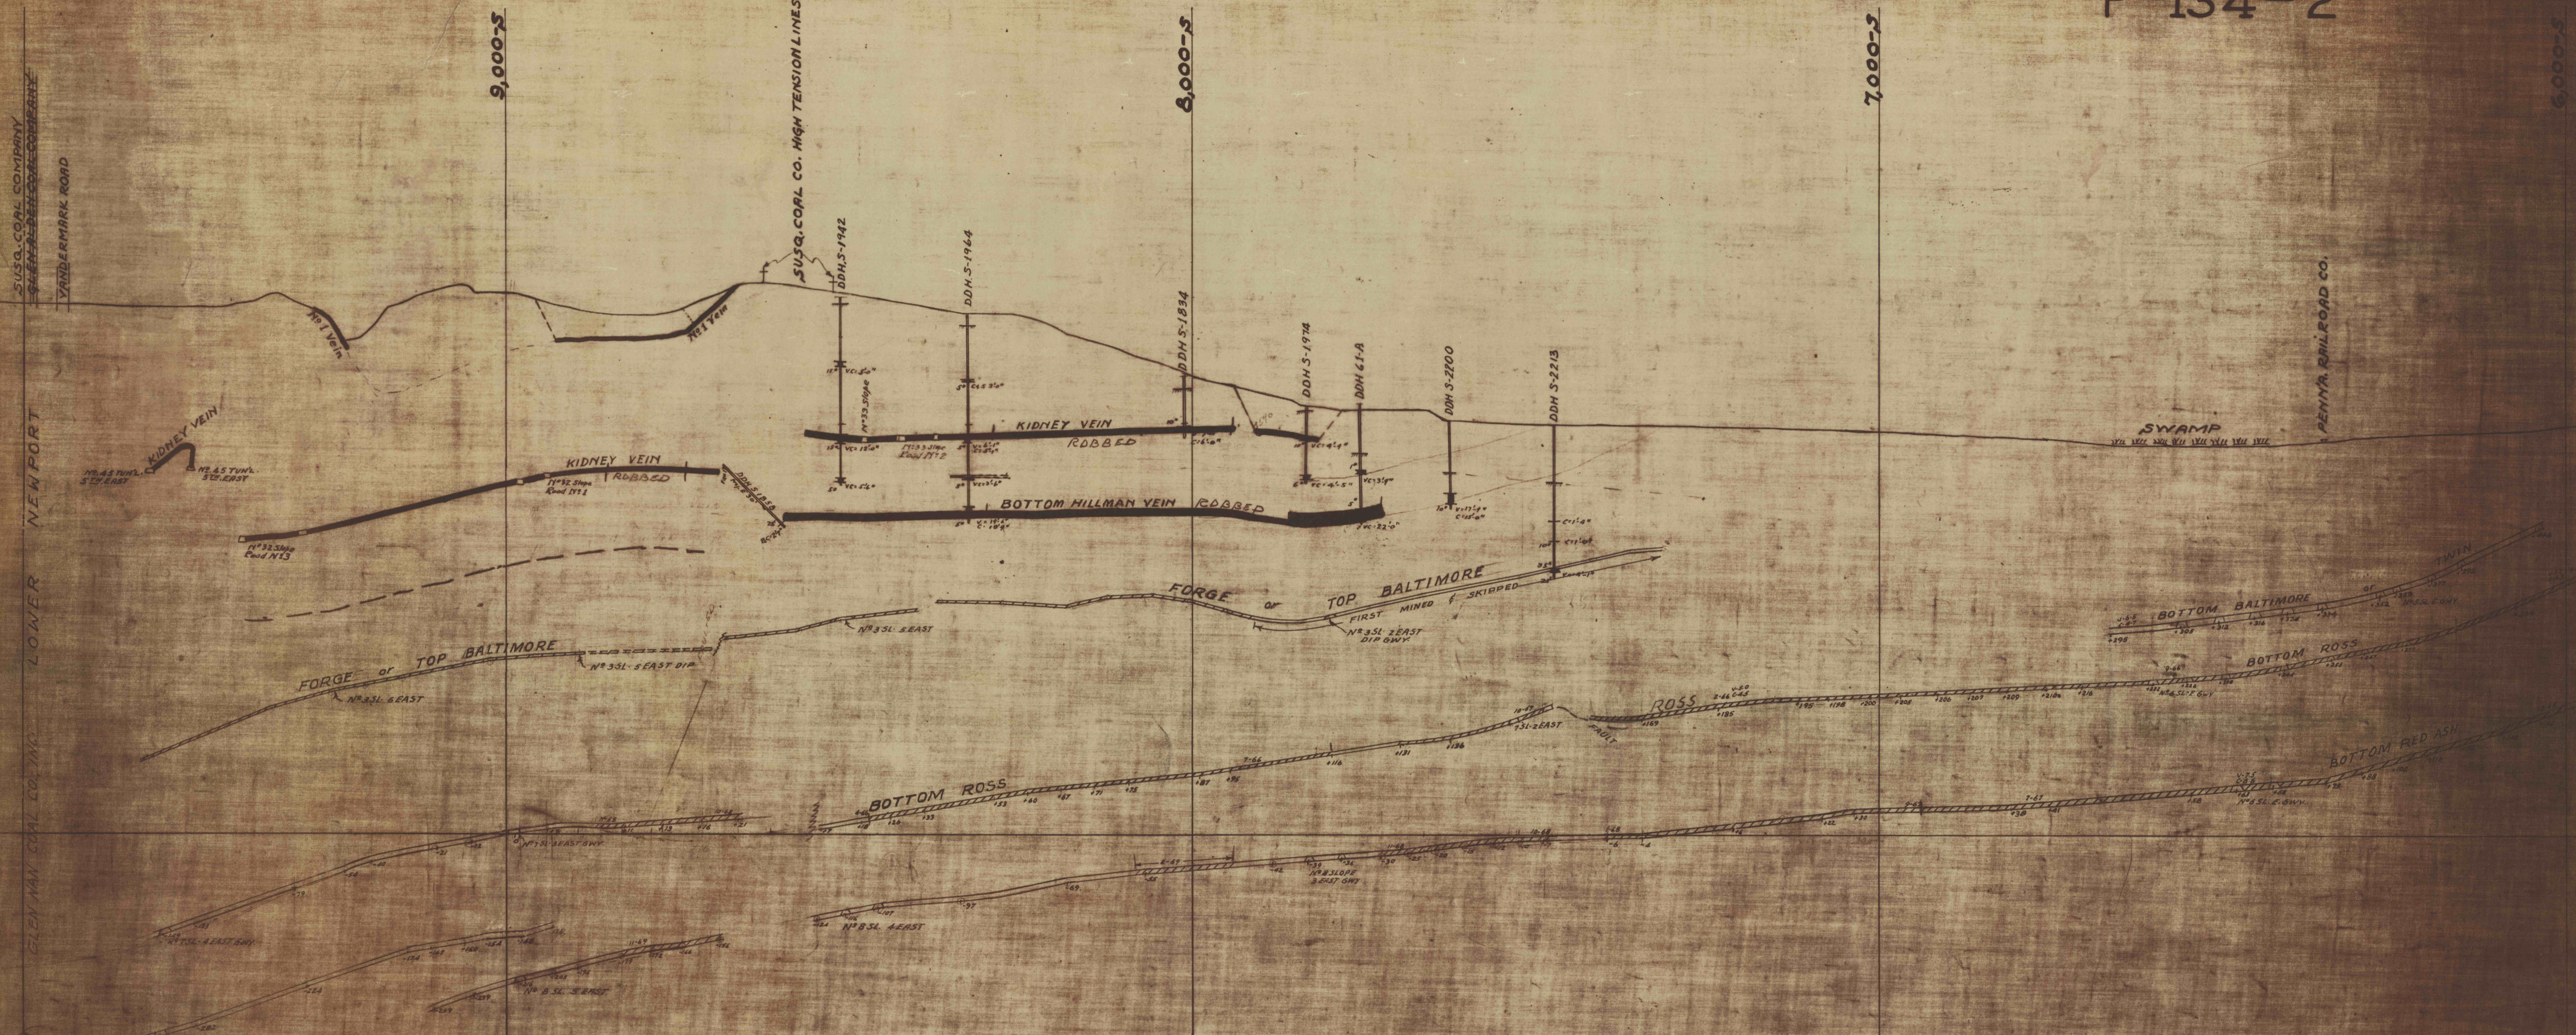




