


J. DOWLING

WASHINGTON LEE No. 6

W. G. STERLING

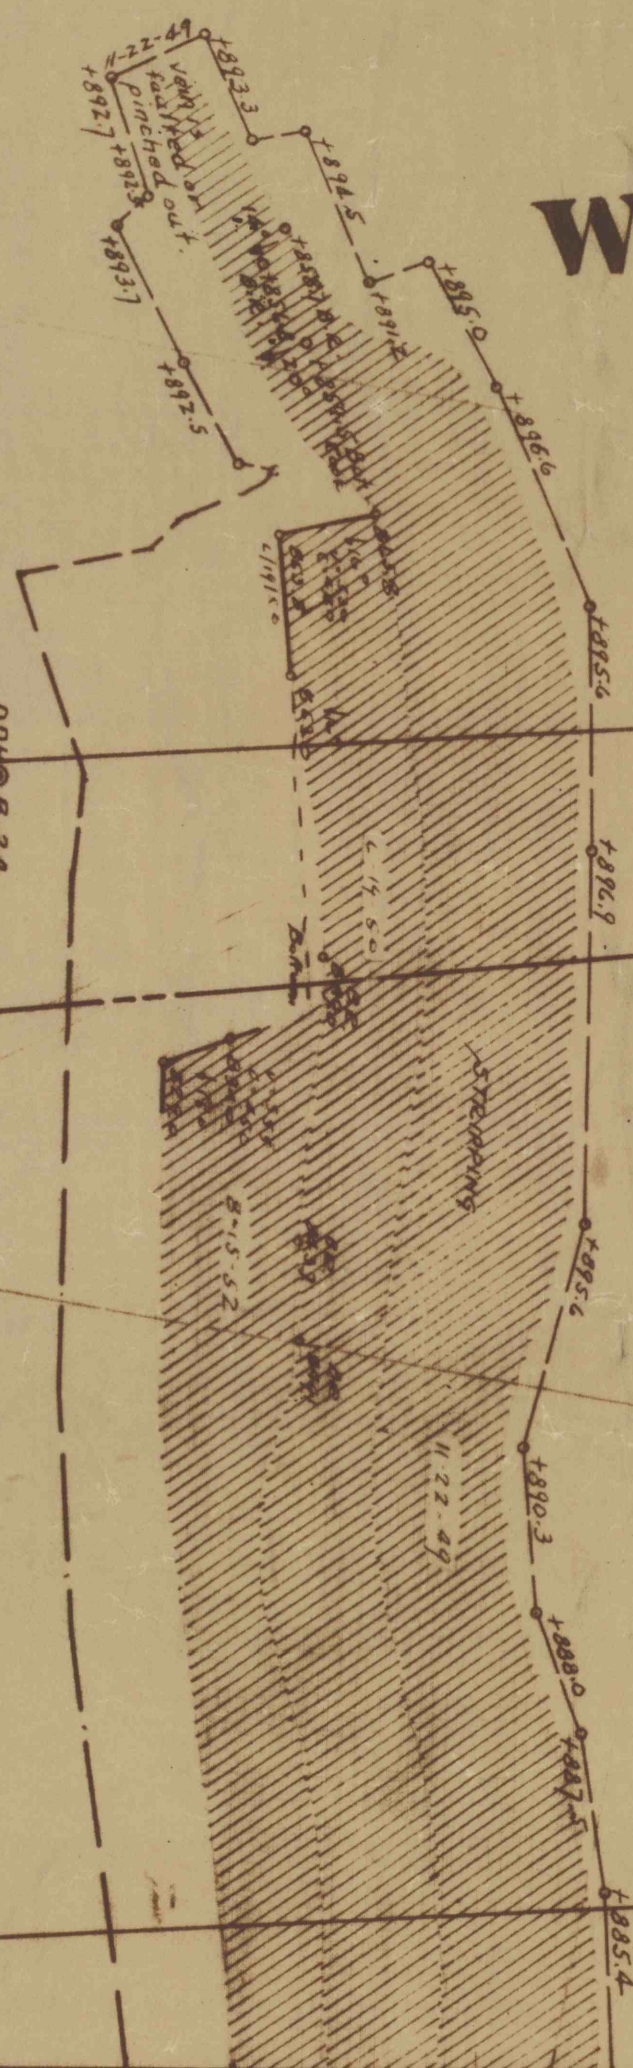

TRACING NO. 8

TRACING NO. 12

NO.11

BOTTOM ROSS VEIN

NO.11