
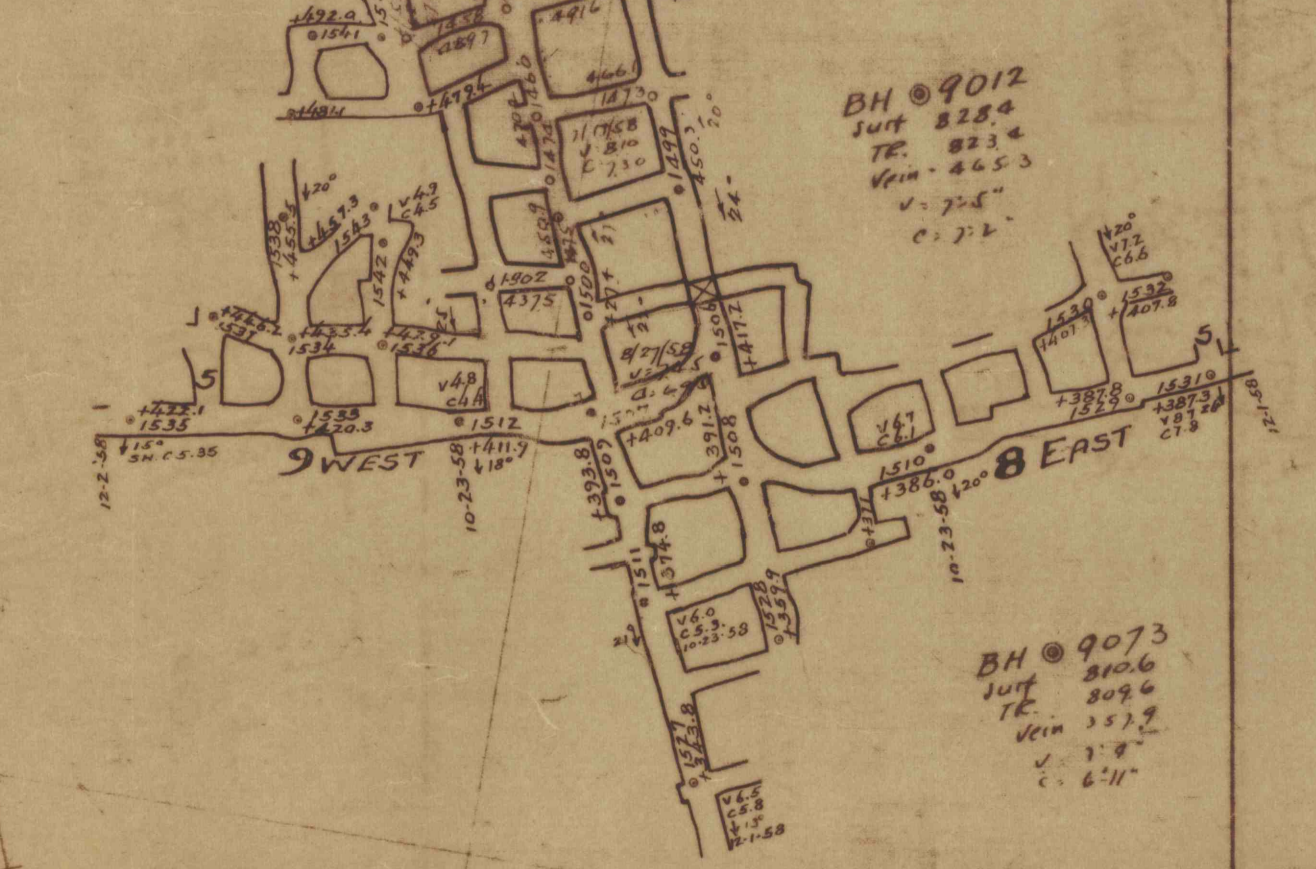


TRACING NO. 11
BOTTOM REE ASH VEIN

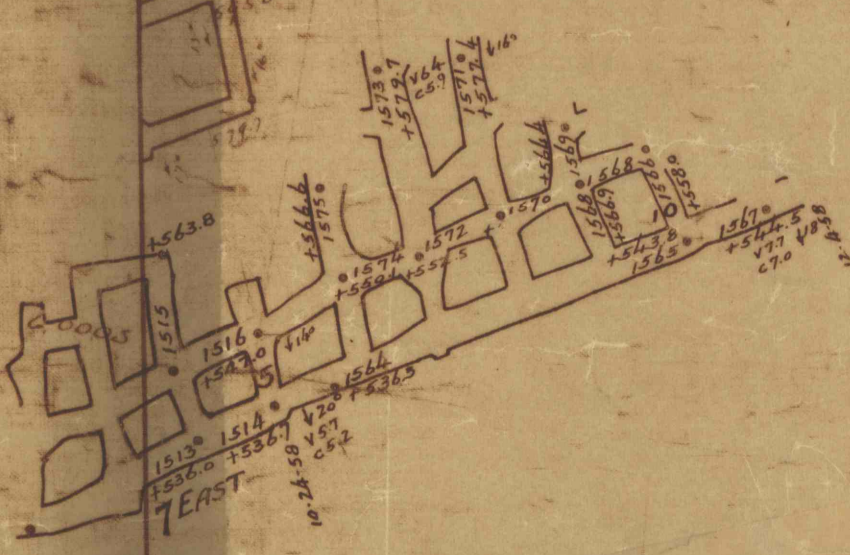








