#9

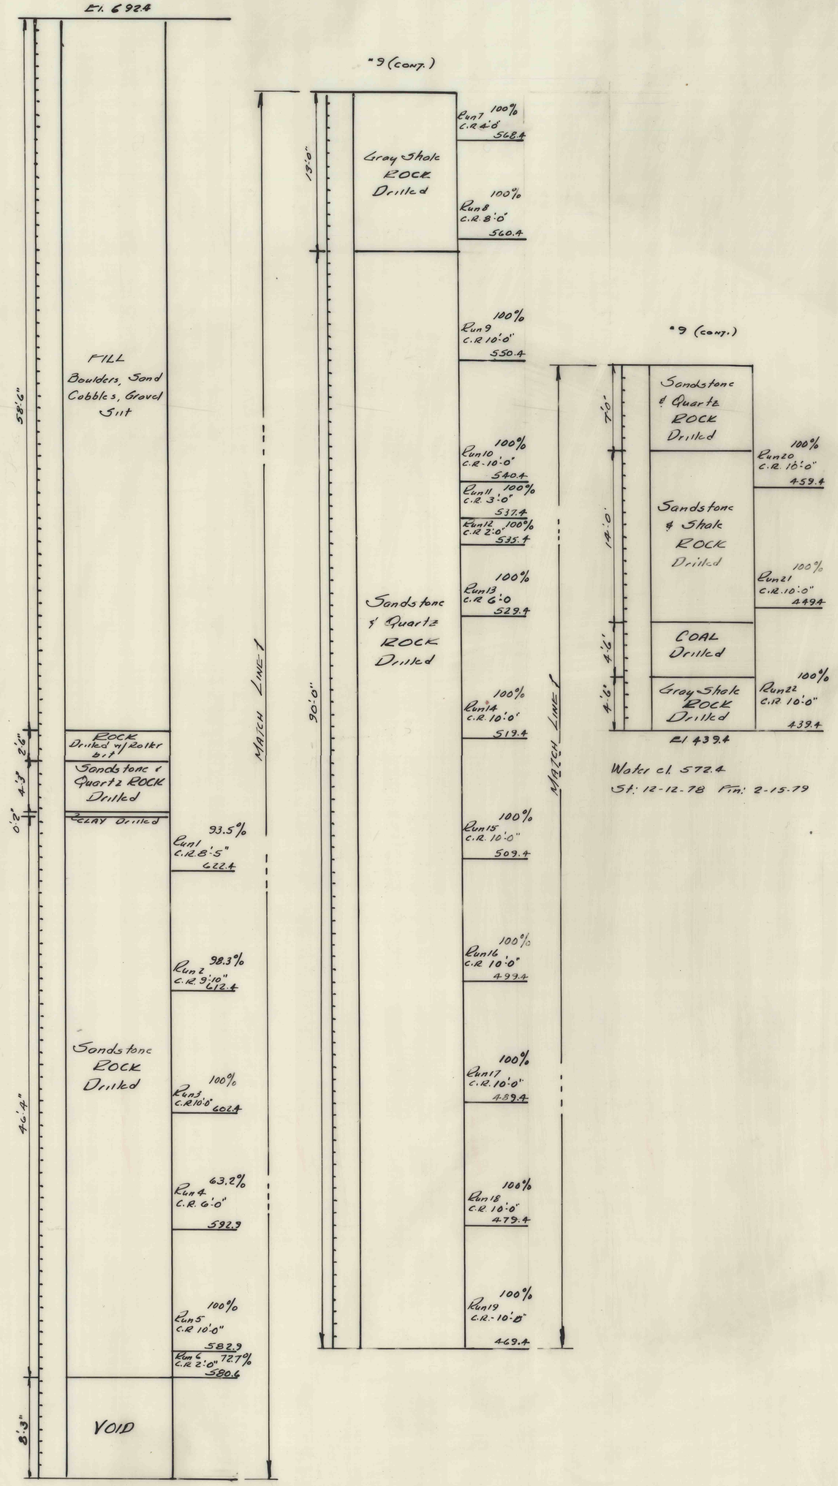

#10

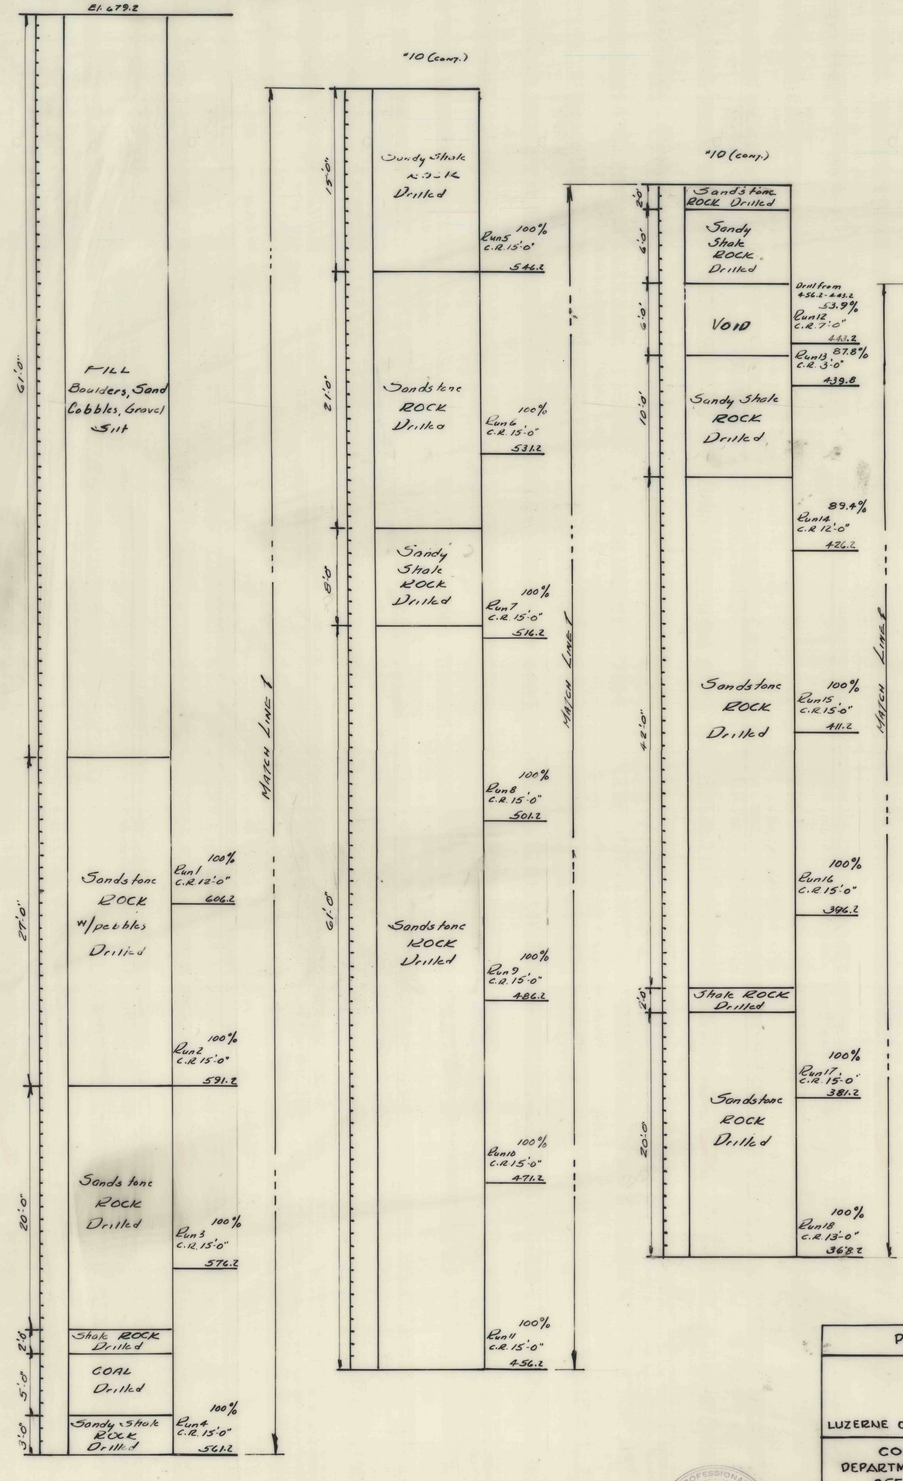

PROJECT NO AACMS-40-101.5

CORE BORINGS
ZAYRE BANK
WILKES-BARRE TWNSP.
LUZERNE CO. PENNA.

COMMONWEALTH OF PENNSYLVANIA
DEPARTMENT OF ENVIRONMENTAL RESOURCES
OFFICE OF RESOURCES MANAGEMENT

WARREN GEORGE INC.
BORING CONTRACTOR
JERSEY CITY NEW JERSEY

SCALES:
PLAN: A/S
SECTIONS 1"=6'

DATE: 4-3-79
DWN BY: J
CHKD BY:

REGISTERED PROFESSIONAL ENGINEER JOHN A. PROCACCINO STATE OF NEW YORK

J. A. Procaccino P.E.