

DEPARTMENT OF ENVIRONMENTAL RESOURCES

CONTINENTAL DRILLING-U.S.

CONTRACT NO. OSM PA (813) 101.5

PROJECT NO. OSM 40(5123) 101.5

PITTSTON, PA SITE 3

HOLE NO. 9	DEPTH DRILLED (COMPLETED)	132.0 LFT
	DEPTH DRILLED (BEGINNING)	0 LFT.

HOLE NO. 10	DEPTH DRILLED (COMPLETED)	150.0 LFT.
	DEPTH DRILLED (BEGINNING)	0 LFT.


DATE DRILLED: 15 JANUARY + 26 FEBRUARY 1986

DATE DRILLED: 4 JUNE 1986

SURFACE ELEVATION:


SURFACE ELEVATION:

DRILLING RUNS (ft.)		% CORE RECOV.
FROM	TO	
0	34.1	
34.1	39.1	90
39.1	43.6	63
43.6	47.6	80
47.6	50.6	100
50.6	53.6	60
53.6	56.9	98
56.9	61.9	75
61.9	63.6	0
63.6	66.6	80
66.6	70.3	88
70.3	71.4	22
71.4	77.3	98
77.3	83.9	
83.9	93.9	100
93.9	103.9	100
103.9	108.3	98
108.3	122	
122	132	82

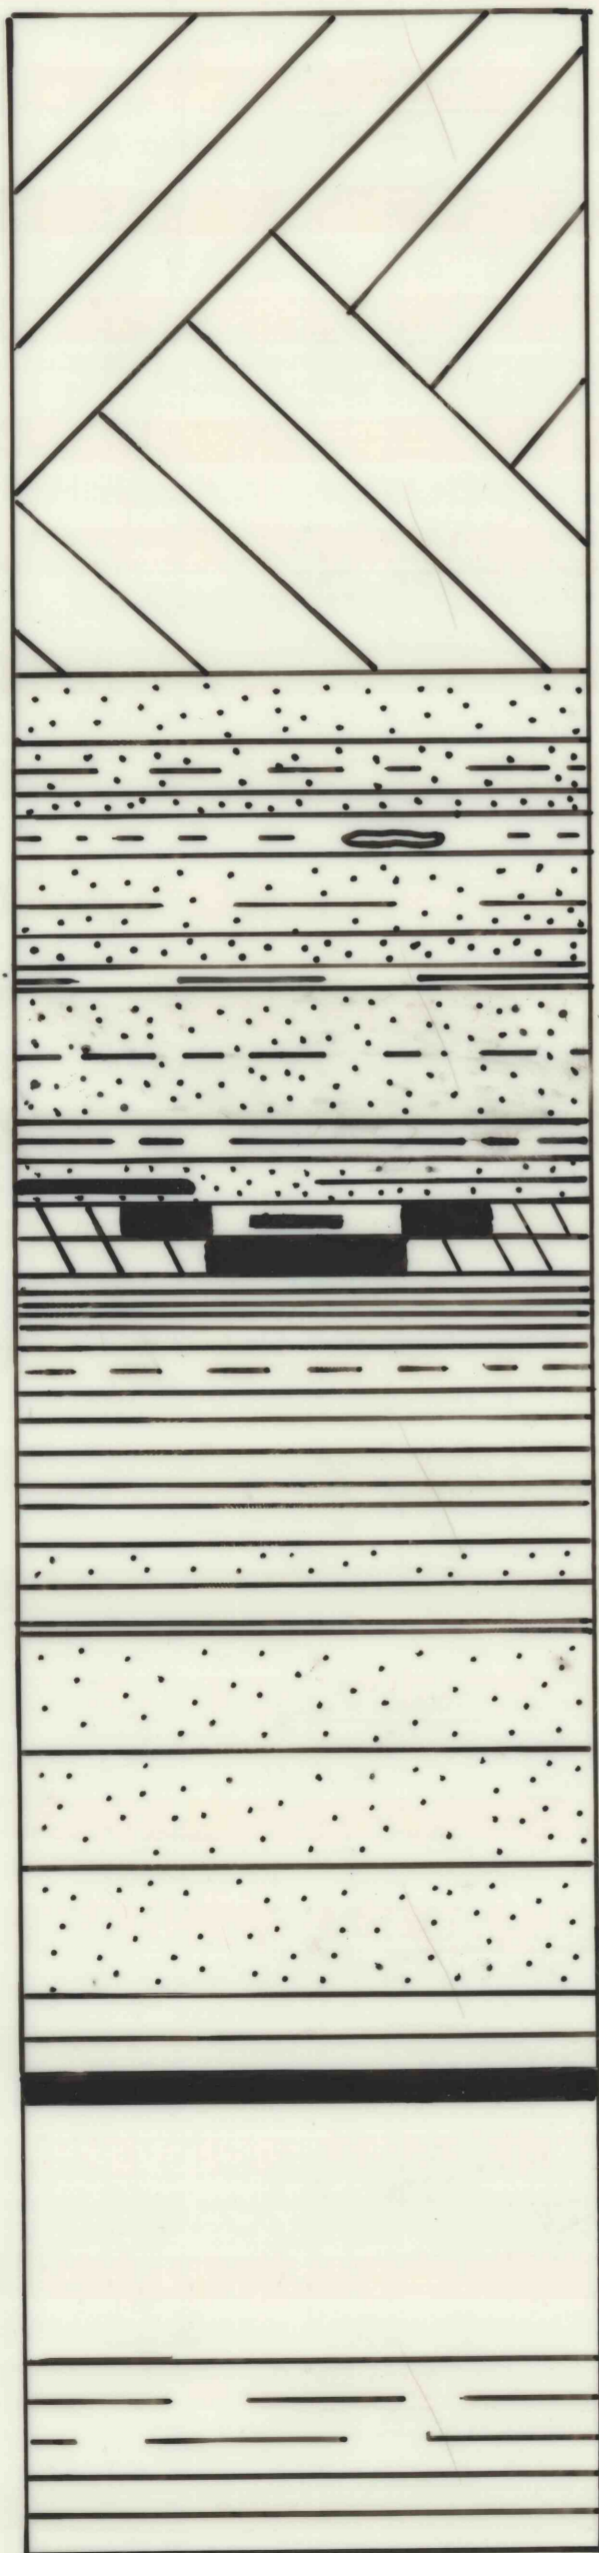

FIELD CLASSIFICATION OF MATERIALS	
OVERBURDEN	
BROKEN GRAY SANDSTONE	
BADLY BROKEN GRAY SANDSTONE	
GRAY SANDSTONE	
BADLY BR. GR. SANDSTONE/MUD SEAMS	
BROKEN GRAY SANDSTONE	
GRAY SANDSTONE	
BROKEN GRAY SANDSTONE	
BADLY BROKEN GR. SANDSTONE	
BROKEN GR. SHALE	
BROKEN SANDSTONE/SHALE/COAL	
COAL/CLAY/MUD	
COAL + CLAY	
GR. SHALE	
SHALE	BADLY BROKE GR. SHALE
SHALE	
SS/SHALE	GRAY SHALE
	GR. SHALE/SANDSTONE STRKS.
	GR. SANDSTONE
	GRAY SHALE
	COAL
	VOID
	BROKEN SHALE
	GRAY SHALE

DRILLING RUNS (ft.)		% CORE RECOV.
FROM	TO	

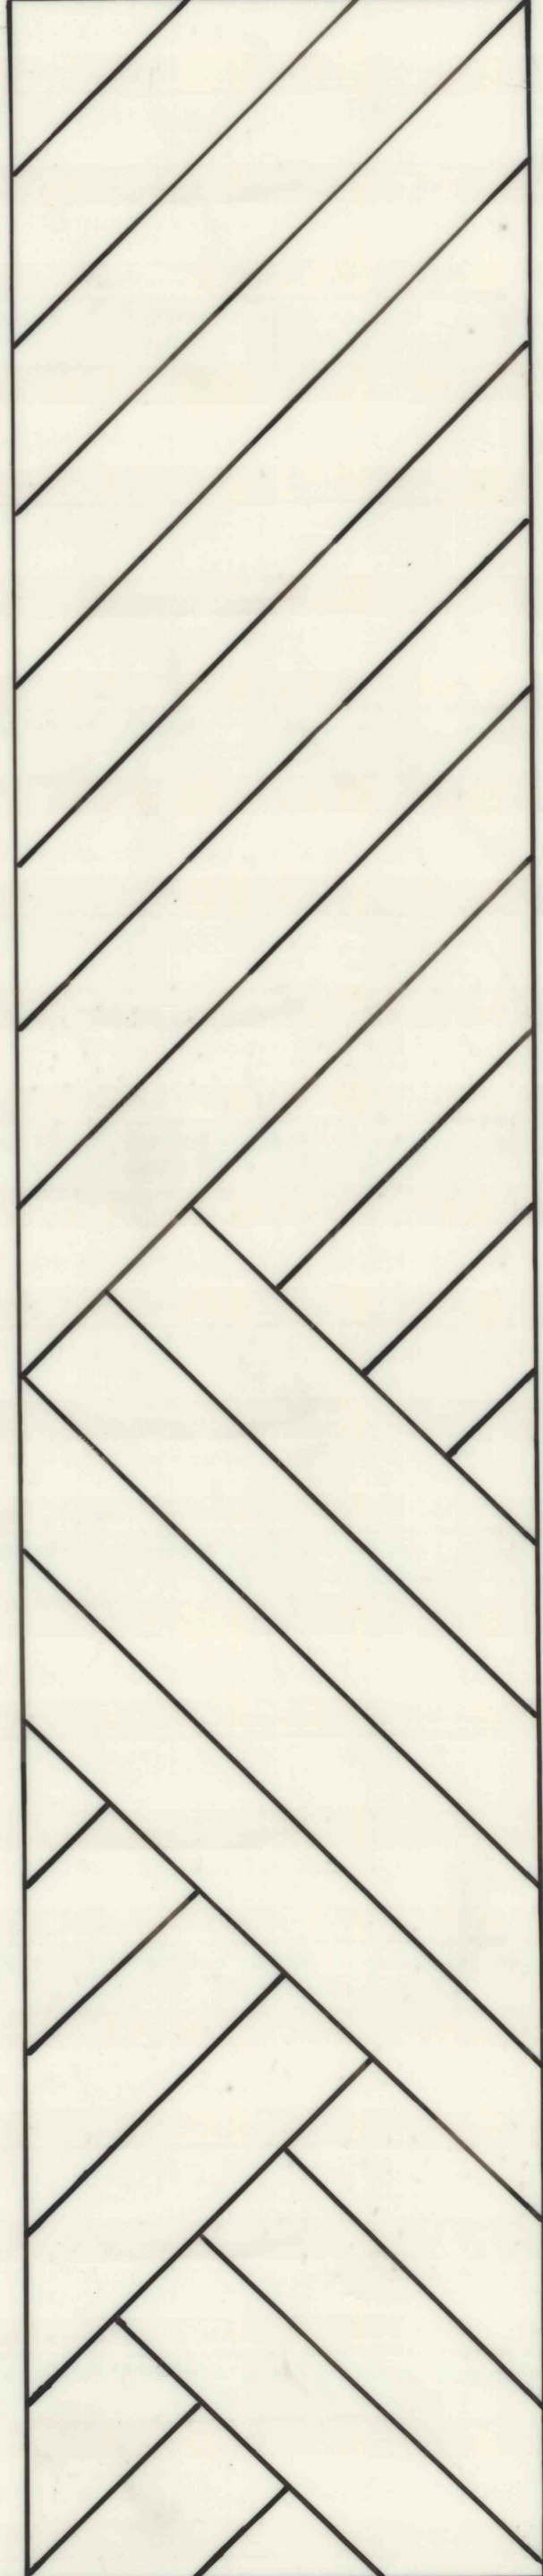

FIELD CLASSIFICATION OF MATERIALS	
OVERBURDEN	

WATER LOSS 54.2 + 106.0
 PLUG AT 44.0 PUT 10' CEMENT IN HOLE - BACKFILL
 BOTTOM OF HOLE 132.0