





DICKSON COLLIERY
NO. 1 DUNMORE BED
TO BE COLUMNIZED WITH
NO. 2 DUNMORE BED

PENNSYLVANIA

COAL

SCRANTON

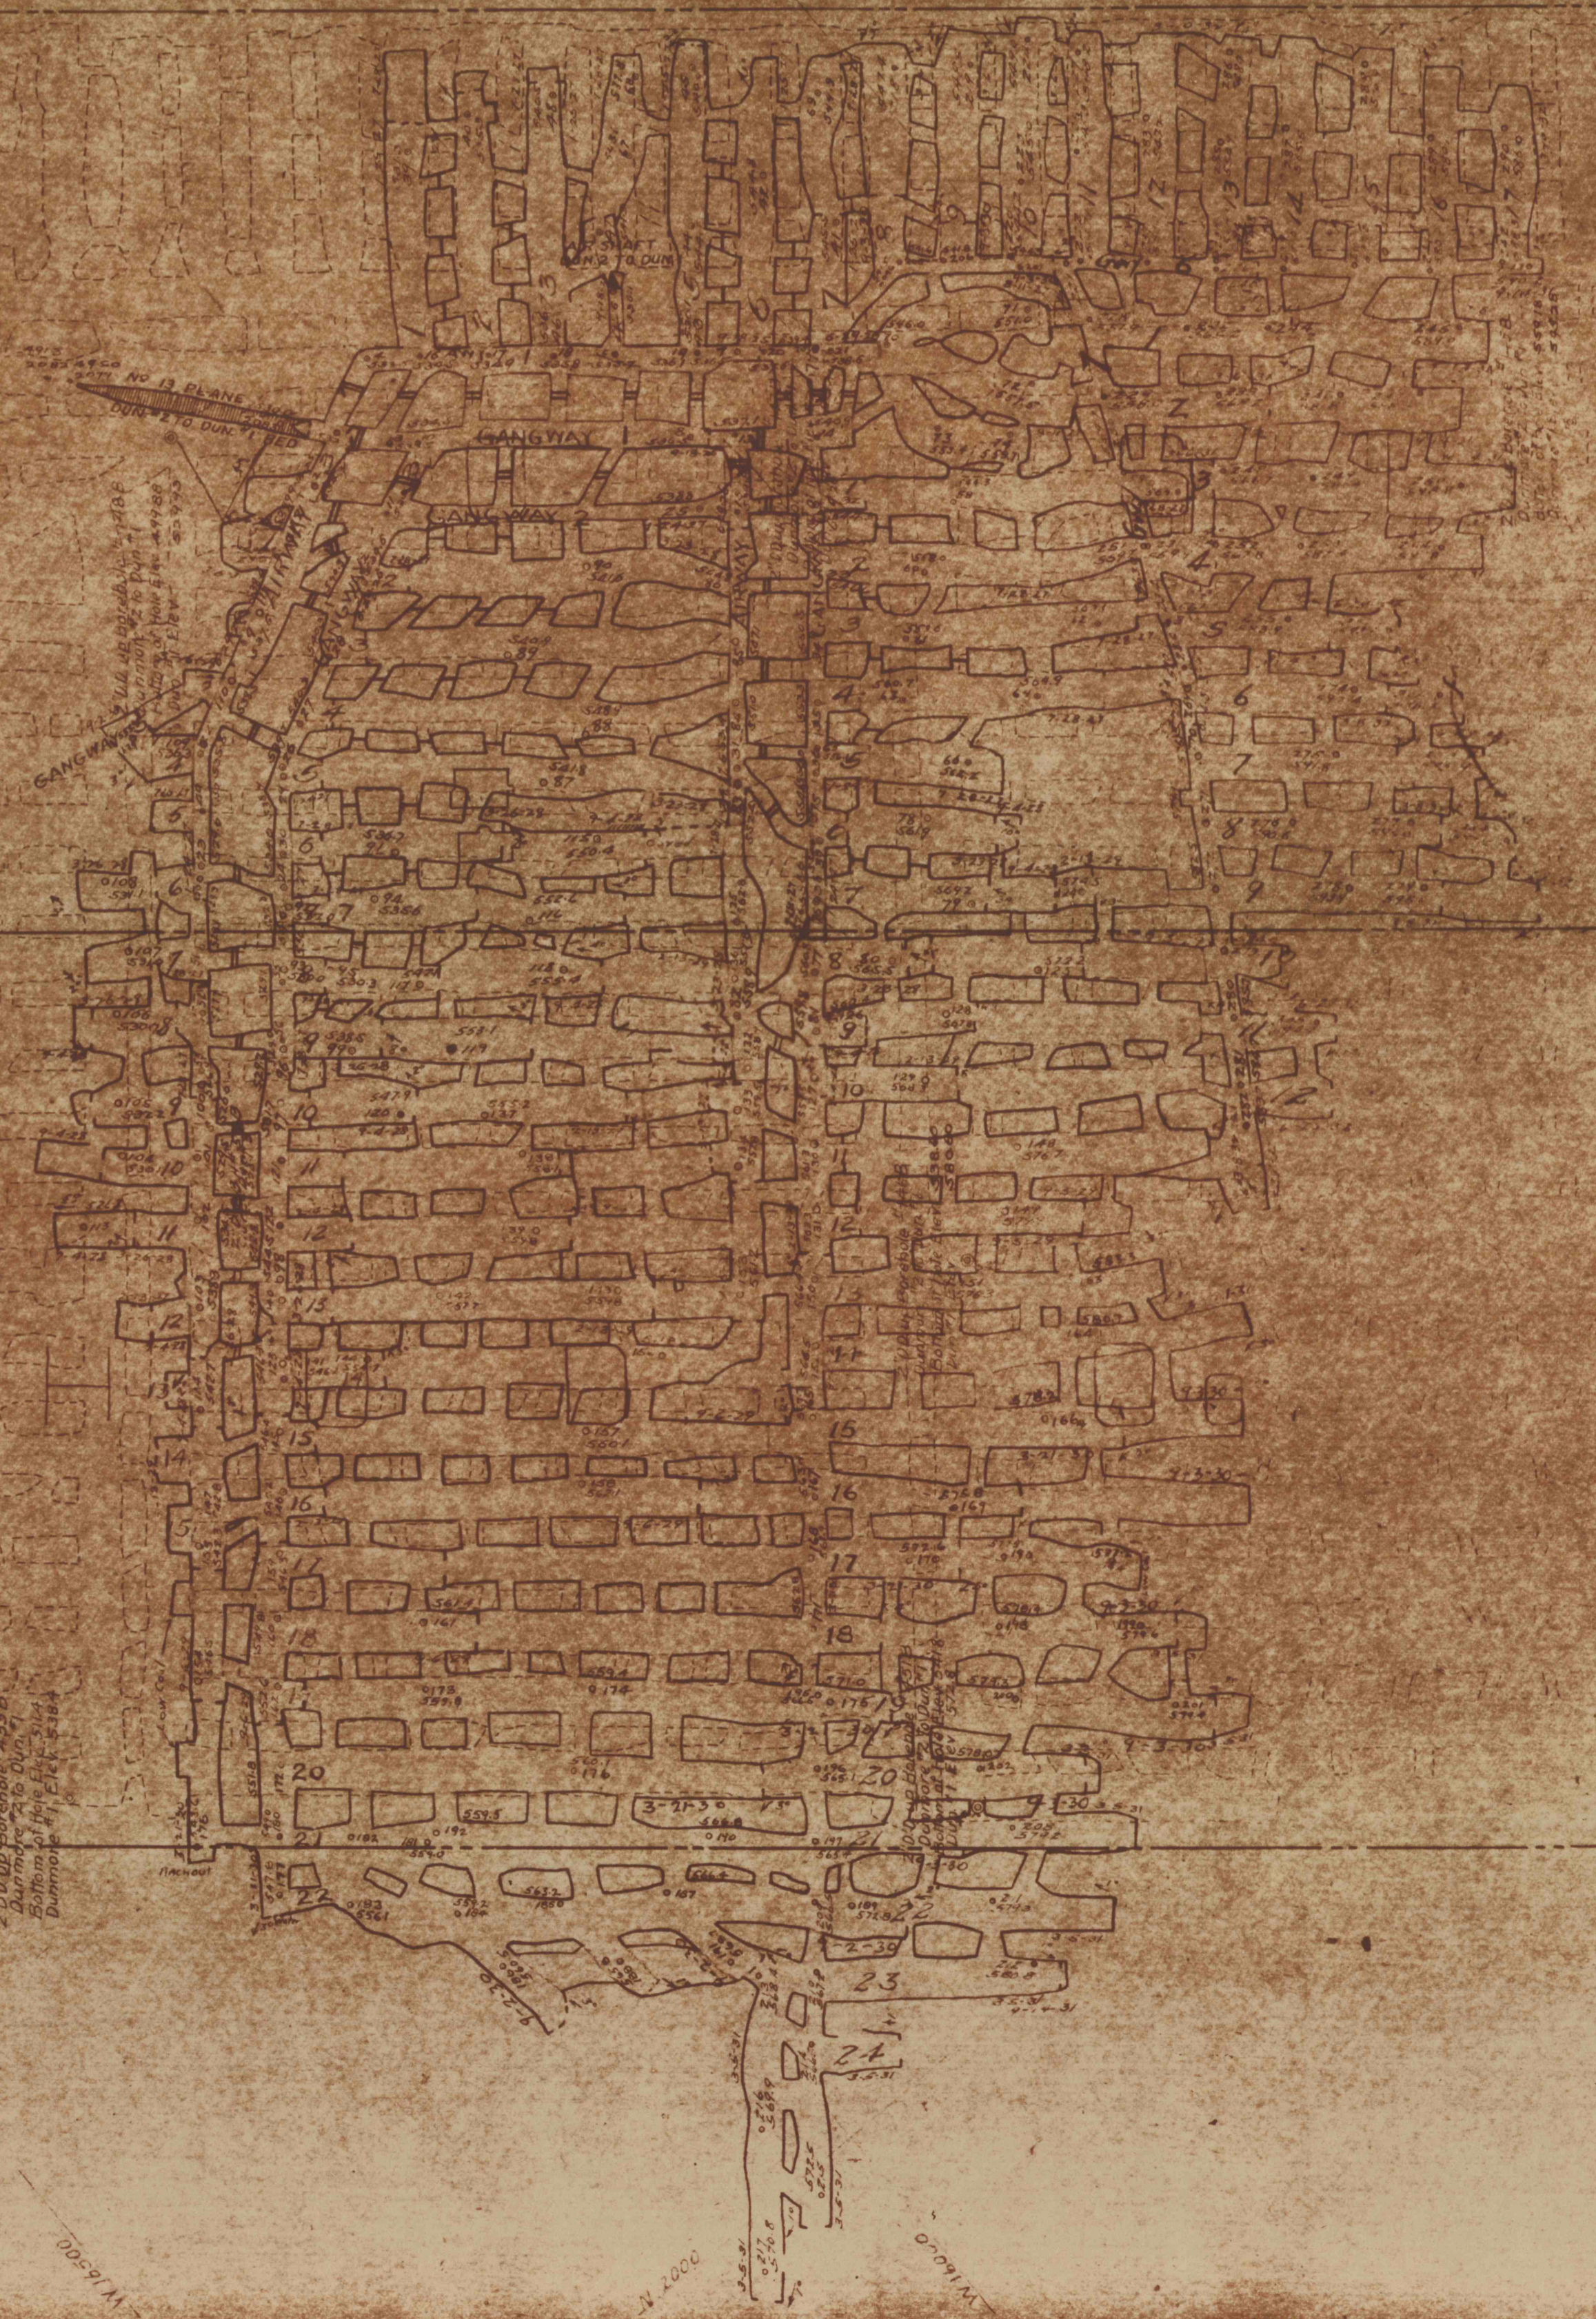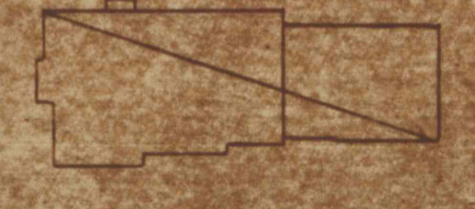

RESERVED
M. F. Williams
owns coal
conveyed by
deed dated
10/13/22

RESERVED
H. B. Fine owns
coal
conveyed by
deed dated
8/18/22

DUNMORE



No. 1 Bed
Dickson Coll.