

W.N. Sturdevant
GEO. L. BROWN

PRICE - PANCOAST COAL CO.

STEVENS
D. L. & W. FEE

PENNA. COAL CO.
JOS. HORSEFIELD

LUZERNE COAL CO.
D. L. & W. LESSEE

THE DELAWARE & HUDSON CO.

The D.&H. Co.-Penna. Coal Co. Exchange
DOLPH & PORTER
PENNA. COAL CO.

LACKAWANNA VALLEY
D.L. & W. FEE

SCRANTON COAL CO.

GILBERT DUNNING

CAYUGA & SUSQUEHANNA
D. L. & W. FEE

BOWMAN

LEVI DEPEW

PENNA. COAL CO.

JACOB BIESECKER

DANIEL SWARTZ

JACOB DEPEW

THE D. & H. CO. FEE

M. S. SIMPSON
SPENCER COAL CO.

VON STORCH
Von Storch Collieries Co.

SANDERSON

POTTER

ROBINSON
EARL GRIFFIN
Bulls Head Coal Co. Lessee

GILMORE - MEYLERT

SANDERSON

CHURCH

GRIFFIN


GILMORE - MEYLERT

WALSH

BLAIR

SCRANTON COAL CO.

GREEN RIDGE COAL CO.

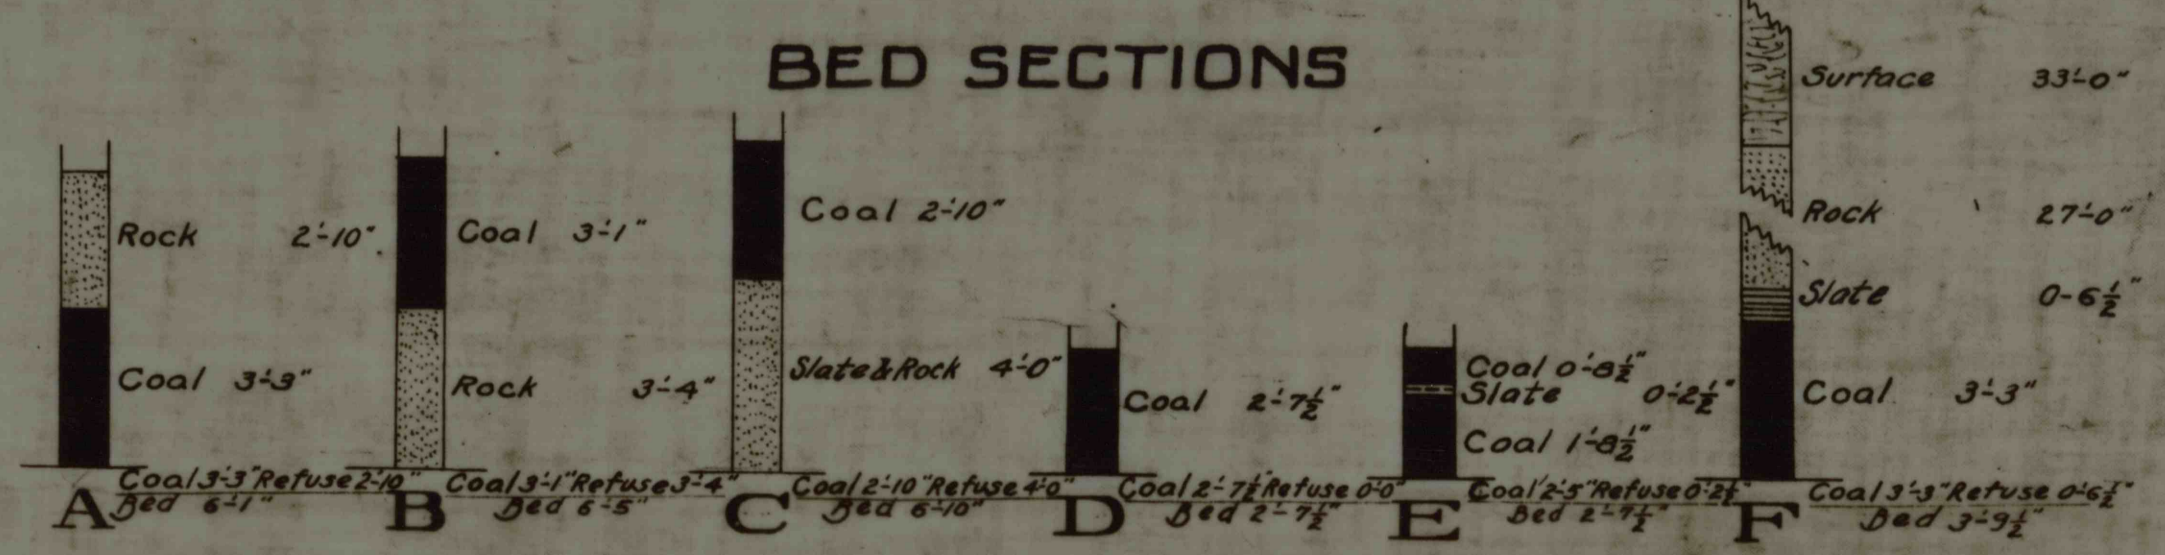

THE HUDSON COAL CO.
PROVIDENCE DIVISION
(MARVINS, DICKSON, MANVILLE, COLLIERIES)
WORKINGS IN THE
BOTTOM ROCK BED
Scale: 1"=400'

NOTE: Adjoining Workings are transferred from
Maps of various Coal Co's.

Office of
Forest Department
Scranton, Pa.

May, 1920.
Revised to Jan. 1929.