



LUZERNE COAL CO.
D.L. & W. LESSEE

LACKAWANNA VALLEY
D.L. & W. CO.

COAL CO.
3 BH # 11
3 BH # 128
3 BH # 46
3 BH # 535B
3 BH # 138
BH # 136
3 BH # 70
CAYUGA & SUSQUEHANNA
D.L. & W. FEE
3 BH # 12
6 BH # 150
6 BH # 134
Cayuga shaft

FRED VON STORCH
WEST RIDGE COAL CO.
FRED VON STORCH

ROBINSON
BULLS HEAD COAL CO. LESSEE
EARL & GRIFFIN
BULLS HEAD COAL CO. LESSEE

VON STORCH COLLIES CO.
D.L. & W. FEE
WILLARD PARKER
VON STORCH COLLIES CO.
Lessee

D.L. & W. R.R.
FEE
D.L. & W. FEE
WINTON

STEVENS
D.L. & W. FEE

WILLARD PARKER

WILLARD PARKER

THE DELAWARE & HUDSON Co.
















PENNA. COAL CO.

















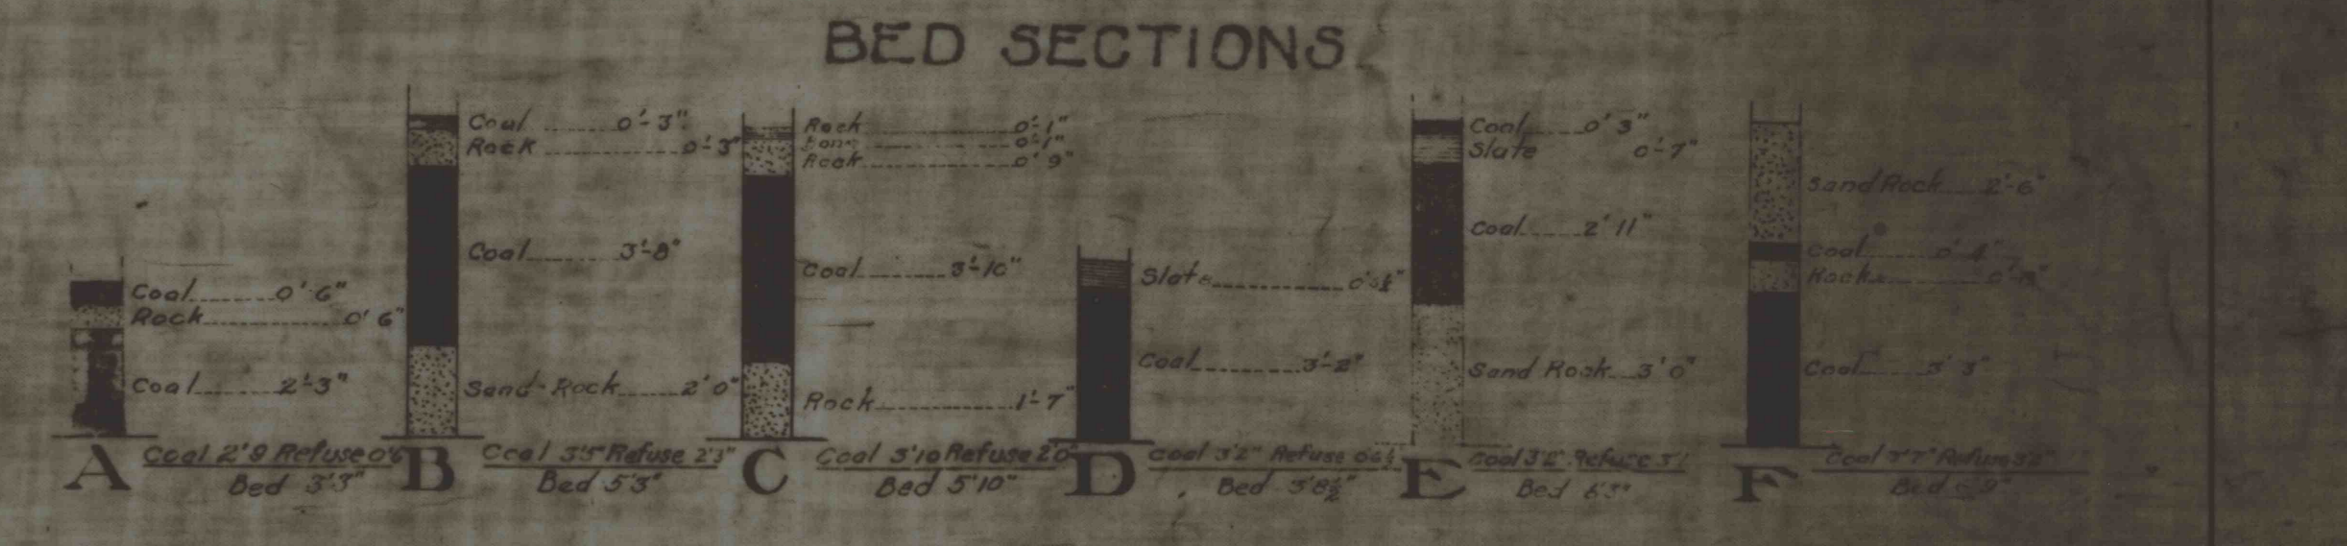

THE HUDSON COAL CO.
PROVIDENCE DIVISION
WORKINGS IN THE
NO. 4 DUNMORE BED
Scale: 1" = 40'
Office of
Geologist
Scranton, Pa.
May 1920
Revised Oct. 1, 1921

NOTE: Adjoining workings are transferred from
Maps of various Coal Co's.