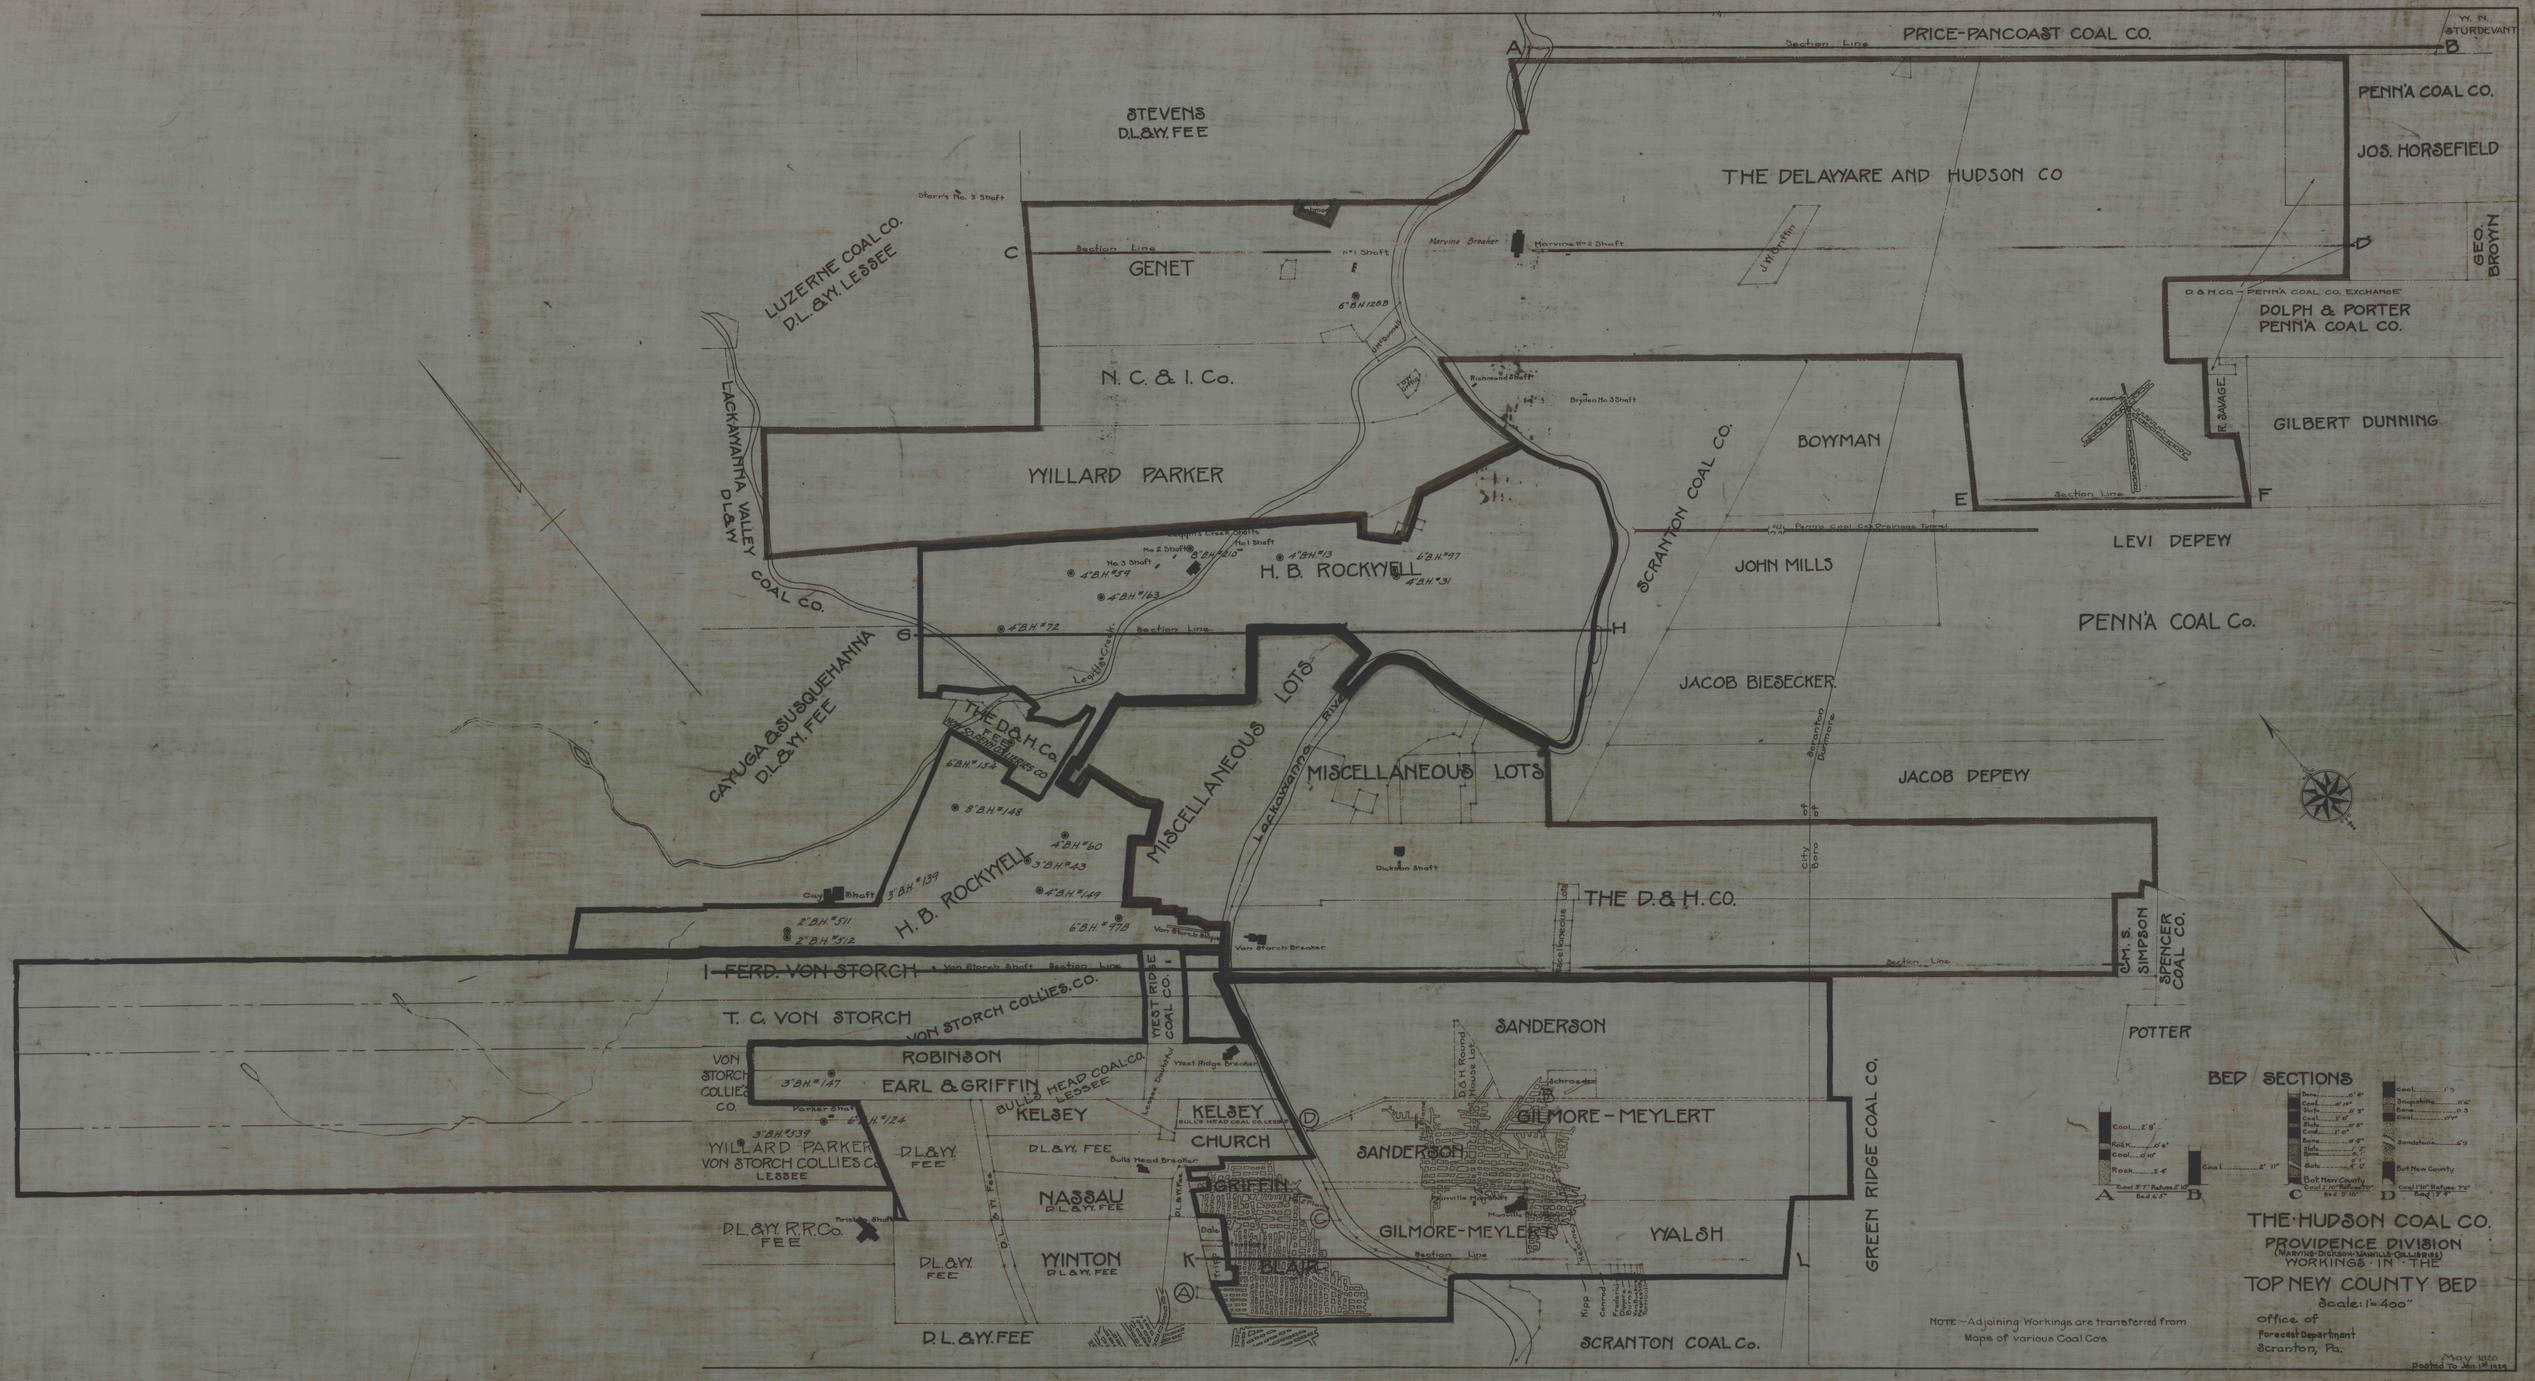
W. R. STURDEVANT
PRICE-PANCOAST COAL CO.
Section Line
A
B
PENN'A COAL CO.
JOS. HORSEFIELD
GEO. BROWN
STEVENS
D.L.&W. FEE
THE DELAWARE AND HUDSON CO
Starr's No. 3 Shaft
LUZERNE COAL CO.
D.L.&W. LESSEE
C
Section Line
GENET
No. 1 Shaft
Marvine Breaker
Marvine No. 2 Shaft
J. W. Martin
D & H CO. – PENN'A COAL CO. EXCHANGE
DOLPH & PORTER
PENN'A COAL CO.
D
N. C. & I. Co.
Richmond Shaft
Boyden No. 3 Shaft
R. SAVAGE
GILBERT DUNNING
LACKAWANNA VALLEY COAL CO.
D.L.&W.
WILLARD PARKER
BOYMAN
SCRANTON COAL CO.
E
F
Section Line
LEVI DEPEW
JOHN MILLS
Penna Coal Co's Drainage Tunnel
H. B. ROCKWELL
PENN'A COAL Co.
G
H
Section Line
JACOB BIESECKER
CAYUGA & SUSQUEHANNA
D.L.&W. FEE
THE D. & H. Co.
F.F.B.
MISCELLANEOUS LOTS
Lackawanna River
MISCELLANEOUS LOTS
Scranton Dumore
JACOB DEPEW
Dickson Shaft
City Boro
H. B. ROCKWELL
Cay Shaft
THE D. & H. CO.
Von Storch Shaft
Section Line
Von Storch Breaker
Excelsior Colliery
C. M. S. SIMPSON SPENCER COAL CO.
1 – FERD. VON STORCH
T. C. VON STORCH
VON STORCH COLLIES. CO.
WEST RIDGE COAL CO.
POTTER
SANDERSON
ROBINSON
EARL & GRIFFIN
BULL'S HEAD COAL CO. LESSEE
West Ridge Breaker
D & H Round House Lot
Schroeder
KELSEY
KELSEY
BULL'S HEAD COAL CO. LESSEE
GILMORE-MEYLERT
CHURCH
SANDERSON
D.L.&W. FEE
Bulls Head Breaker
WILLARD PARKER
VON STORCH COLLIES CO.
LESSEE
D.L.&W. FEE
GRIFFIN
NASSAU
D.L.&W. FEE
D.L.&W. R.R. Co.
FEE
WINTON
D.L.&W. FEE
BLAKE
GILMORE-MEYLERT
WALSH
GREEN RIDGE COAL CO.
D.L.&W. FEE
SCRANTON COAL Co.
BED SECTIONS
THE HUDSON COAL CO.
PROVIDENCE DIVISION
(MARVINE-DICKSON-WAVERLY COLLIERIES)
WORKINGS IN THE
TOP NEW COUNTY BED
Scale: 1" = 400'
Office of
Forecast Department
Scranton, Pa.
May 1920
Posted To Jan 1st 1924
NOTE – Adjoining Workings are transferred from Maps of various Coal Co's