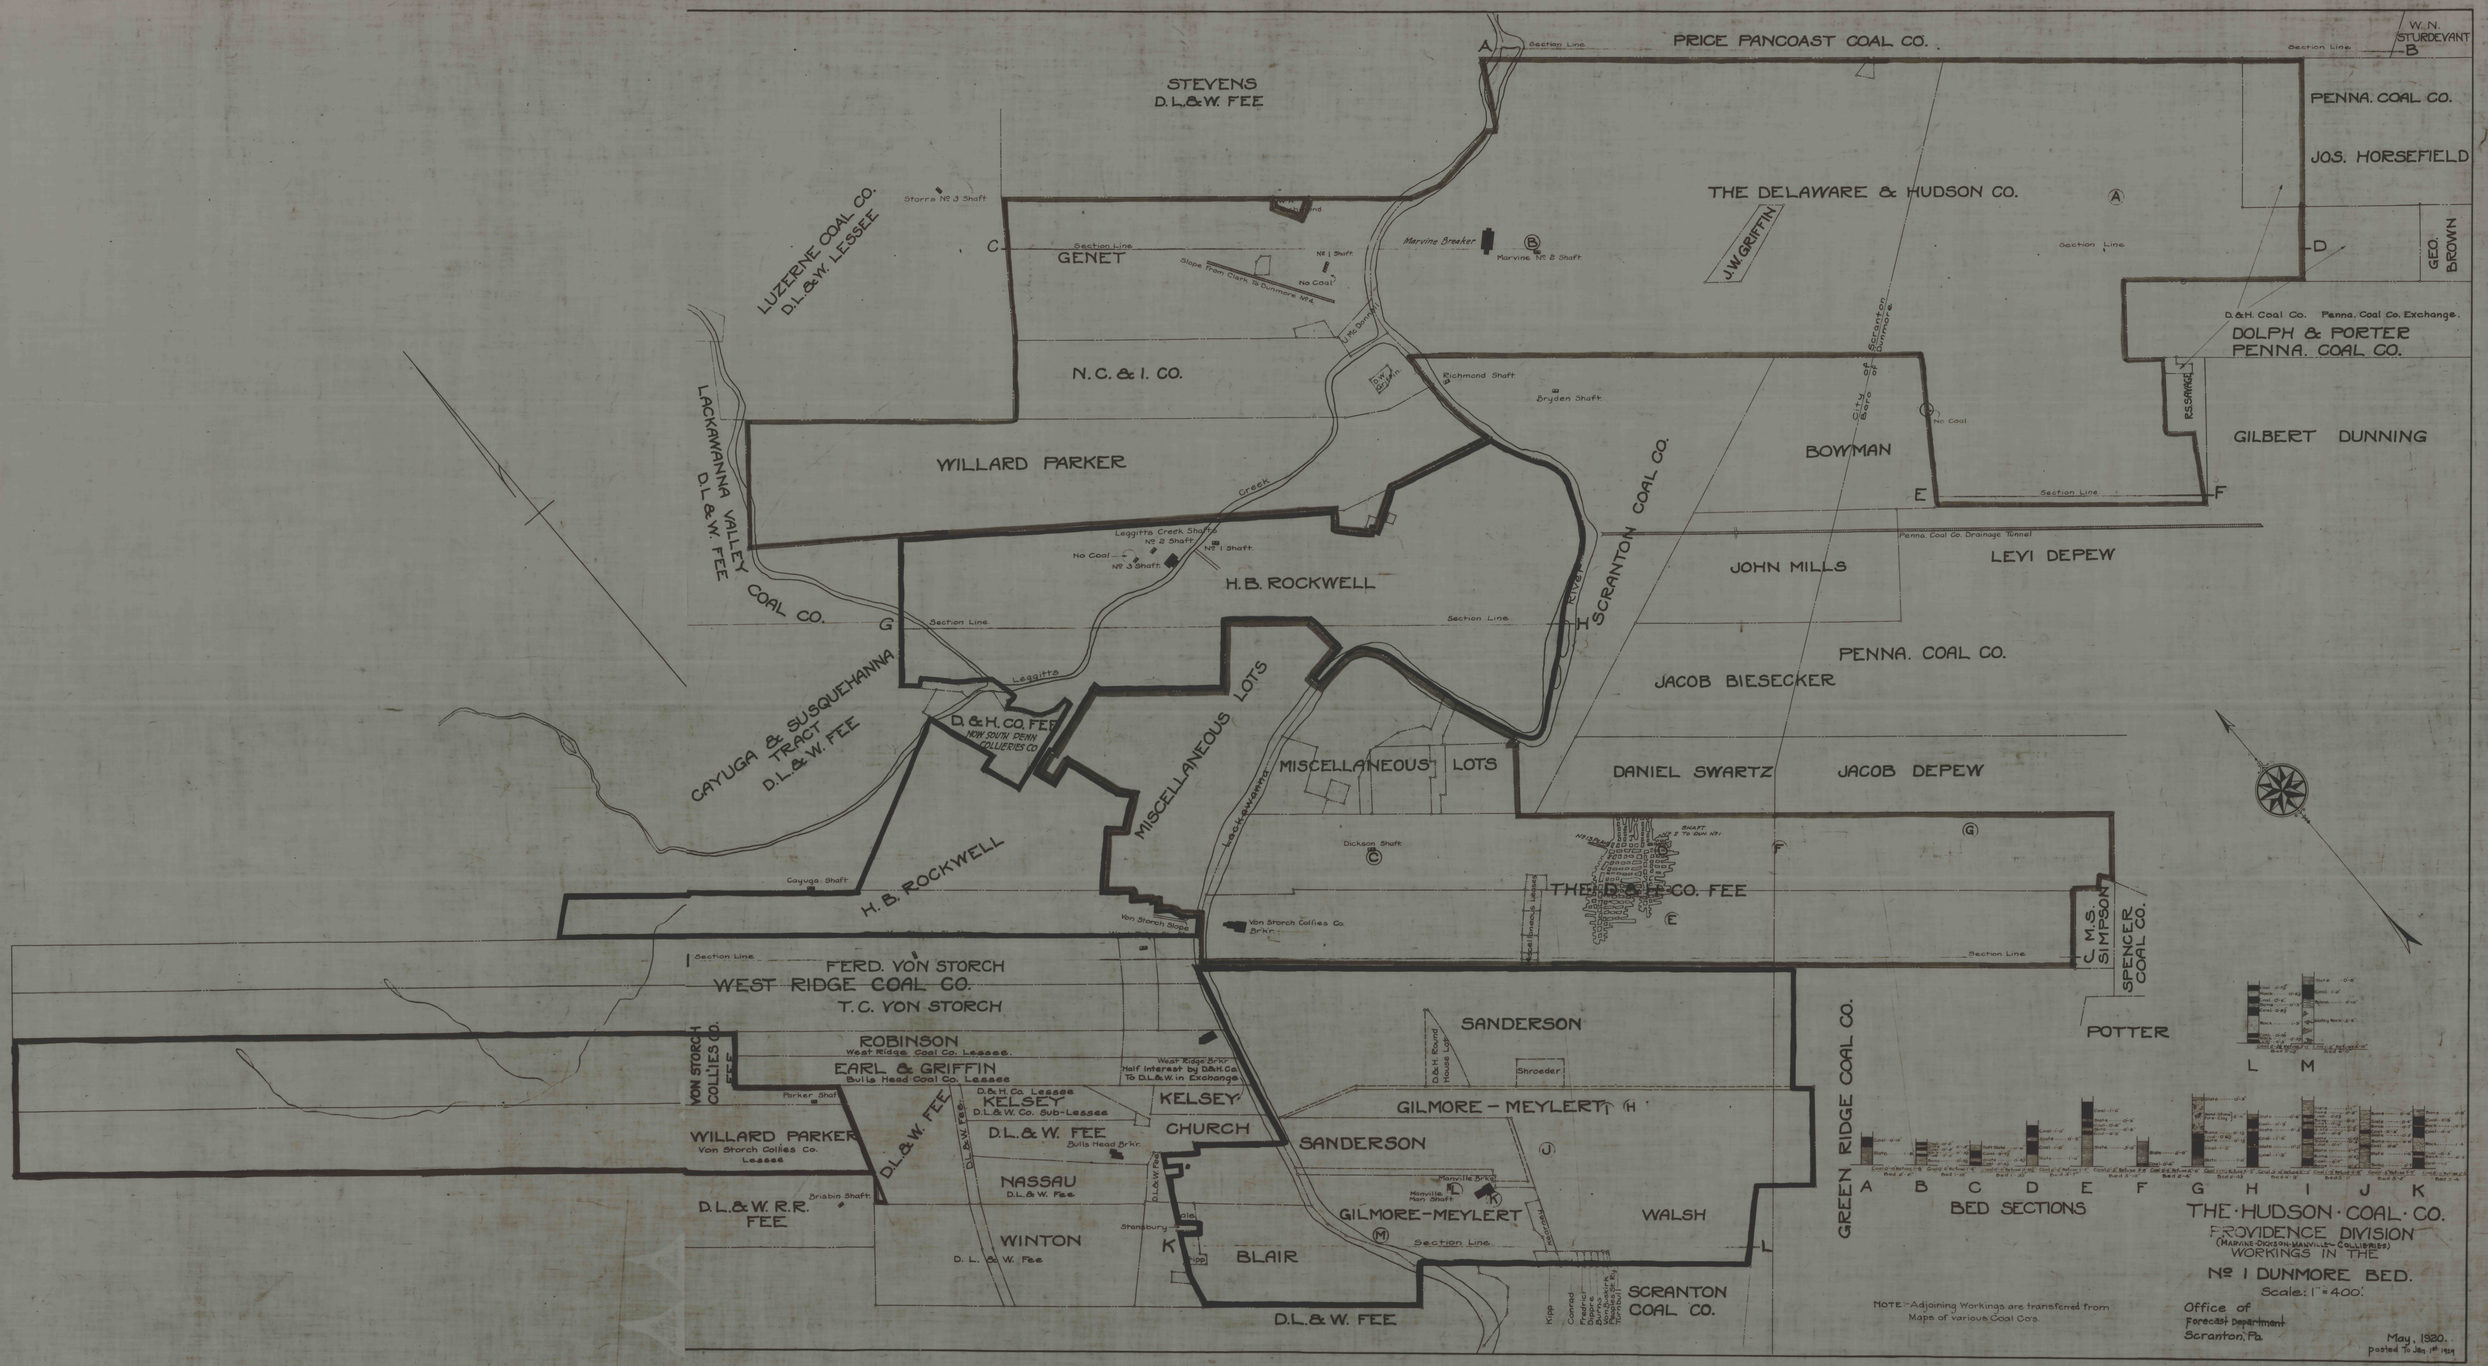
PRICE PANCOAST COAL CO.
W. N. STURDEVANT
STEVENS D.L.&W. FEE
PENNA. COAL CO.
JOS. HORSEFIELD
THE DELAWARE & HUDSON CO.
GEO. BROWN
D.&H. Coal Co. Penna. Coal Co. Exchange.
DOLPH & PORTER PENNA. COAL CO.
GILBERT DUNNING
LUZERNE COAL CO. D.L.&W. LESSEE
GENET
N.C. & I. CO.
WILLARD PARKER
LACKAWANNA VALLEY D.L.&W. FEE COAL CO.
H.B. ROCKWELL
BOWMAN
JOHN MILLS
LEVI DEPEW
PENNA. COAL CO.
JACOB BIESECKER
SCRANTON COAL CO.
CAYUGA & SUSQUEHANNA TRACT D.L.&W. FEE
D. & H. CO. FEE NOW SOUTH PENN COLLIERIES CO
MISCELLANEOUS LOTS
DANIEL SWARTZ
JACOB DEPEW
THE D. & H. CO. FEE
C.M.S. SIMPSON
SPENCER COAL CO.
POTTER
FERD. VON STORCH
WEST RIDGE COAL CO.
T.C. VON STORCH
VON STORCH COLLIES CO. FEE
ROBINSON West Ridge Coal Co. Lessee.
EARL & GRIFFIN Bulls Head Coal Co. Lessee
KELSEY D.L.&W. Co. Sub-Lessee
D.L.&W. FEE Bulls Head Brkr.
CHURCH
SANDERSON
GILMORE - MEYLERT
WILLARD PARKER Von Storch Collies Co. Lessee
NASSAU D.L.&W. Fee
WINTON D.L.&W. Fee
BLAIR
GILMORE-MEYLERT
WALSH
SCRANTON COAL CO.
D.L.&W. FEE
D.L.&W. R.R. FEE
GREEN RIDGE COAL CO.
A B C D E F G H I J K
BED SECTIONS
THE · HUDSON · COAL · CO.
PROVIDENCE DIVISION
(MARINE-DICKSON-MANVILLE-COLLIERIES)
WORKINGS IN THE
No 1 DUNMORE BED.
Scale: 1" = 400'
NOTE-Adjoining Workings are transferred from Maps of various Coal Co's.
Office of Forecast Department
Scranton, Pa.
May, 1920.
Posted To Jan 1st 1924