


DIAMOND COLLY. No 1 DUNMORE BED

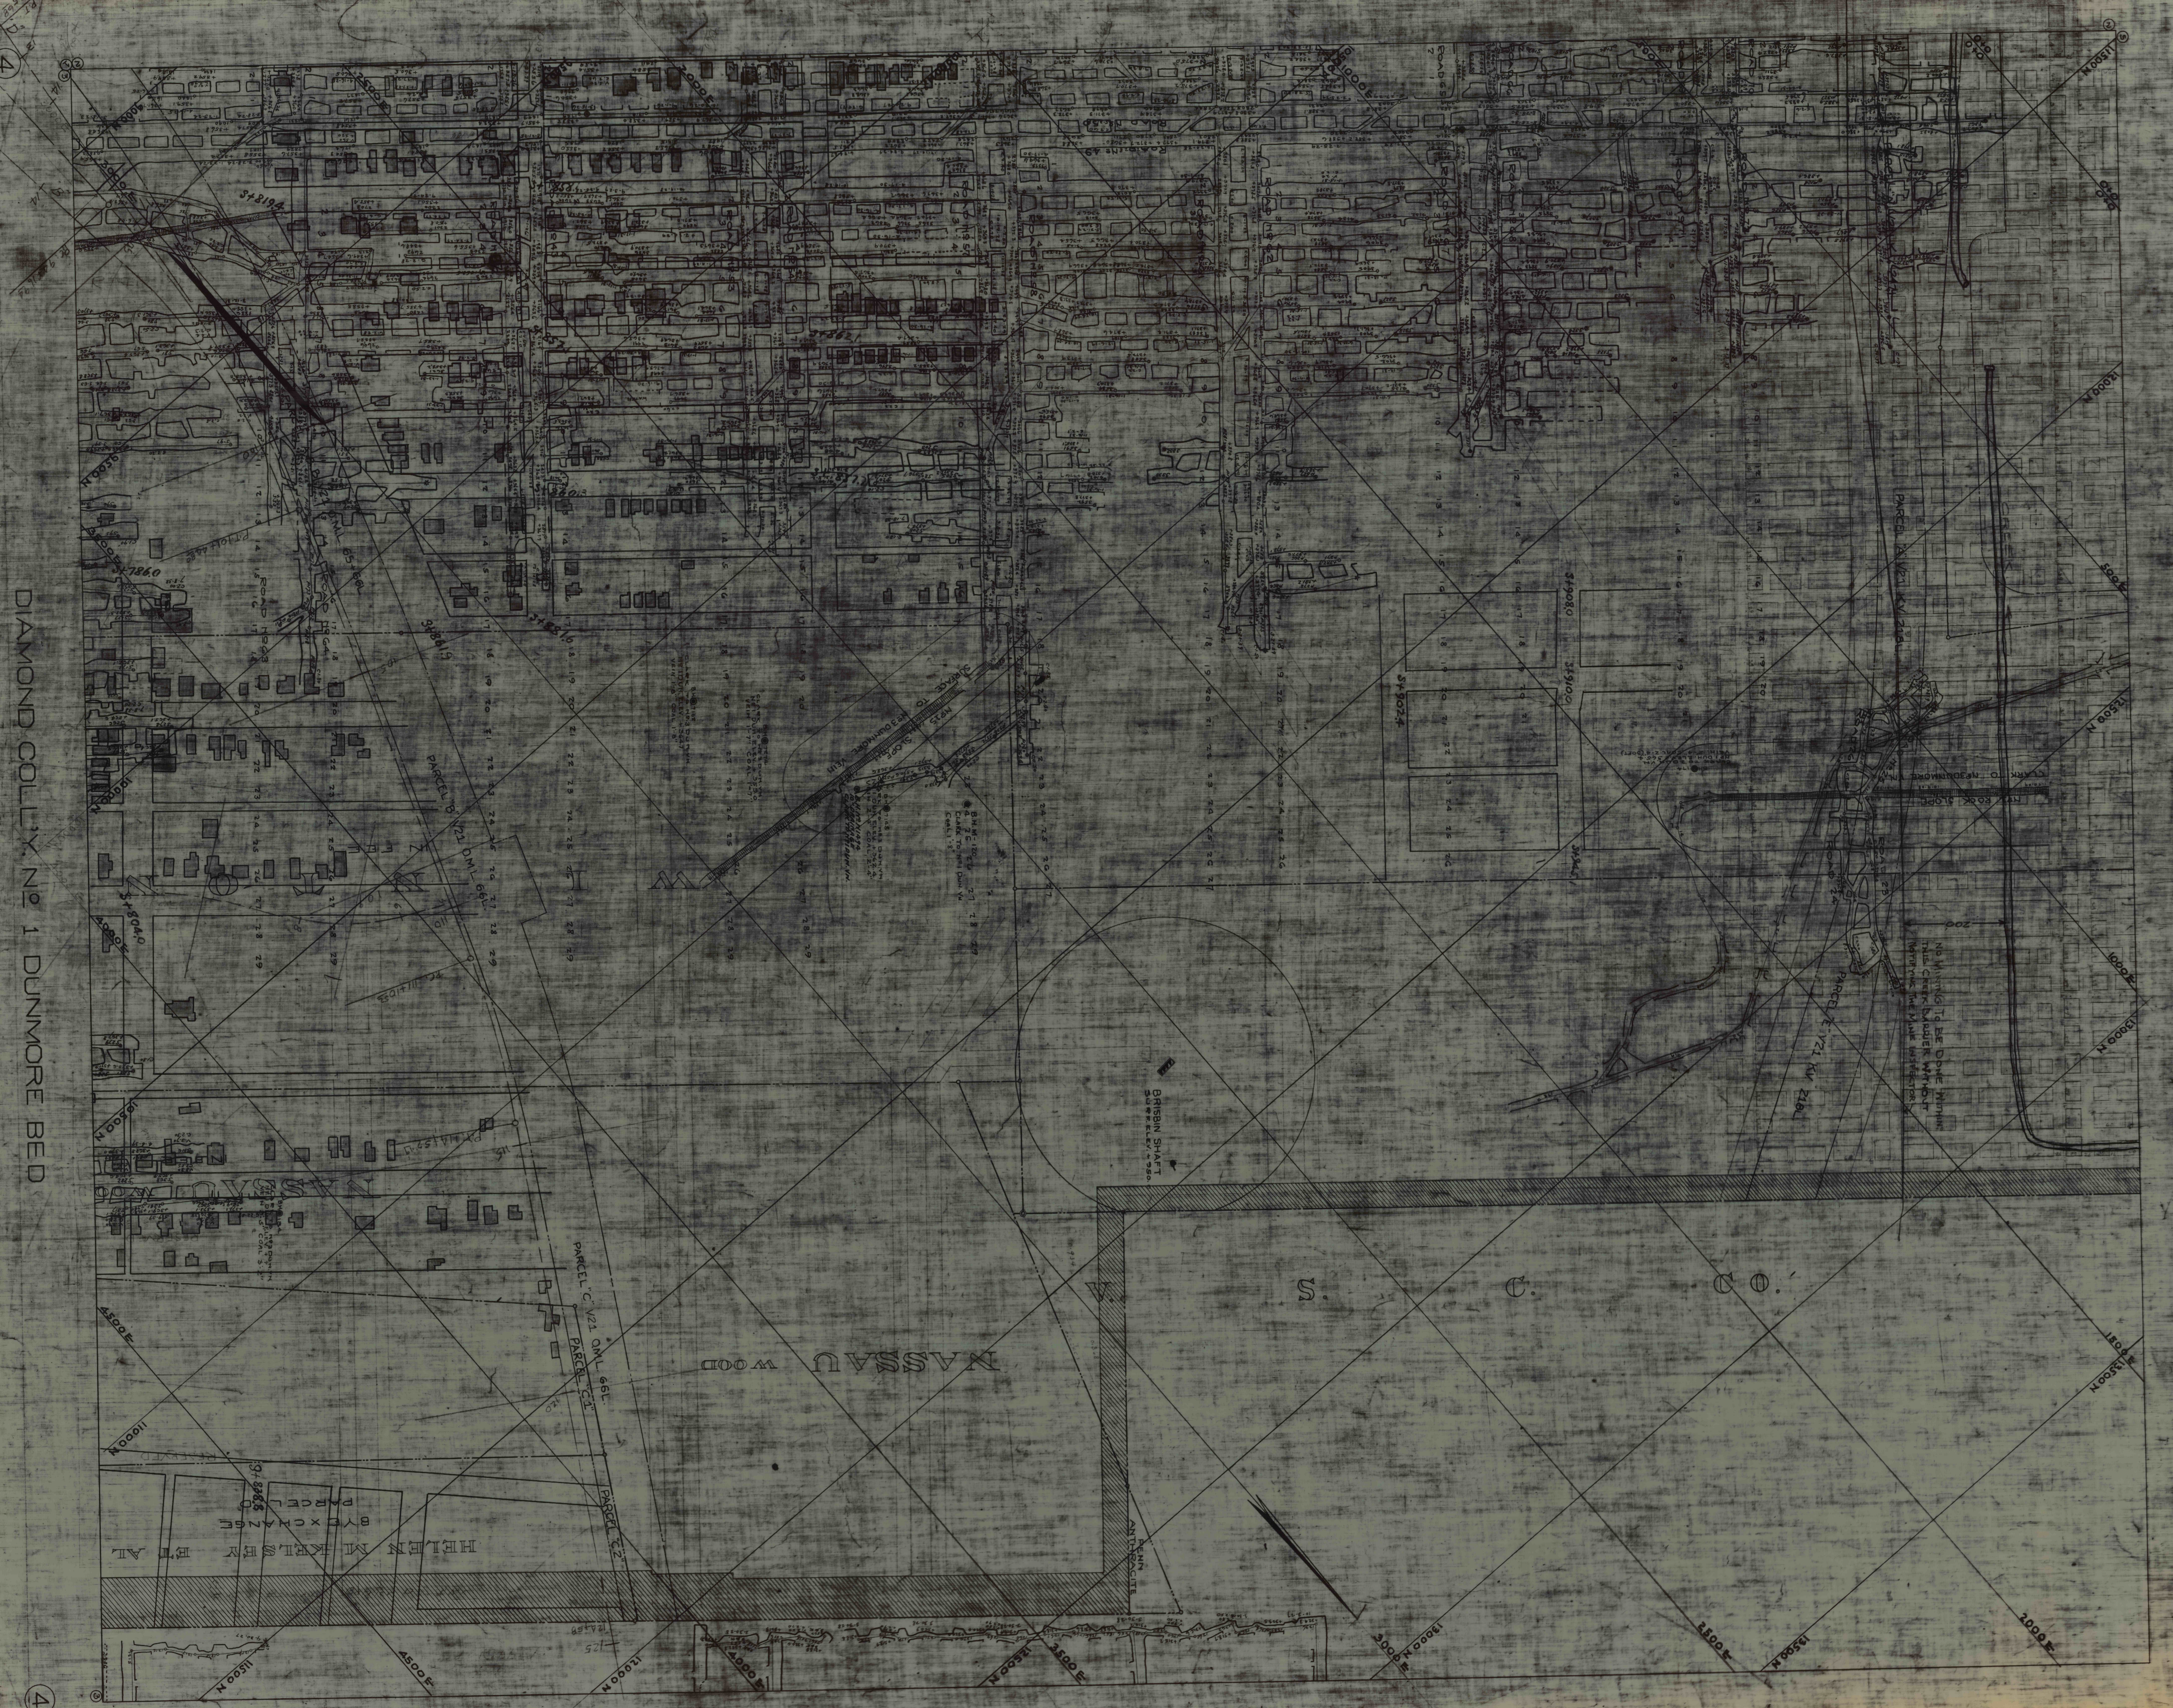

NASSAU WOOD

BRISBIN SHAFT

ANTHRAHITE

HELEN M. KELSER ET AL


PARCEL D

PARCEL C V21 O.M.L. 661.

PARCEL C2

PARCEL B V21 O.M.L. 661.

PARCEL B V21 O.M.L. 661.

PARCEL A

NO MINING TO BE DONE IN THIS AREA UNLESS THE ABOVE MENTIONED WORKING IS FIRST COMPLETED






