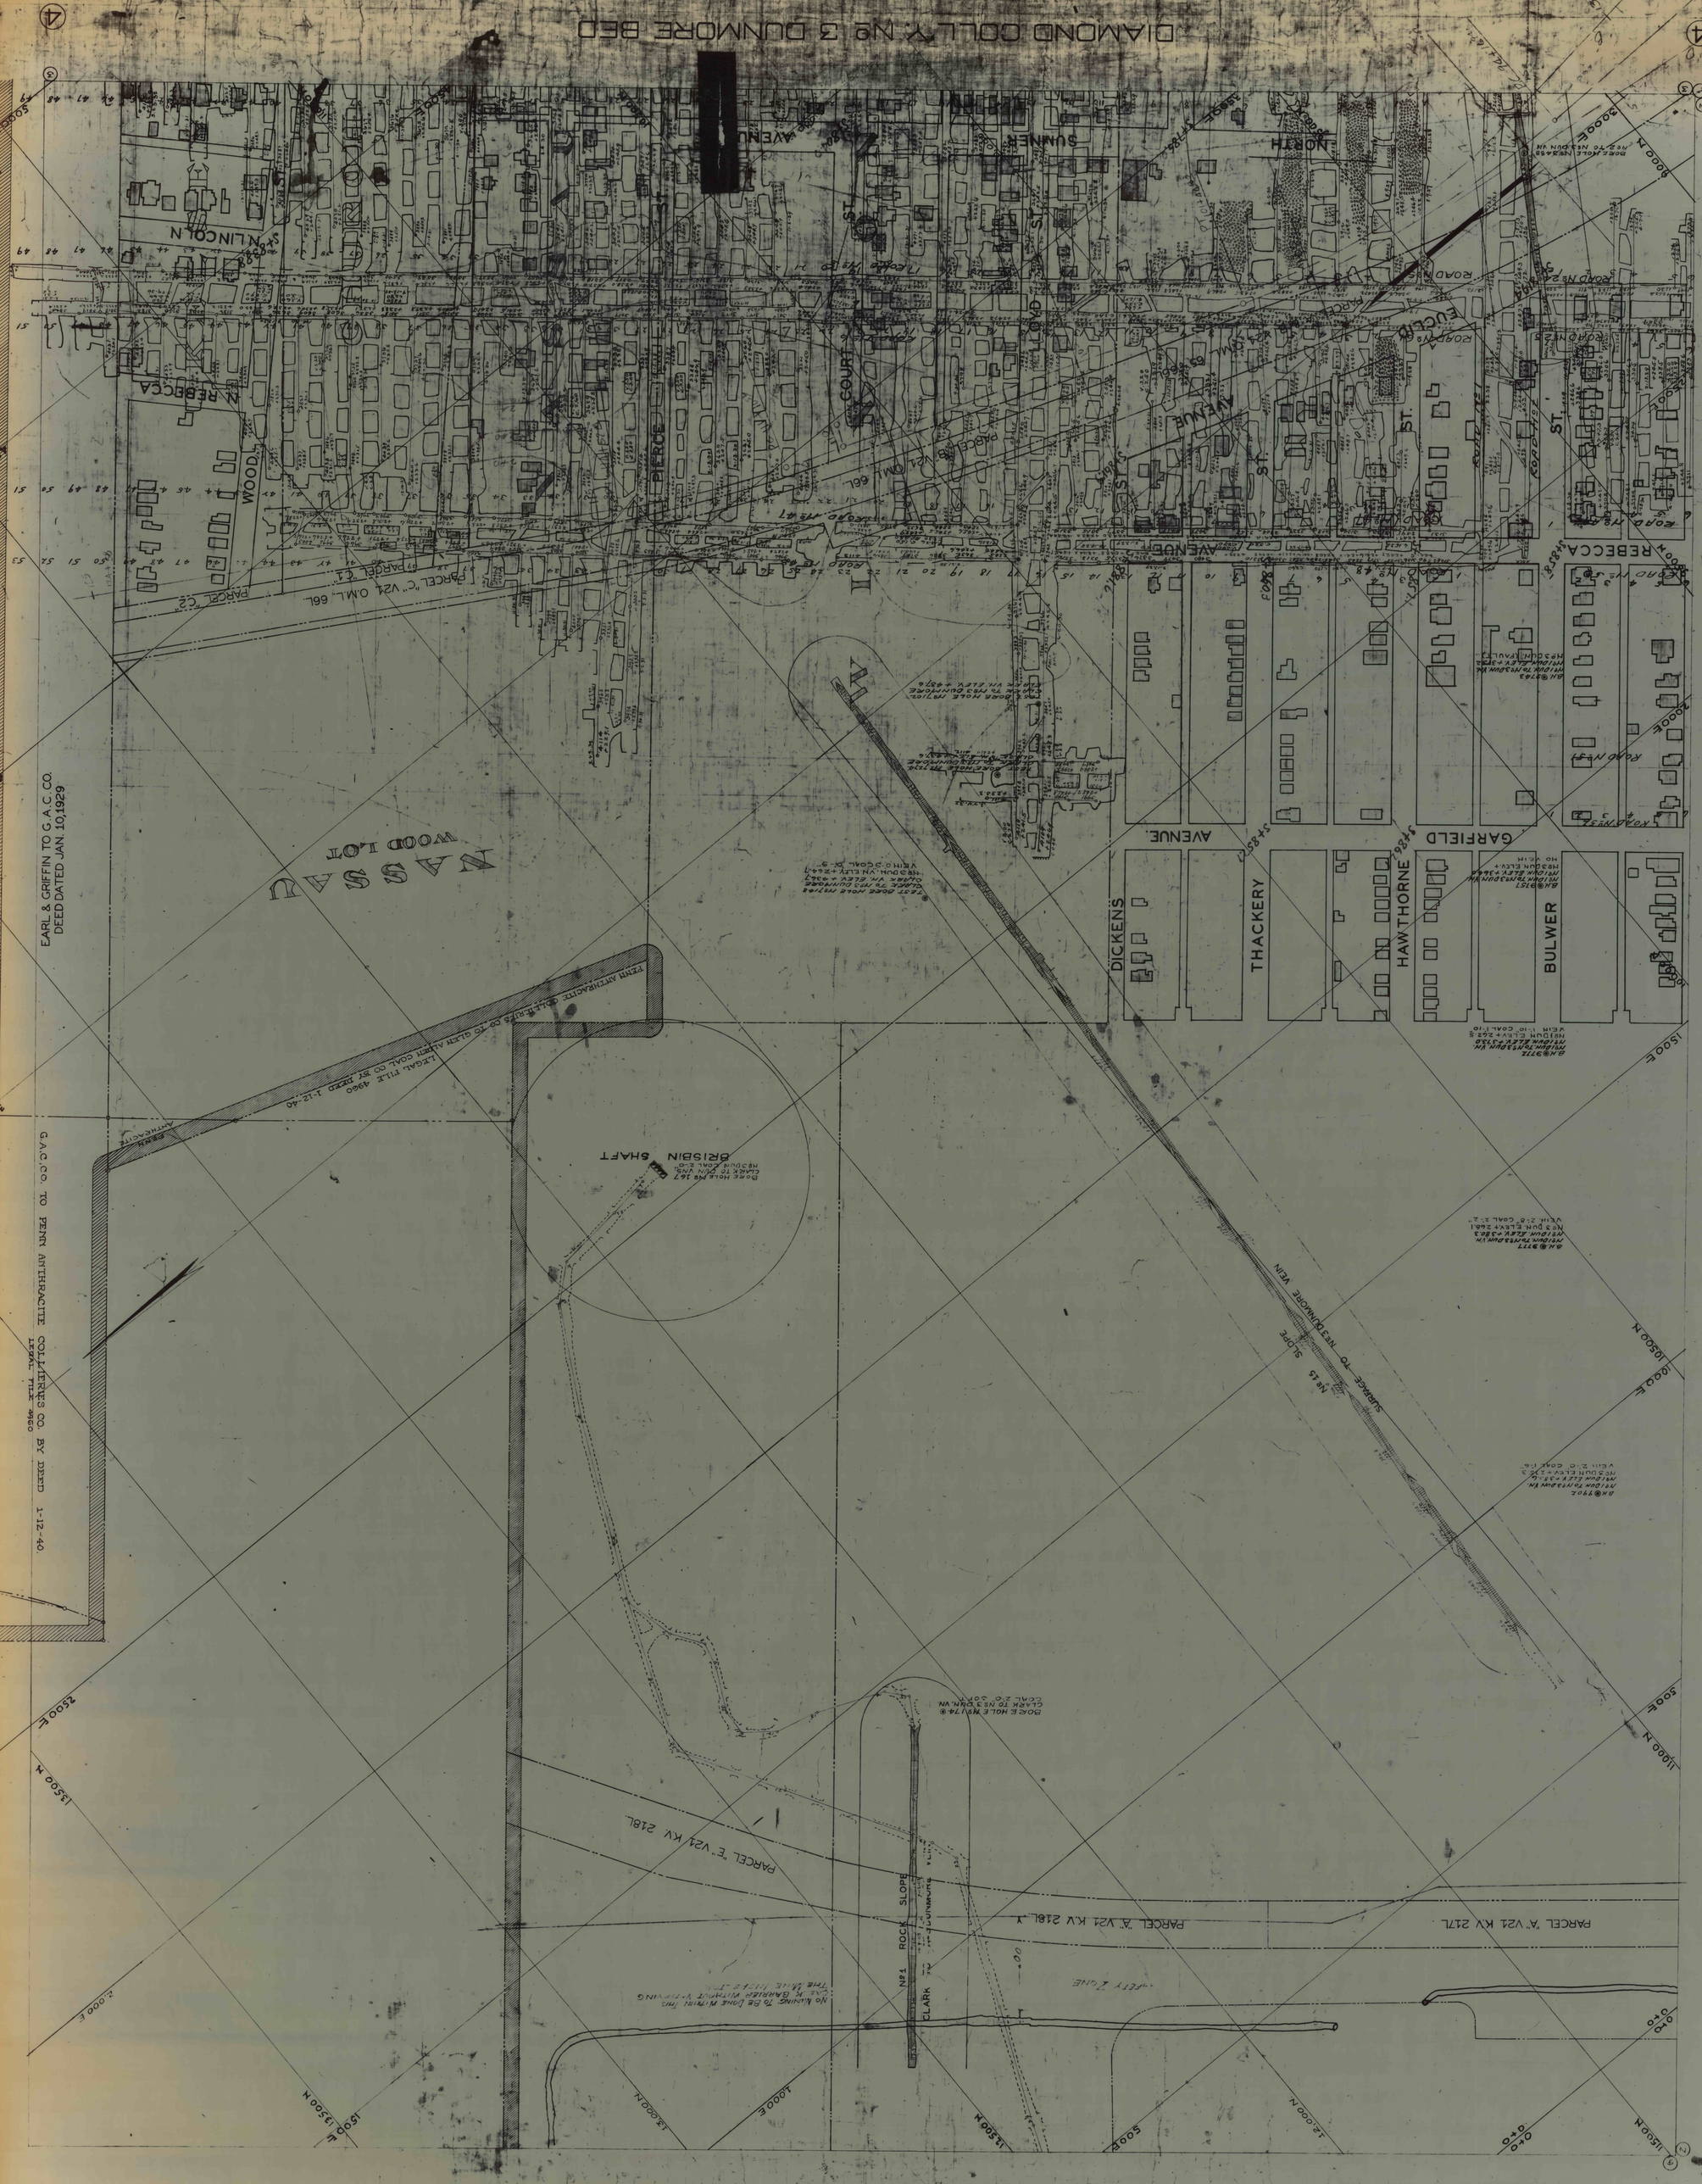
DIAMOND COLLY No 3 DUNMORE BED
EARL & GRIFFIN TO G.A.C.CO.
DEED DATED JAN. 10,1929
NASSAU
WOOD LOT
PARCEL "C" V24 O.M.L. 66L
PARCEL "C2"
PARCEL "A" V24 K.V 218L
PARCEL "E" V24 K.V 218L
PARCEL "A" V24 K.V 217L
SAFETY ZONE
No MINING TO BE DONE WITHIN THIS
SAFETY ZONE WITHOUT WRITTEN
CONSENT OF THE GENERAL MANAGER
OF THE LIFE TIME
CLARK TO NO 3 DUN. VN
CLARK TO PRO COMPRESSOR
CLARK TO DIN VNE
BRISBIN SHAFT
SURFACE TO No 3 DUNMORE VEIN
No 45 SLOPE
No 1 ROCK SLOPE
CLARK
DICKENS
THACKERY
HAWTHORNE
BULWER
GARFIELD
AVENUE
PIERCE
COURT
LINCOLN
REBECCA
WOOD
EUCLID
NORTH
SUMNER
ROAD No 2
ROAD No 3
ROAD No