


14000 N
13500 N
13000 N
12500 N
12000 N
11500 N
11000 N
10500 N
10000 N
9500 N
9000 N
8500 N
8000 N
7500 N
7000 N
6500 N
6000 N
5500 N
5000 N
4500 N
4000 N
3500 N
3000 N
2500 N
2000 N
1500 N
1000 N
500 N
0

SCRANTON

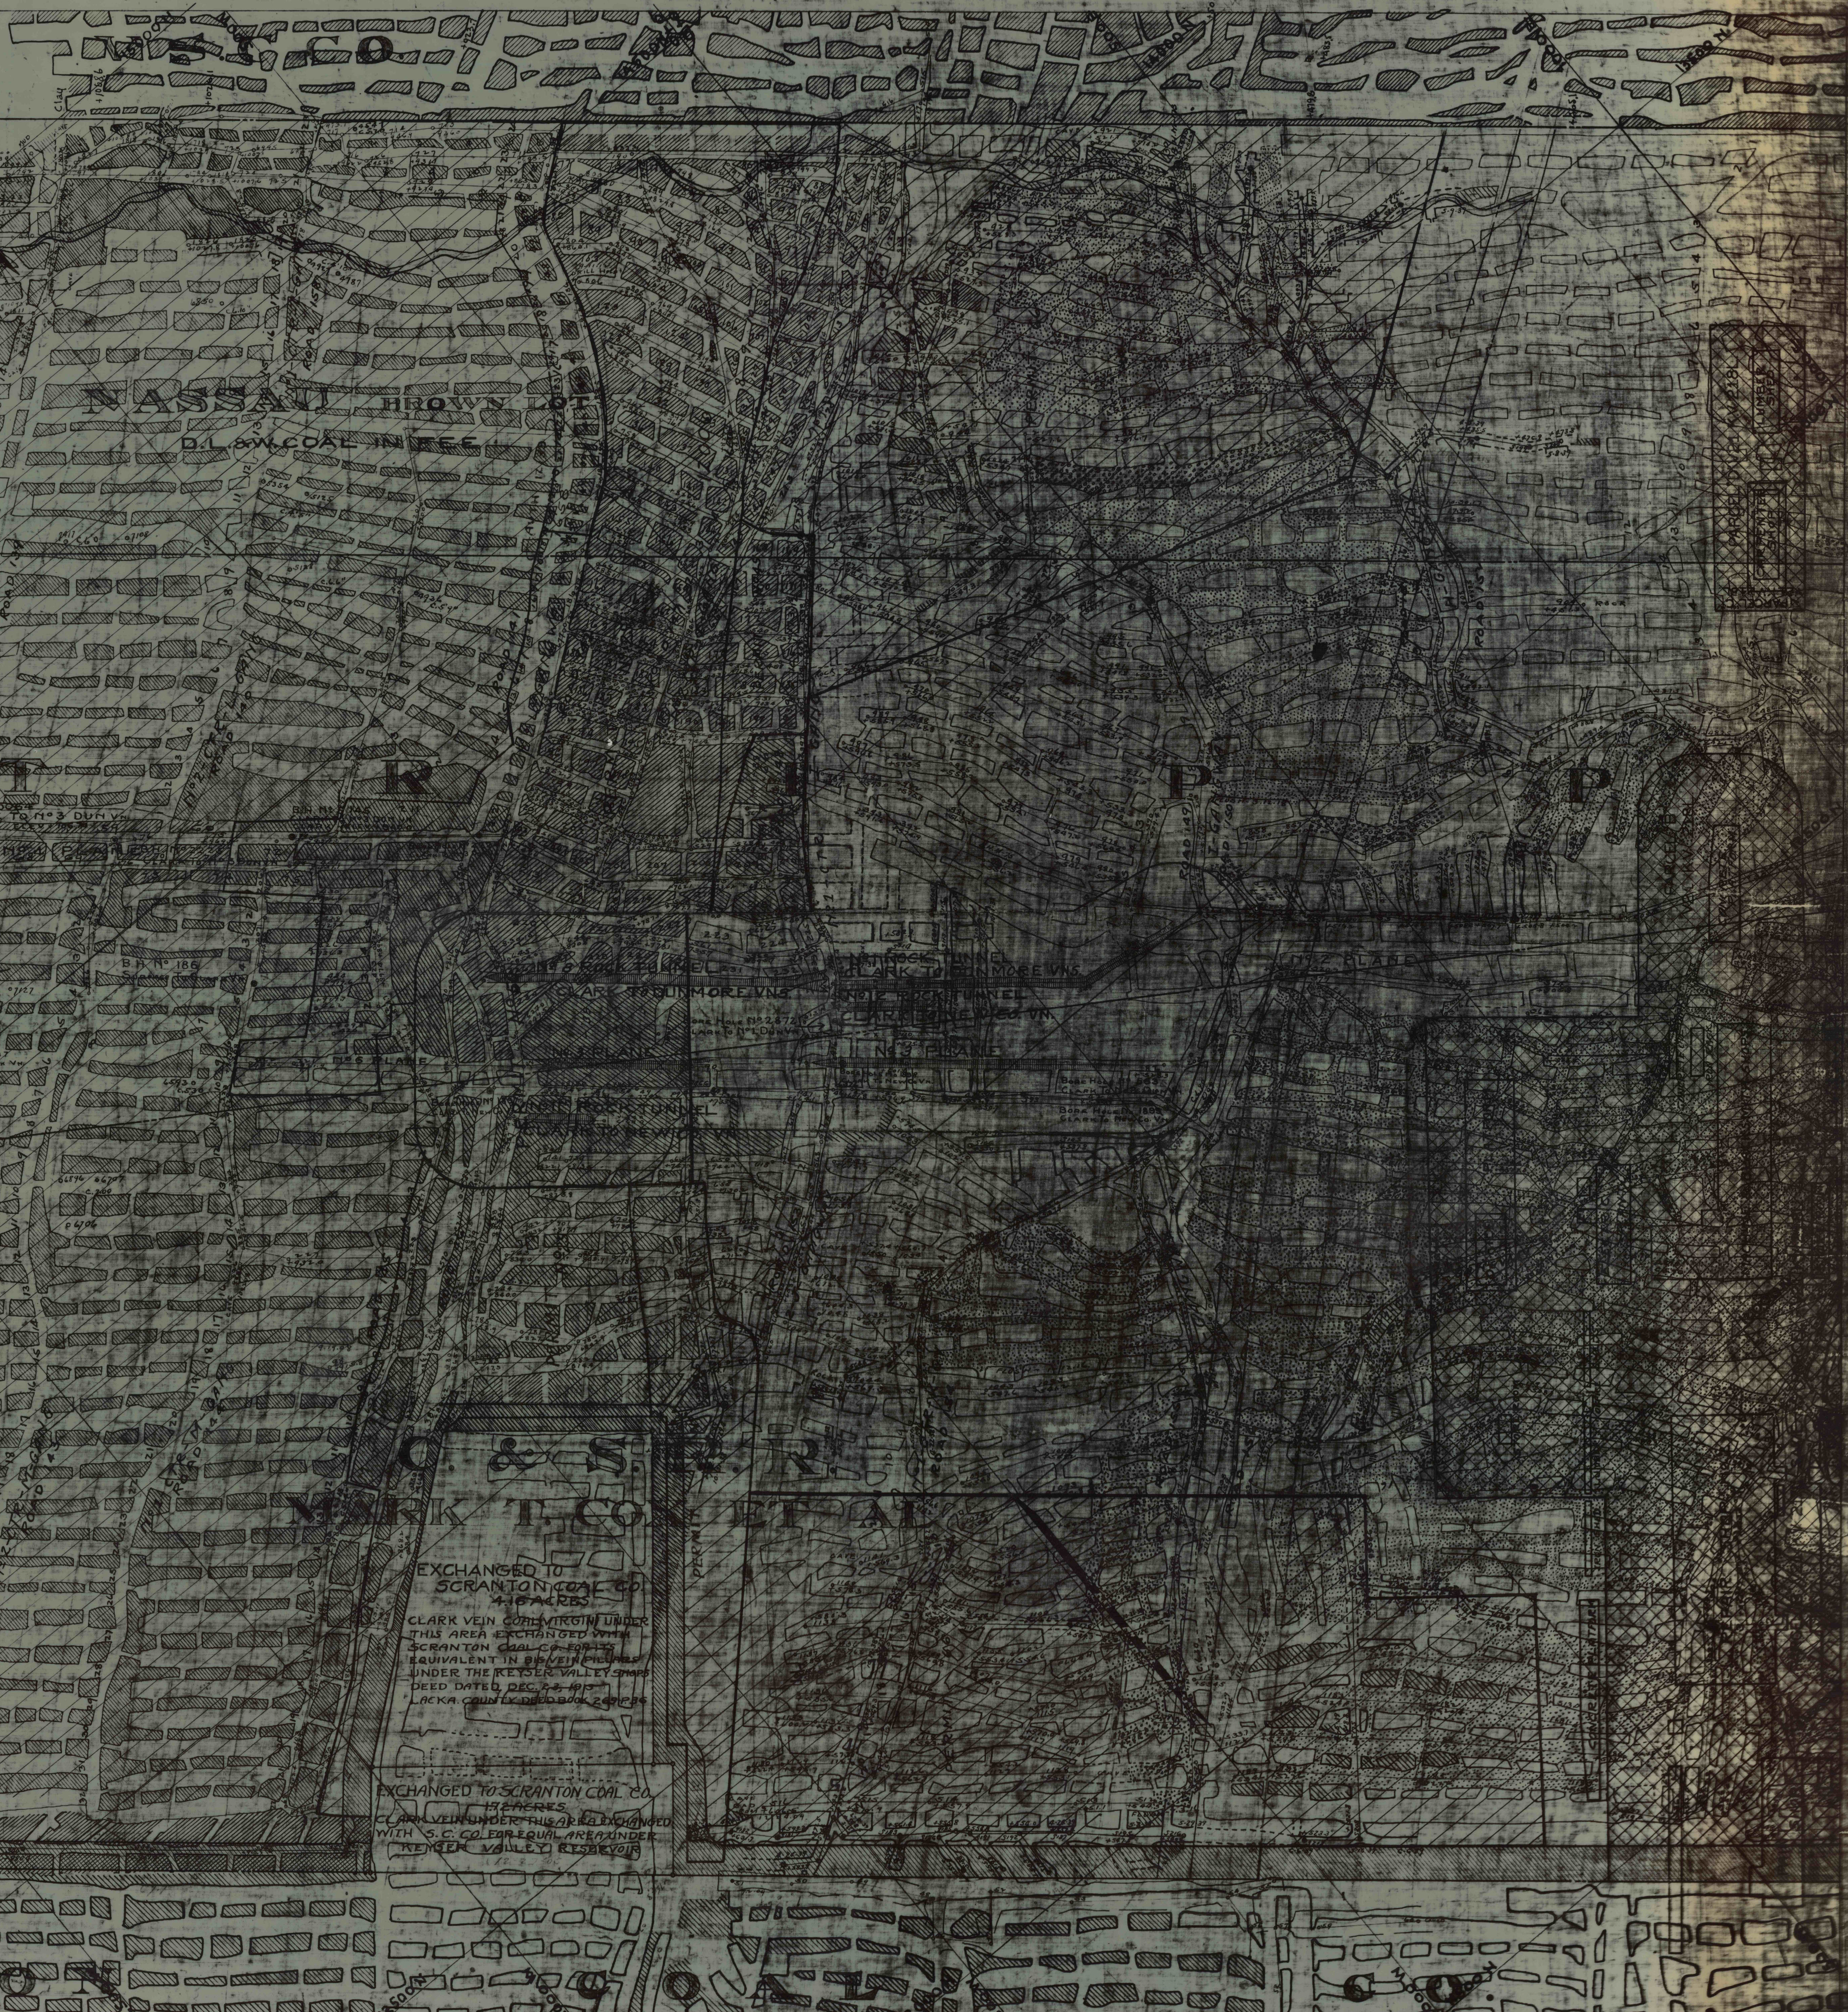

EXCHANGED TO SCRANTON COAL CO.
418 ACRES
CLARK VEIN COAL MINE UNDER
THIS AREA EXCHANGED WITH
SCRANTON COAL CO. FOR AN
DEED DATED DEC. 22, 1913
LACKA COUNTY DEED BOOK 2412 P. 84

EXCHANGED TO SCRANTON COAL CO.
CLARK VEIN UNDER THIS AREA EXCHANGED
WITH S. C. CO. FOR EQUAL AREA UNDER
KEYSER VALLEY RESERVOIR

11612