

CHAS. SUPPLY SHED
CHAS. SUPPLY SHED

PENN ANTH. COAL CO.


WALSH
MEYLERT
SANDERSON & MEYLERT DISPUTE AREA No. 3
SANDERSON & MEYLERT DISPUTE AREA No. 2
GRiffin
NASSAU
CHURCH
KELSEY
KELSEY
SCHROEDER
SANDERSON

PENN ANTH. COAL CO.

BLAIR
TRIPP COURT HOUSE THOMPSON
NASSAU
WOLFE
NASSAU
BROWN

PENN ANTH. COAL CO.

LATON LEACH

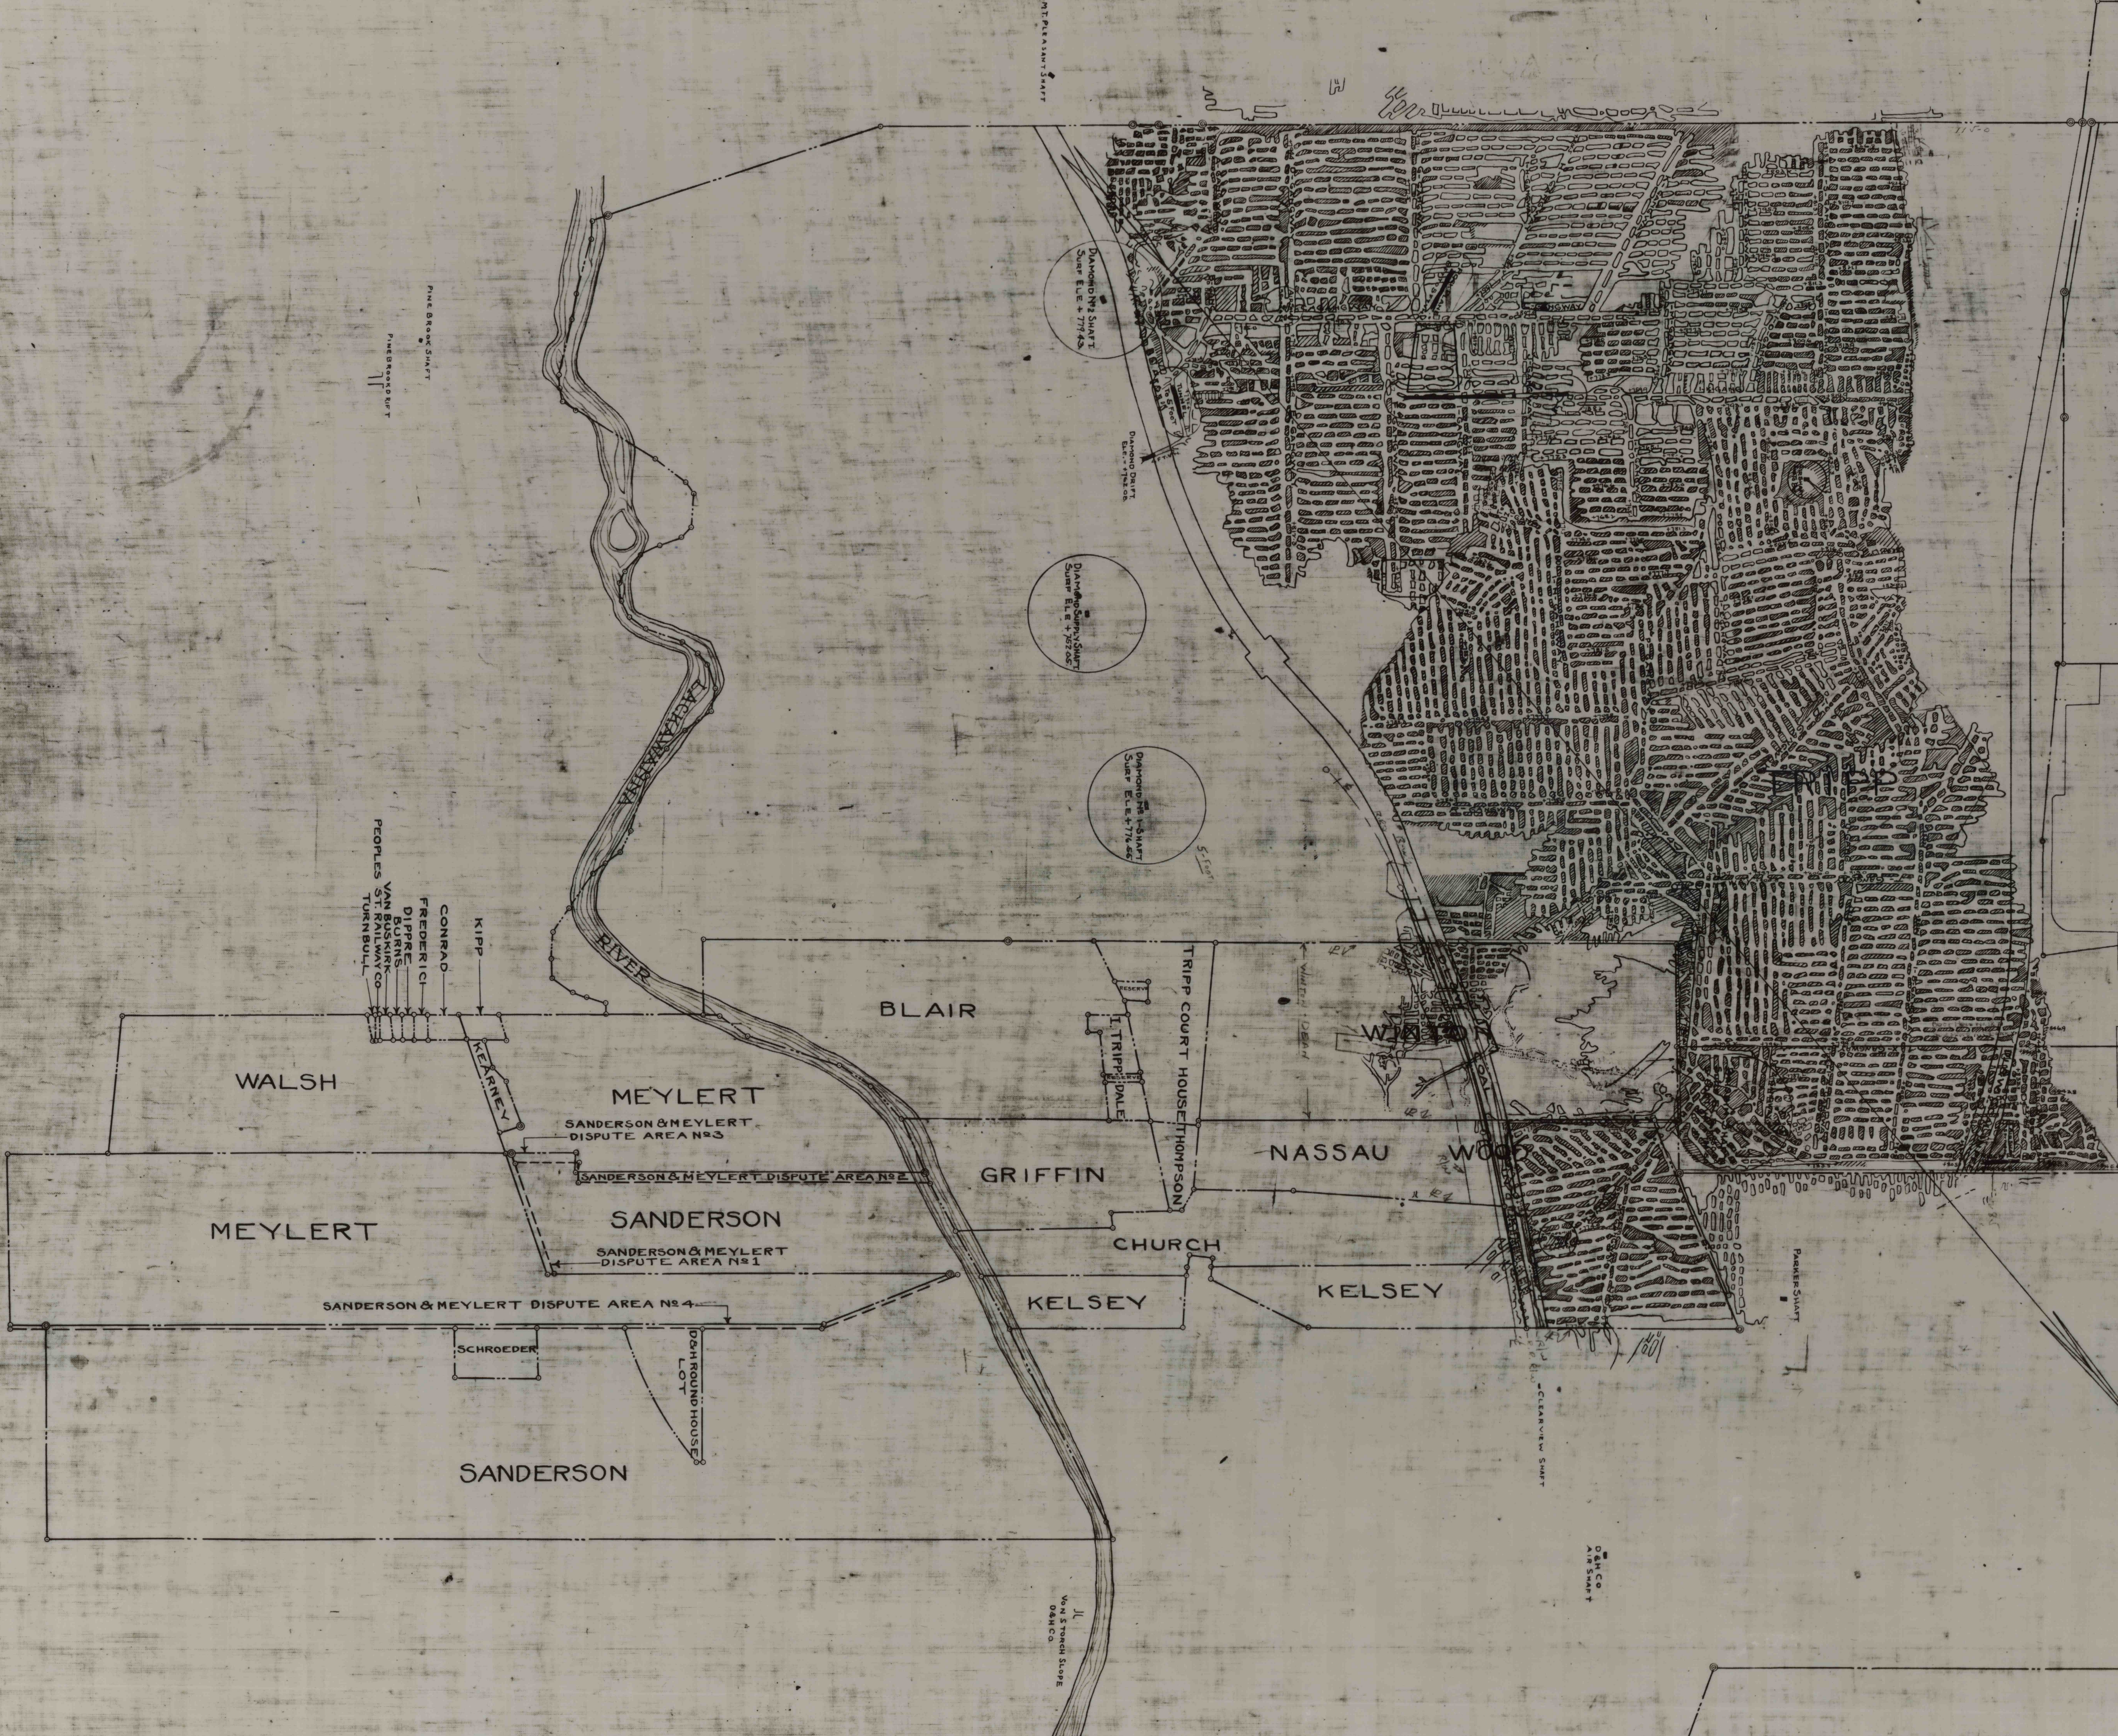

BRISBIN-DIAMOND-MANVILLE

5 FOOT VEIN

SCALE 1" = 400'