


**BRISBANDIAMOND-MANVILLE
NEW COUNTY - BOTTOM SPLIT**

SCALE 1" = 400'

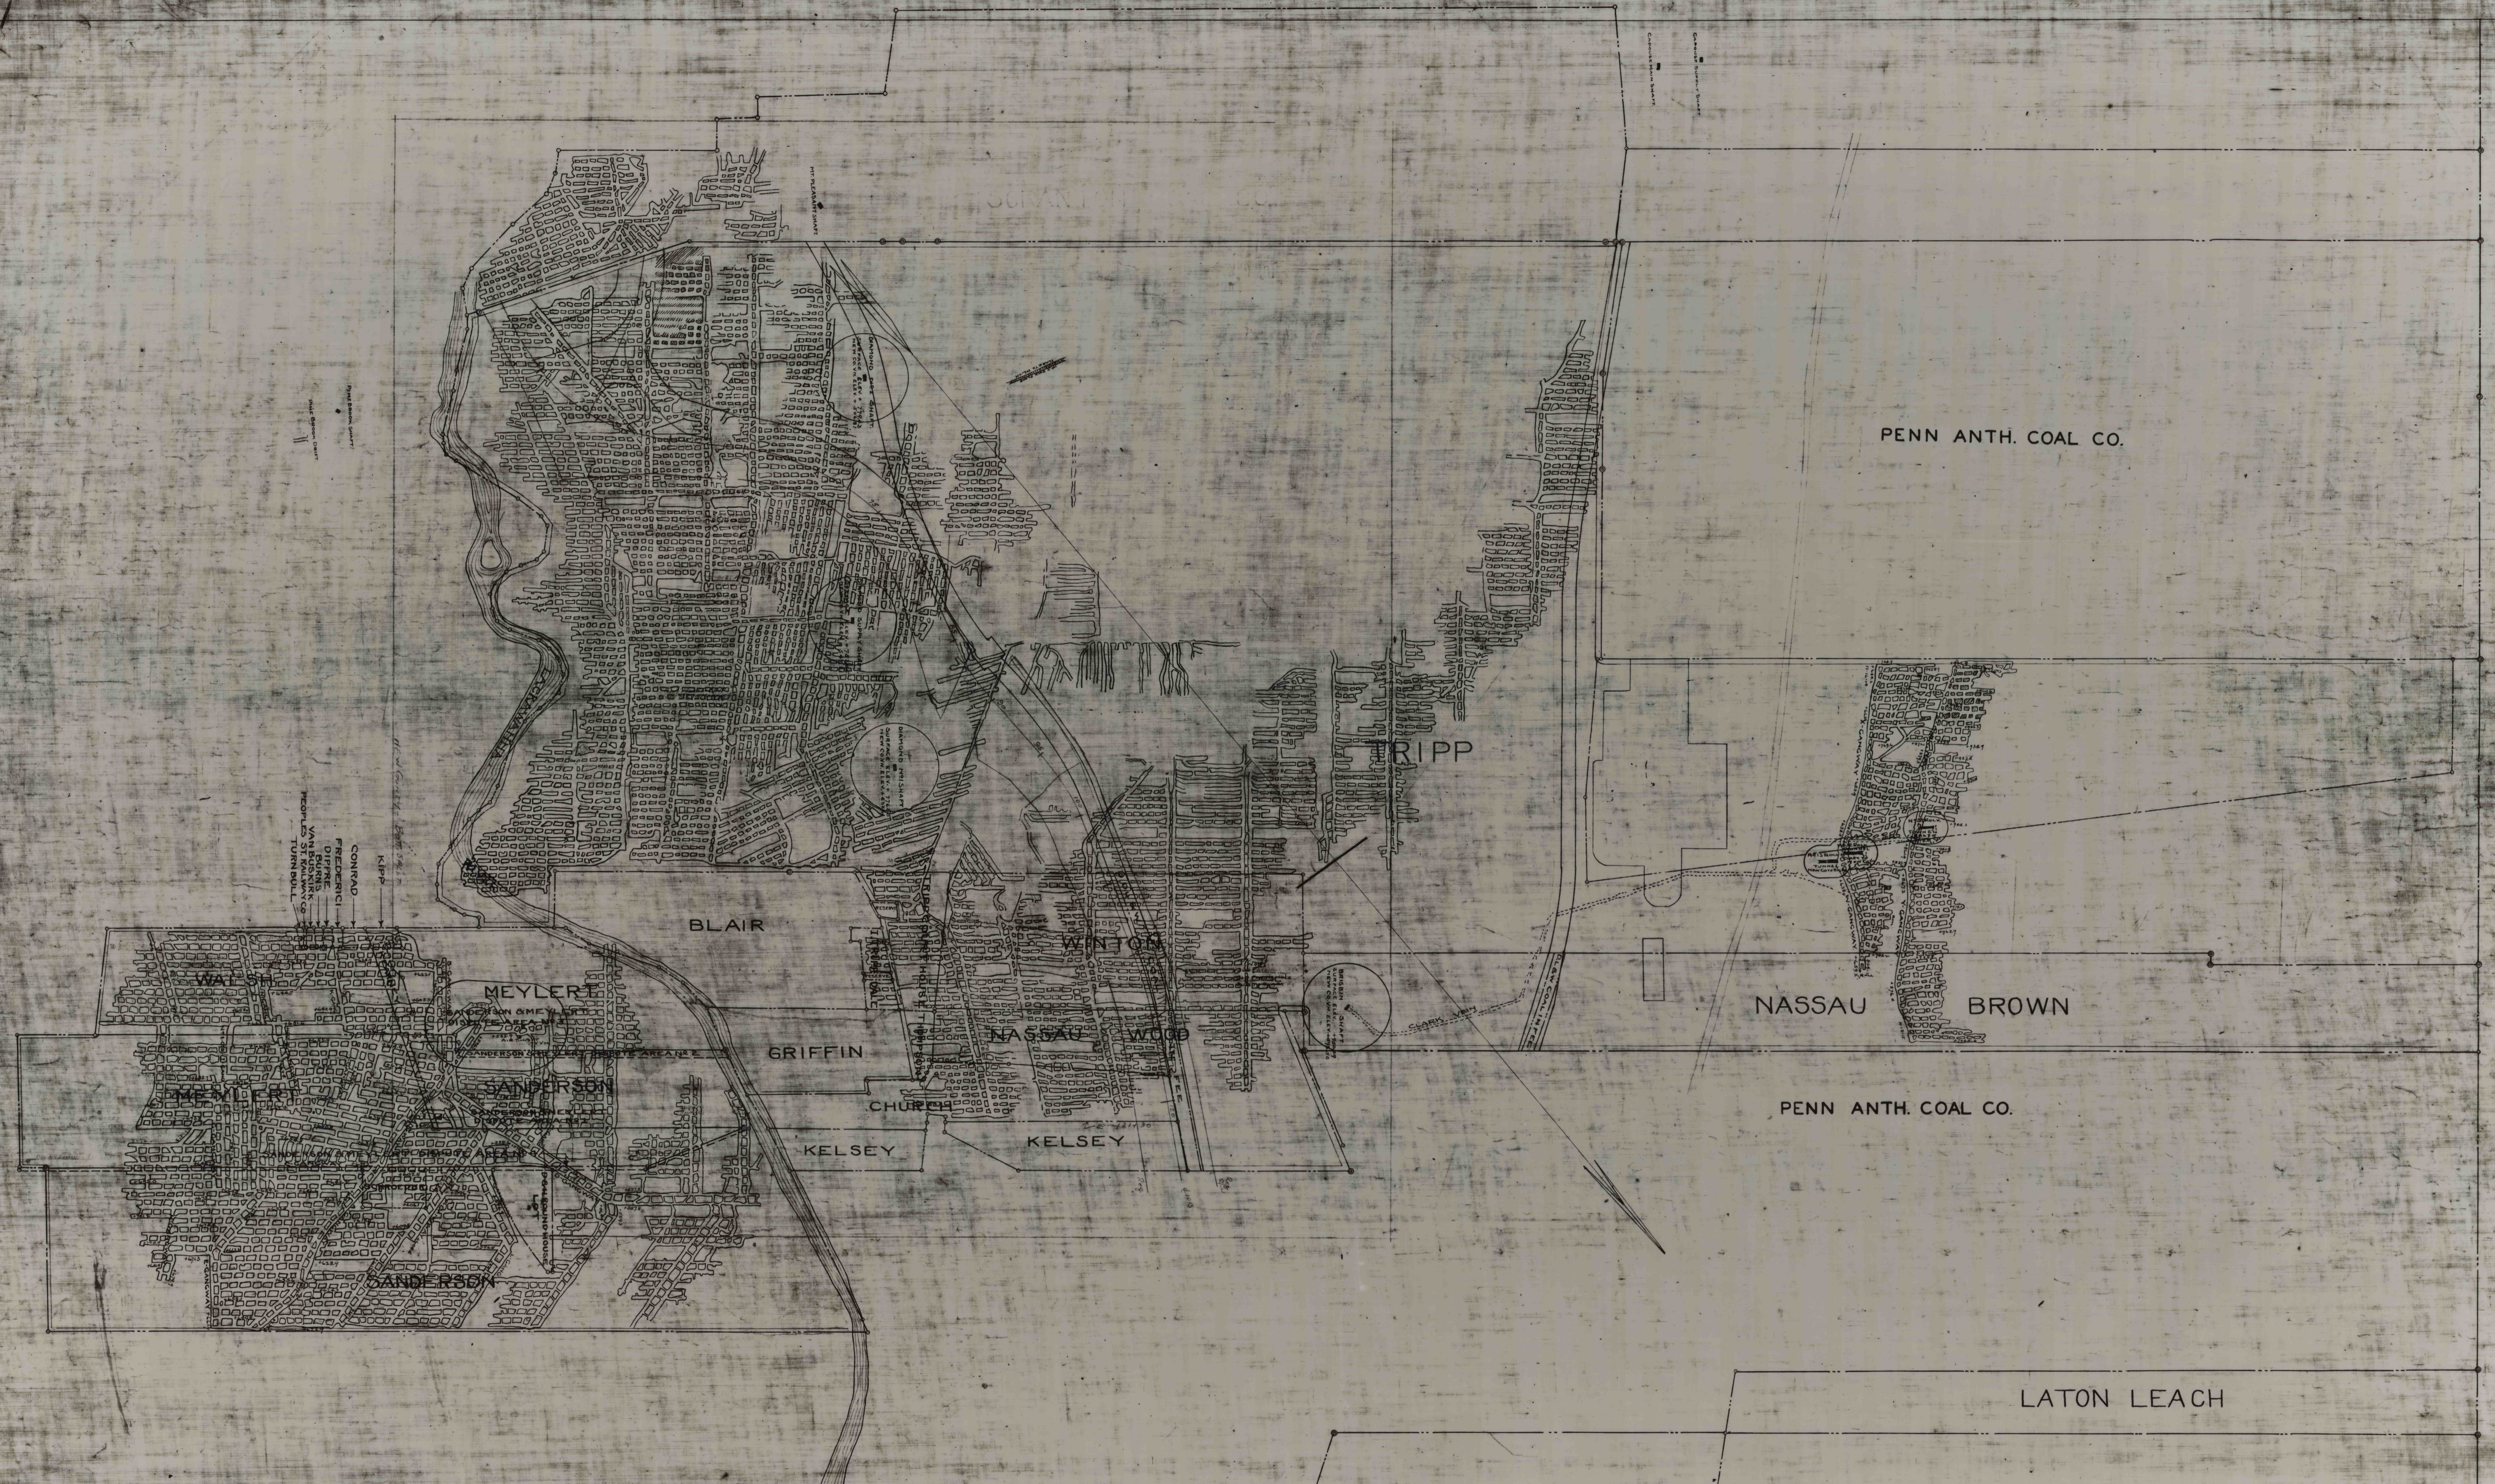

LATON LEACH