


H M KELSEY

CHAS CHURCH

N A S S A U

W I N T O N

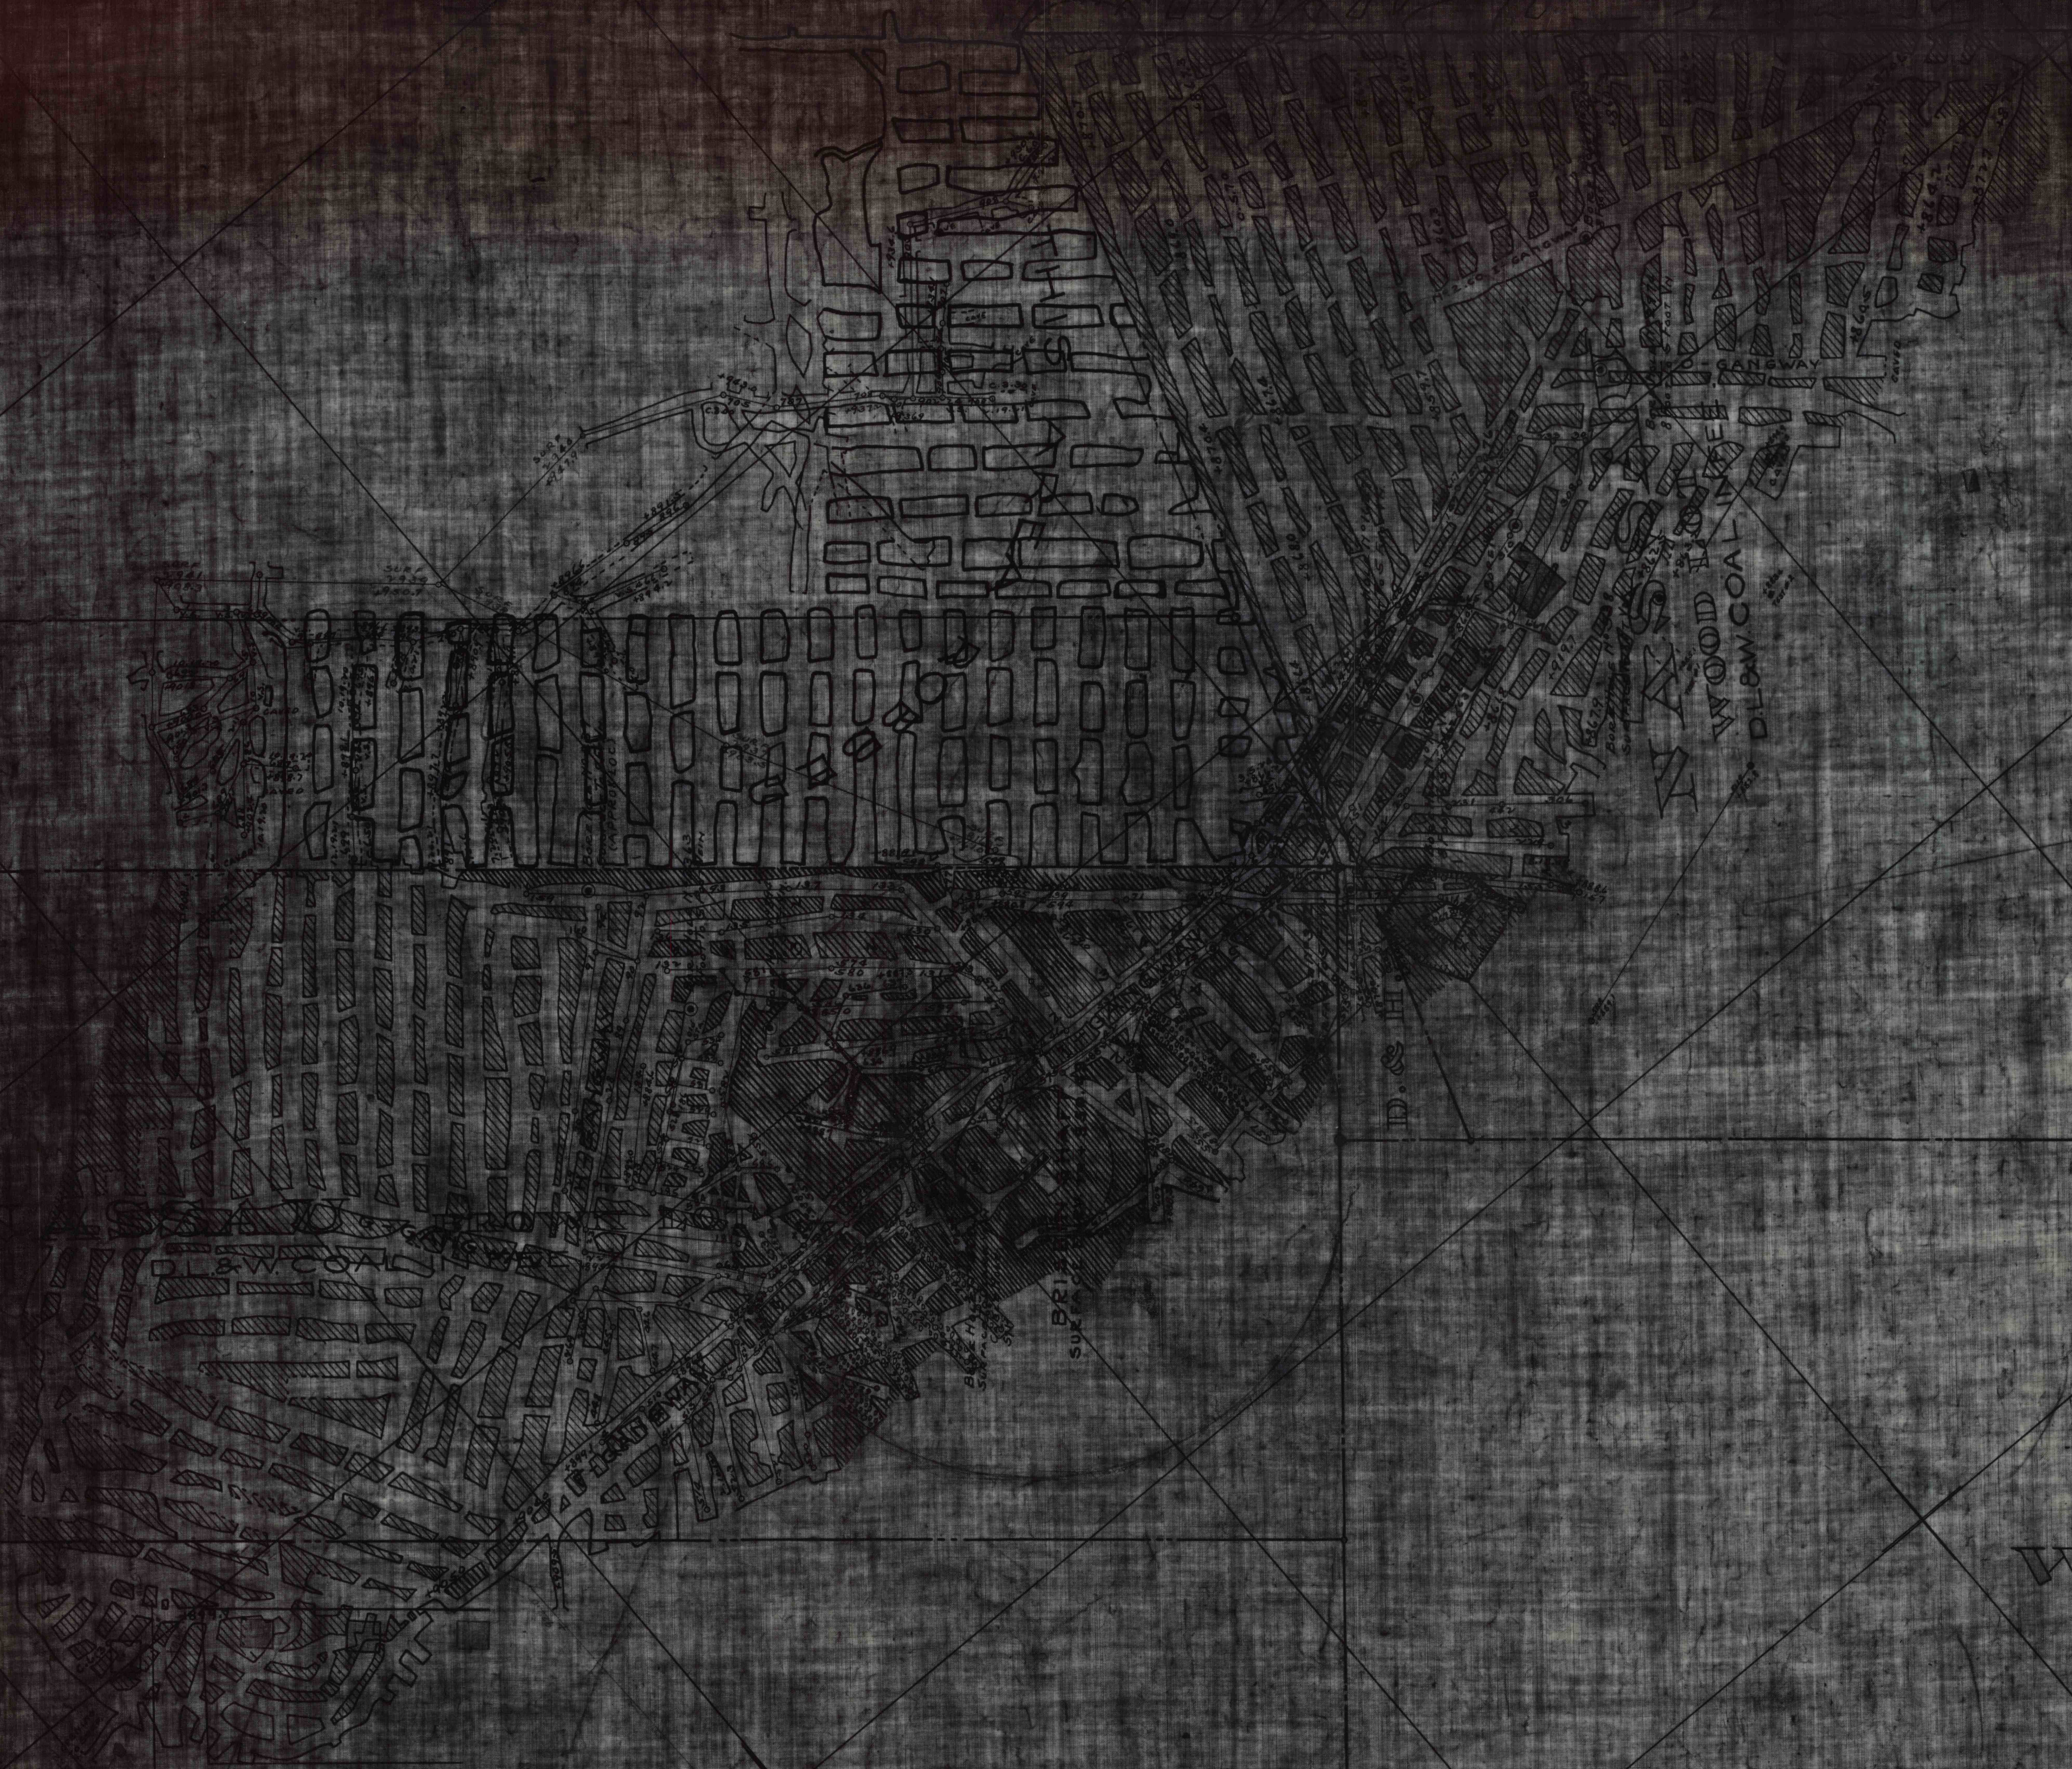

WOOD COAL

MAIN LINE

RIGHT OF WAY

EIGHTY FOOT BEAR

DIAMOND COLLY

AGE

AGE

AGE

© 1885