



SITE PLAN

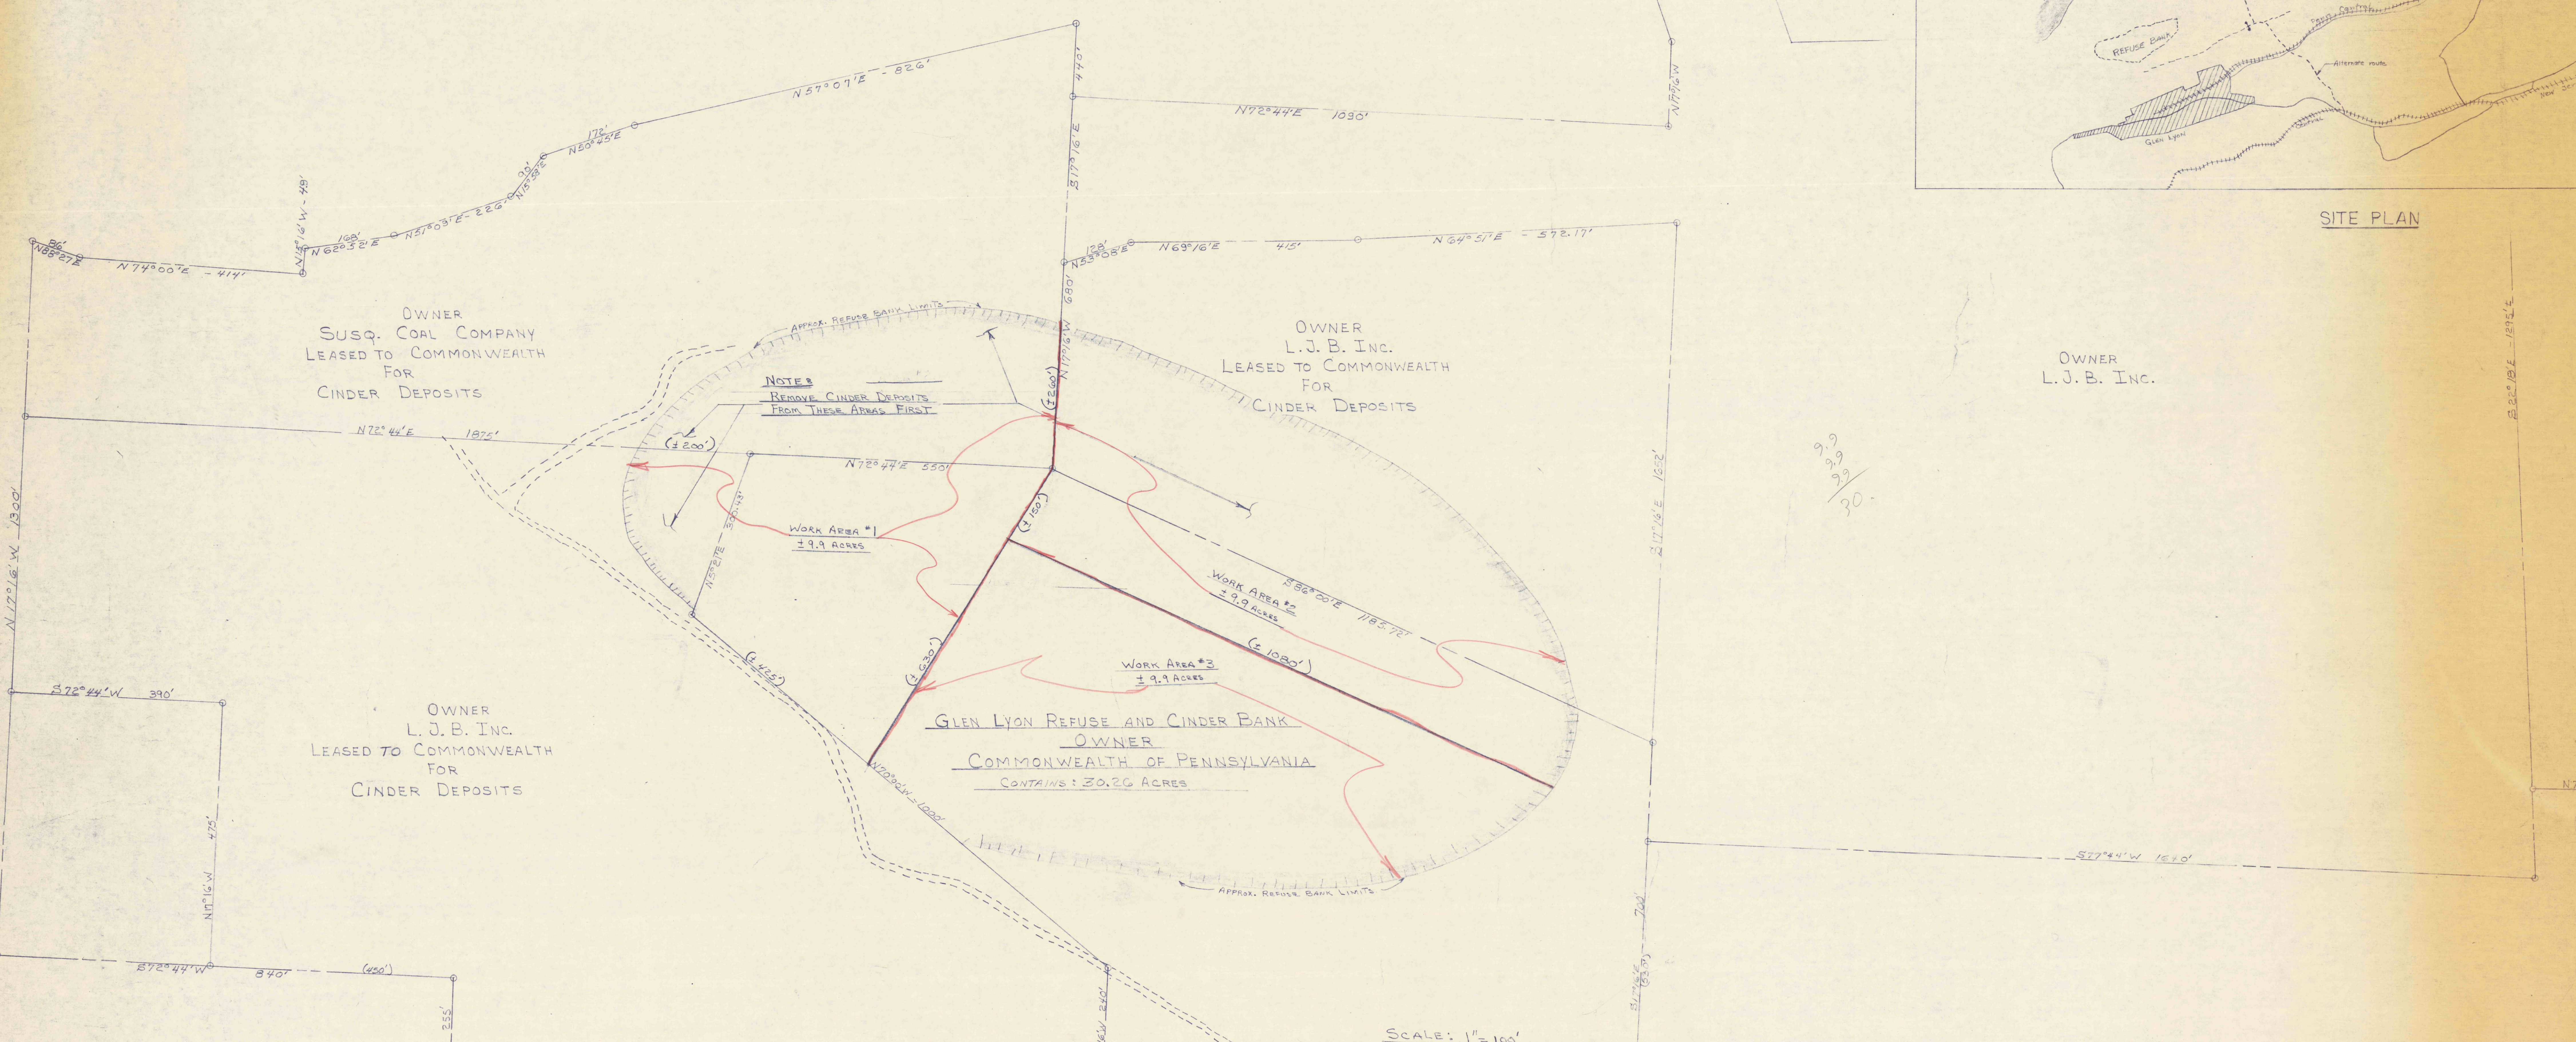

9.9
9.9
9.9
30.

SCALE: 1" = 100'

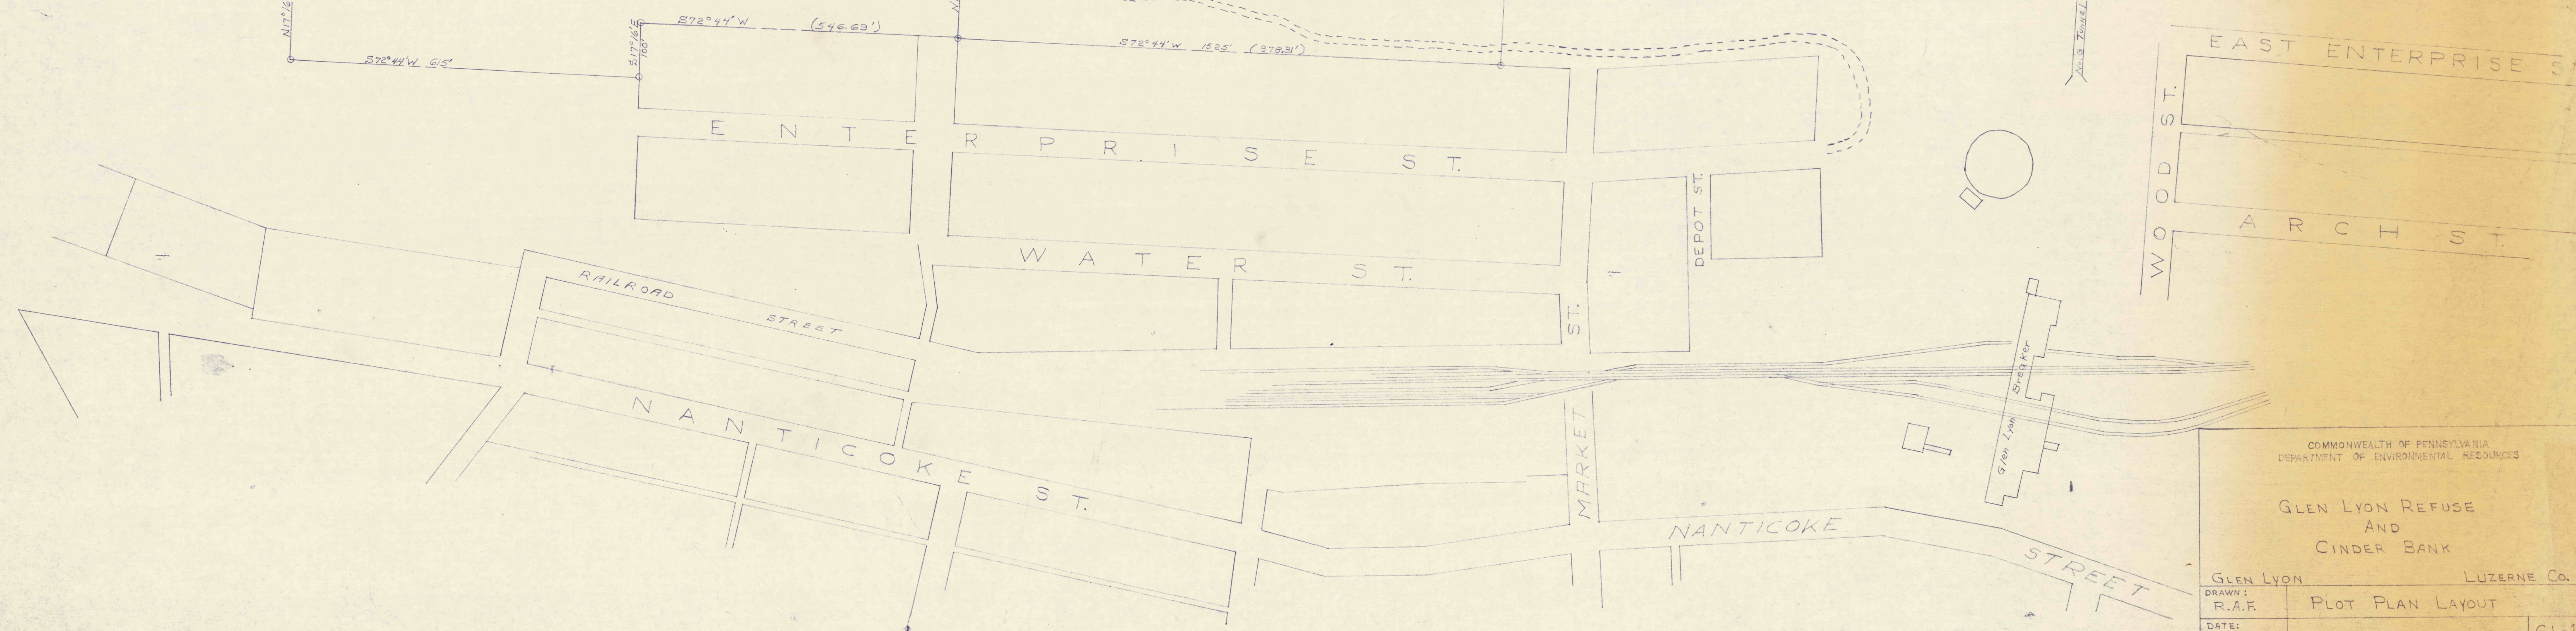

COMMONWEALTH OF PENNSYLVANIA DEPARTMENT OF ENVIRONMENTAL RESOURCES		
GLEN LYON REFUSE AND CINDER BANK		
GLEN LYON	LUZERNE CO.	
DRAWN BY: R.A.E.	PLOT PLAN LAYOUT	
DATE: 10-1-74	G40:3-201.10	GL-1