


SITE PLAN

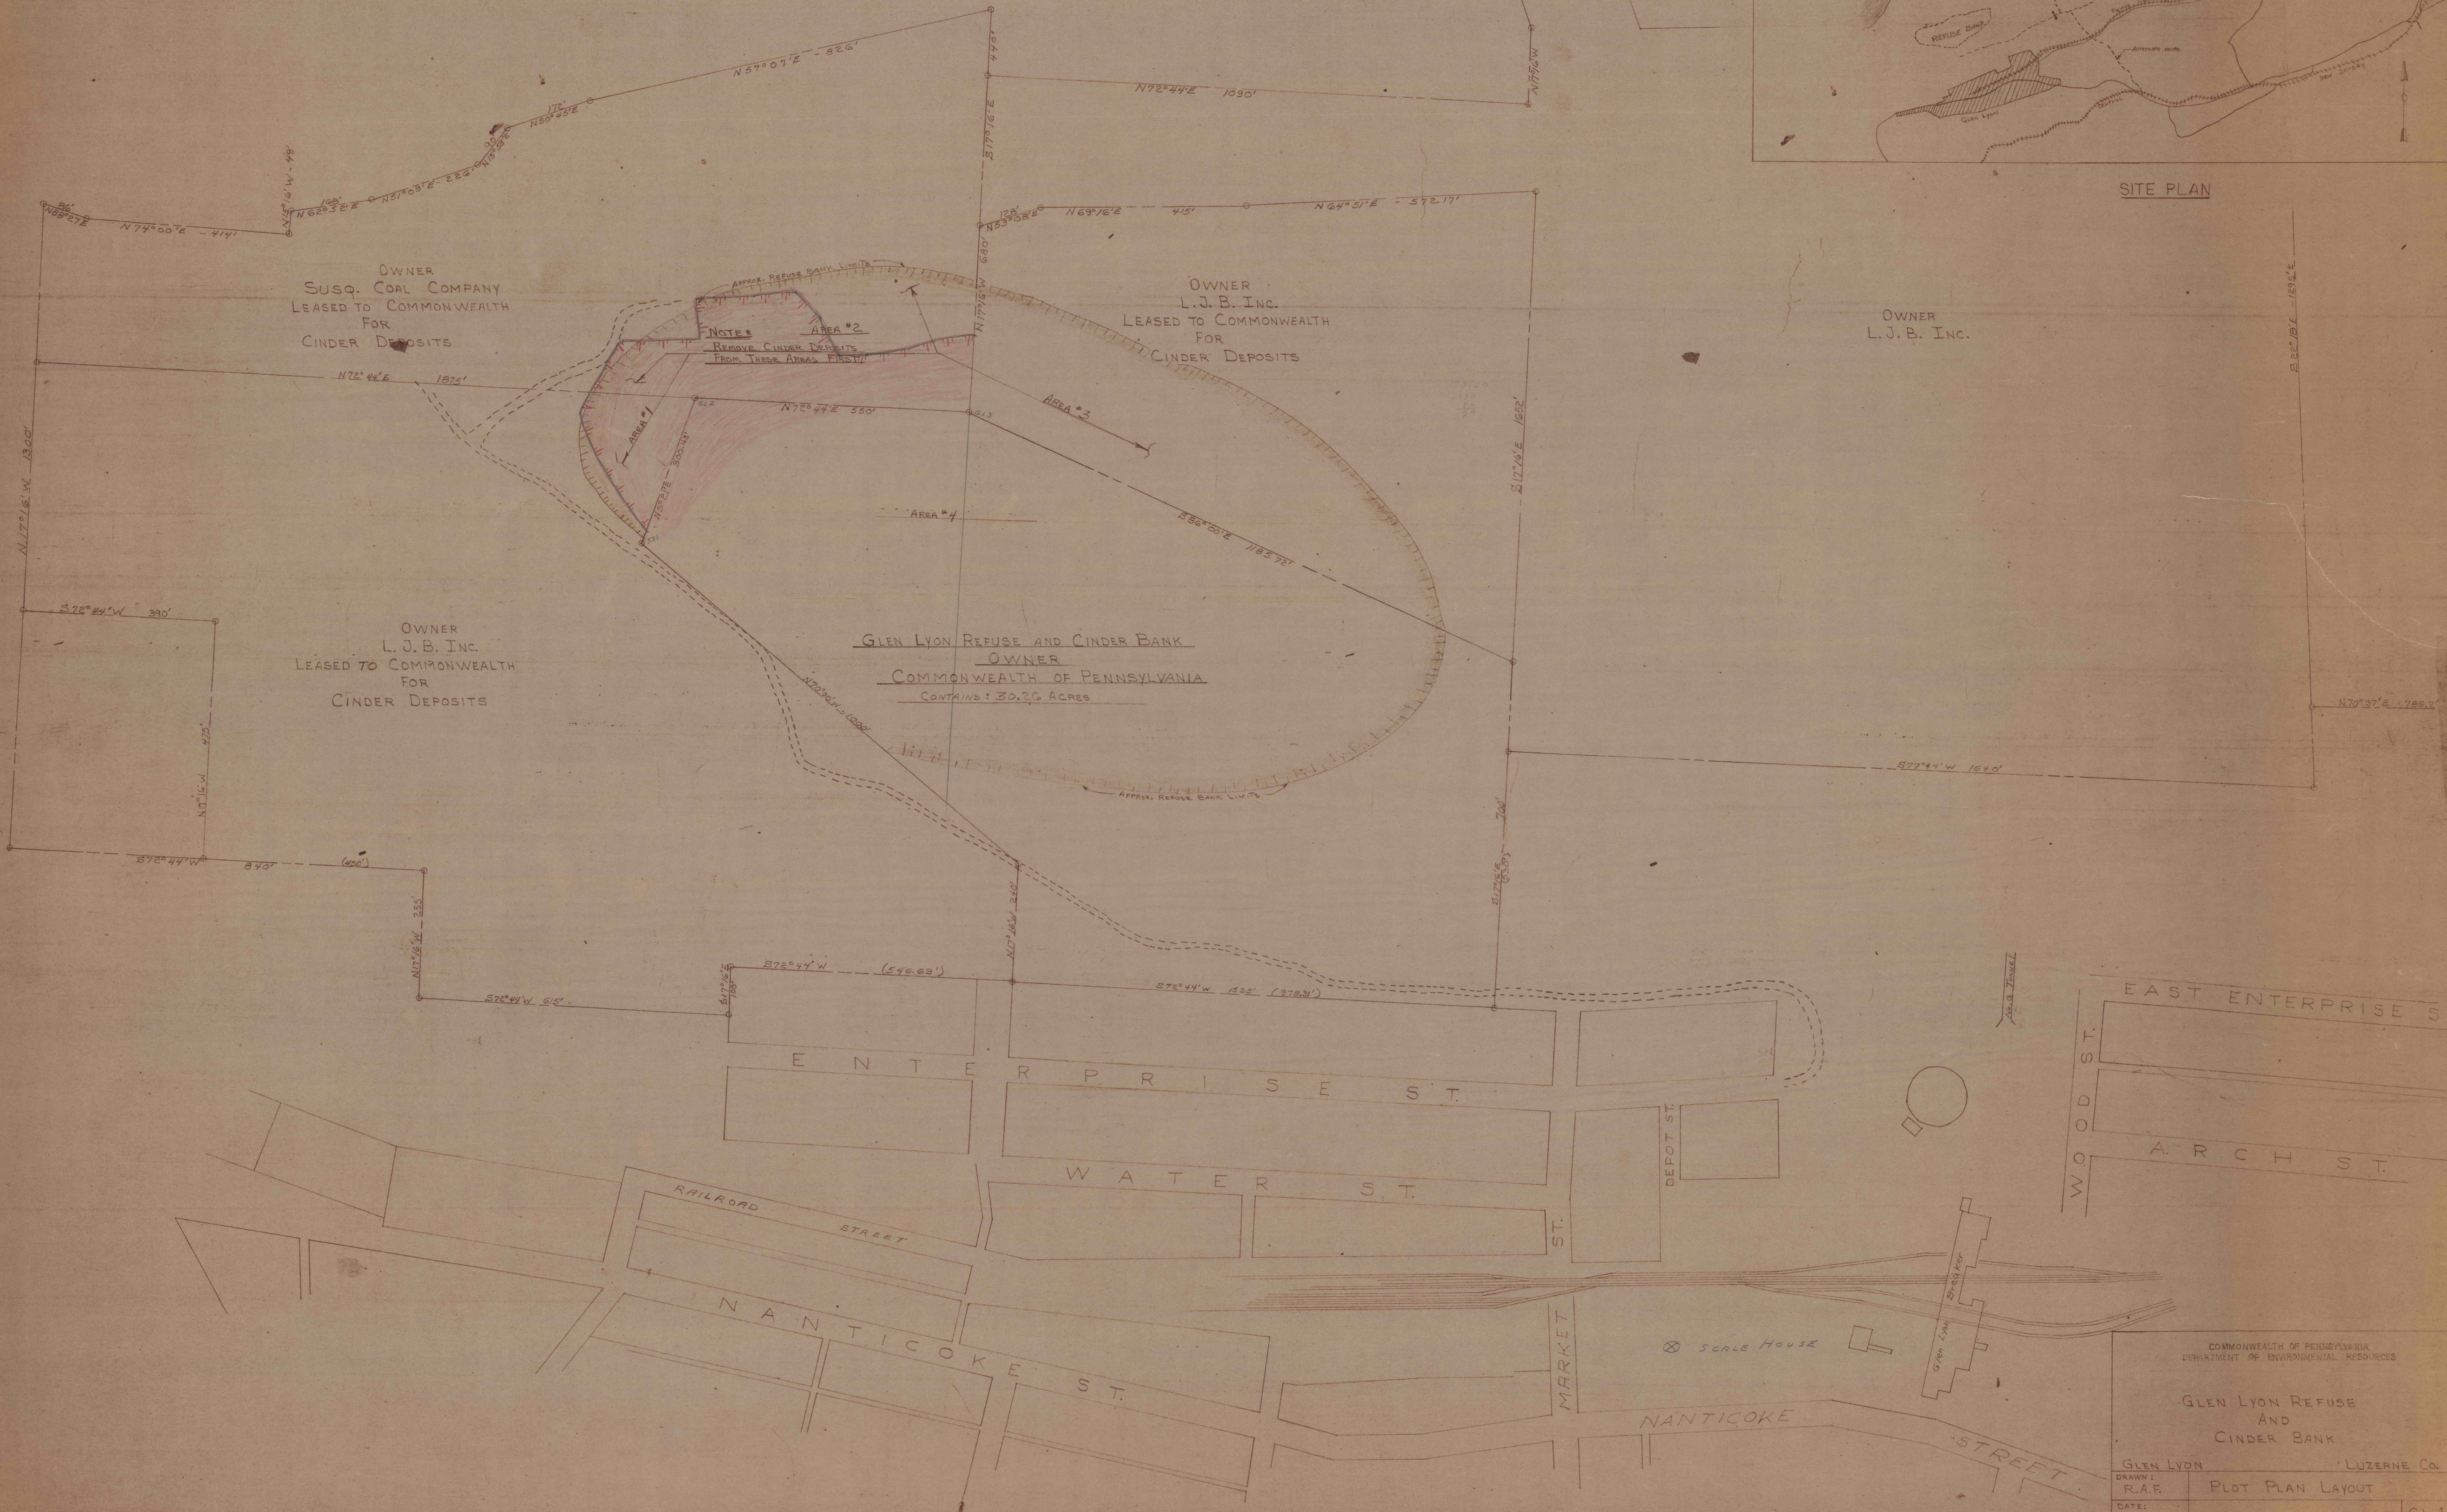

COMMONWEALTH OF PENNSYLVANIA
DEPARTMENT OF ENVIRONMENTAL RESOURCES

GLEN LYON REFUSE AND CINDER BANK
GLEN LYON LUZERNE CO.

DRAWN: R.A.F. PLOT PLAN LAYOUT
DATE: 10-1-74 GL-1