


- REFERENCES:**
- 1. Drainage Ditches Plan and Sections ..... Dwg No's 1.4 and 1.5
  - 2. Details of Overflow, Drop Structures, and Rock Barriers ..... Dwg No. 1.7

NO.	DATE	REVISION	APPR.
10-2778		As built	
SUBMITTED			
PROJECT CO-ORDINATOR P. Gupta			
APPROVED [Signature] CHIEF - DIVISION OF WATER RESOURCES PROJECTS			
APPROVED [Signature] DIRECTOR - BUREAU OF RESOURCES PROGRAMMING			

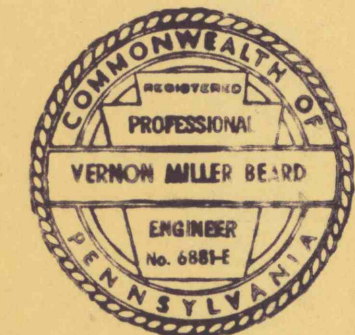

COMMONWEALTH OF PENNSYLVANIA  
 DEPARTMENT OF ENVIRONMENTAL RESOURCES  
 OFFICE OF RESOURCES MANAGEMENT

PROJECT NO. G40:5-101.1  
 DRAINAGE IMPROVEMENTS  
 TO  
 LARKSVILLE FLUME

LUZERNE CO. PENNSYLVANIA