


5-14
13-13
STREET CAPITAL LIFE

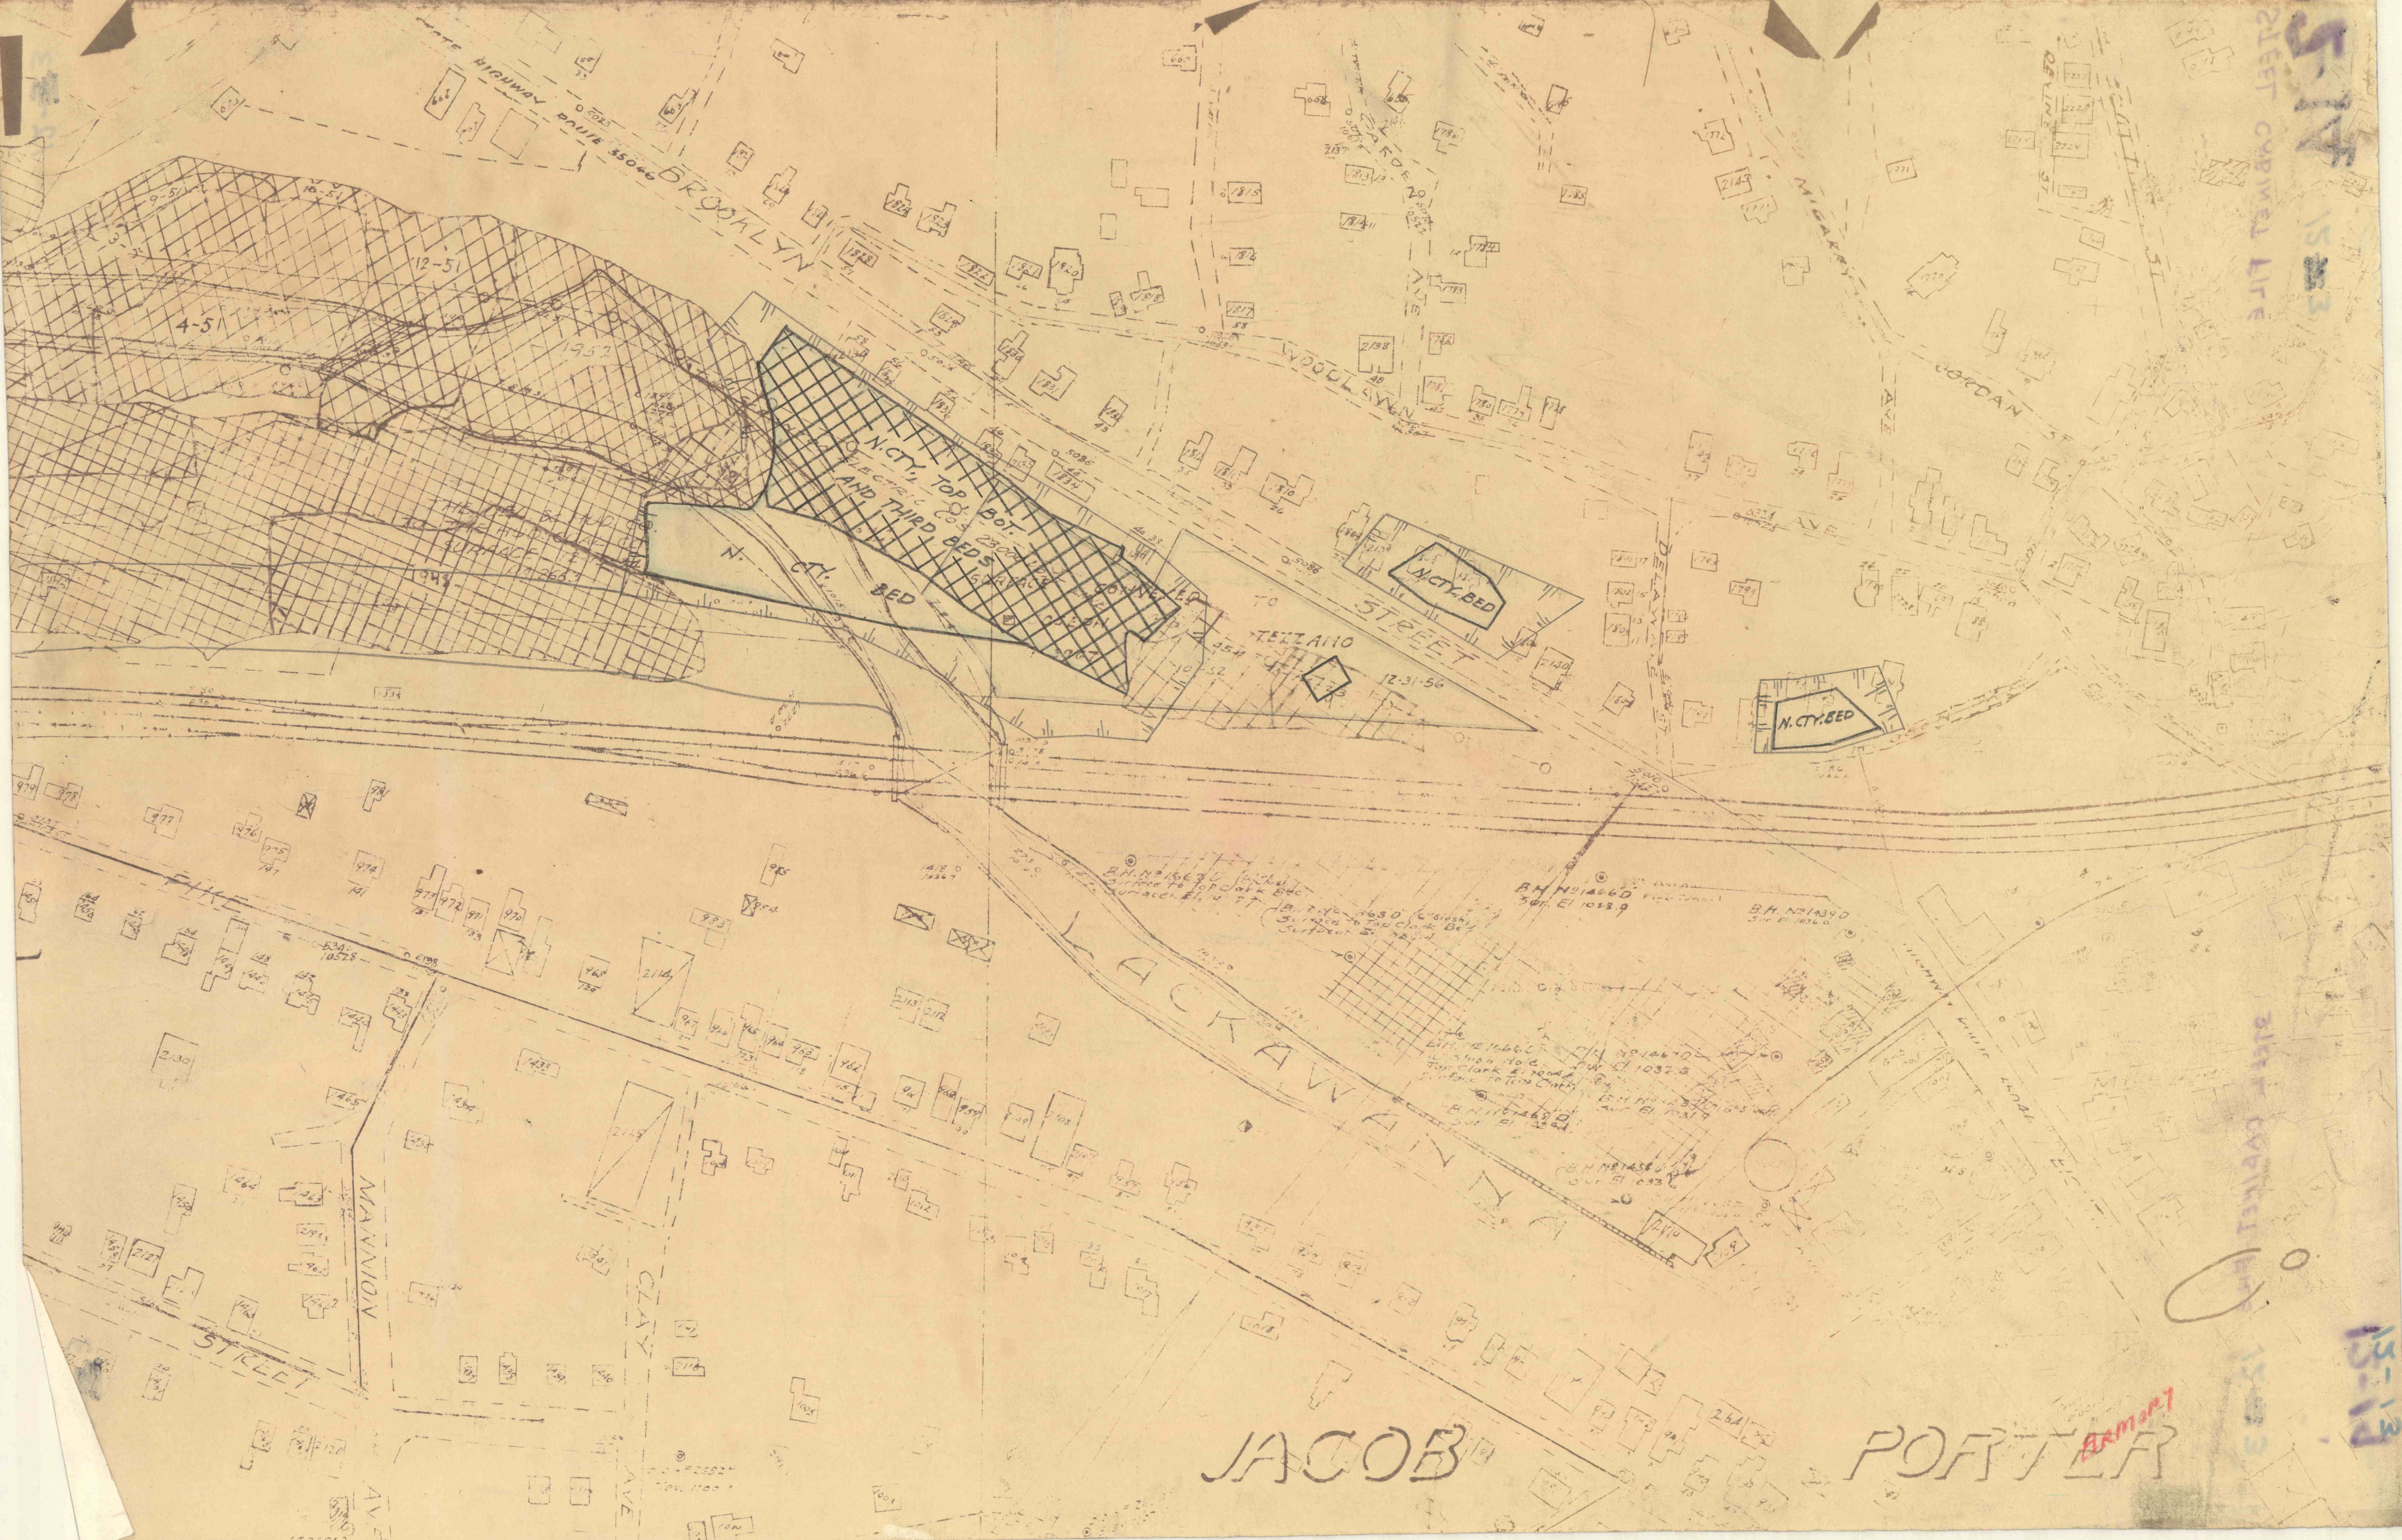

STREET CAPITAL LIFE
13-13

JACOB

PORTER

ARMORY