


BOTTOM NEW COUNTY

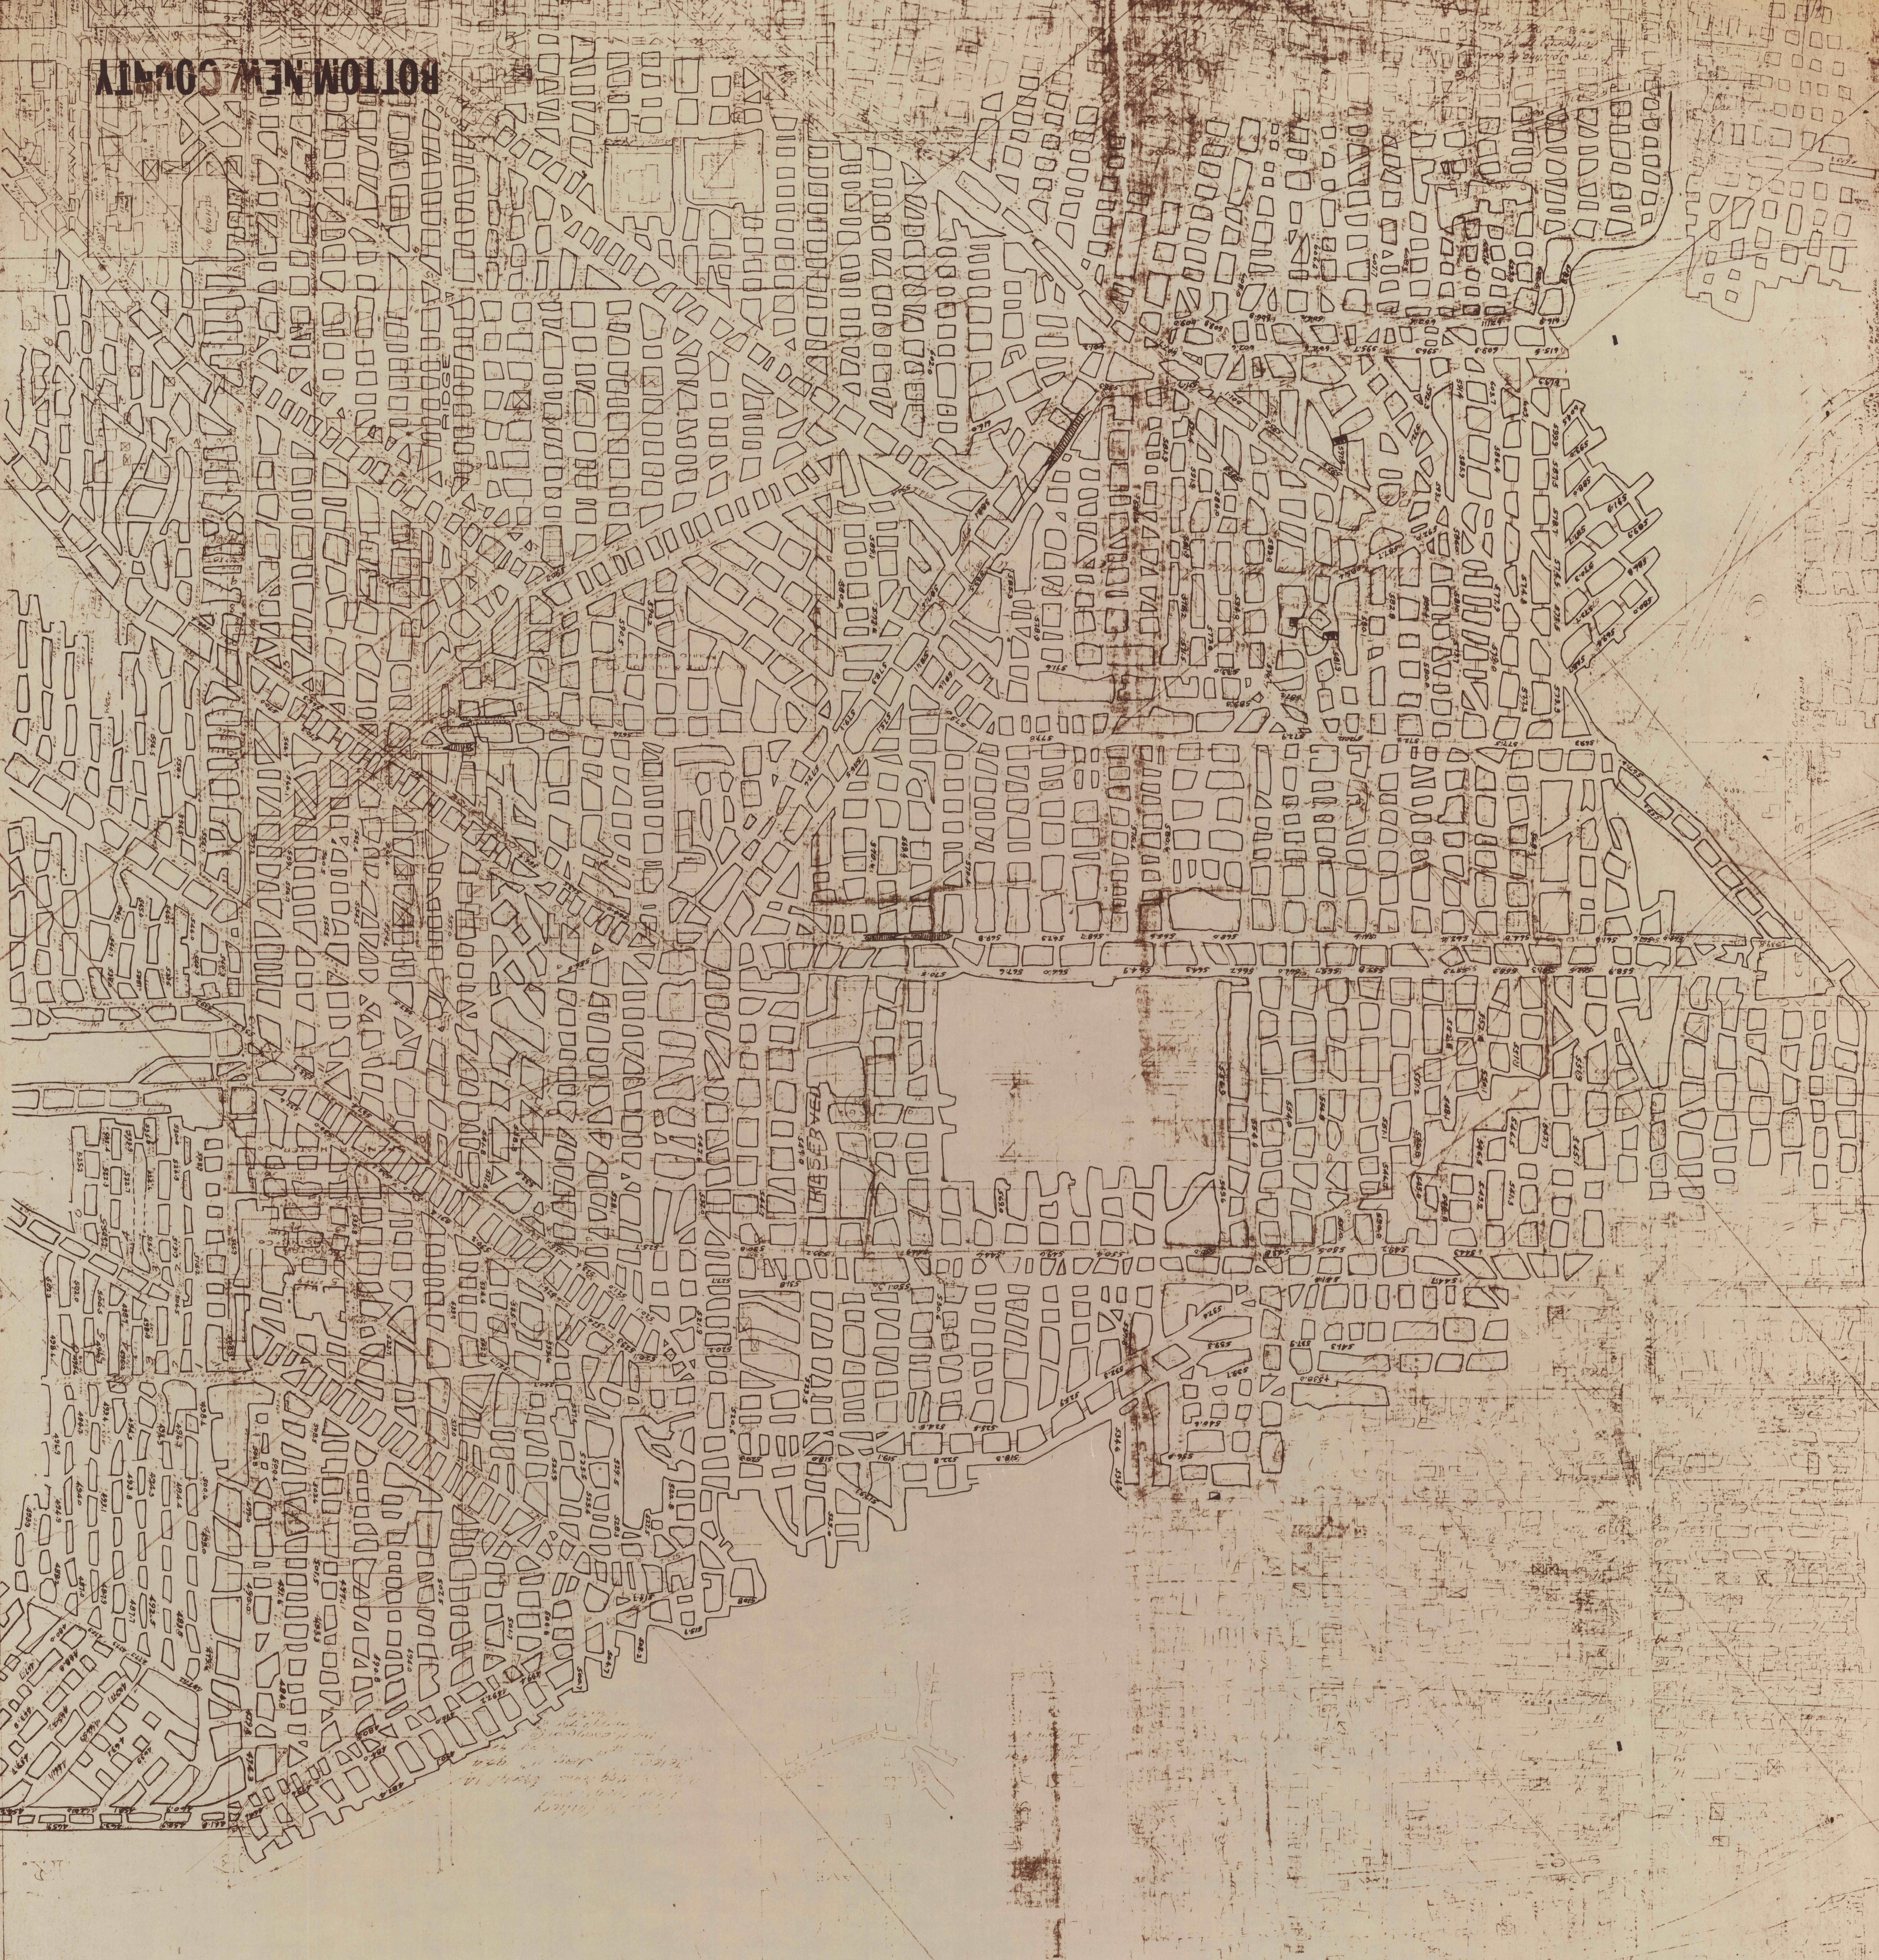

MANVILLE COLL'Y.  
BOT. NEW COUNTY BED  
SCALE 1" = 100'