

60N

TWIN VEIN

60N

TRACING NO. 13

SUSQ. COAL CO.  
No. 1

R. L. INNEN

SUSQ. COAL CO. No. 2


SUSQUEHANNA COAL CO.

STEPHEN LEE

3

INNEN

37567

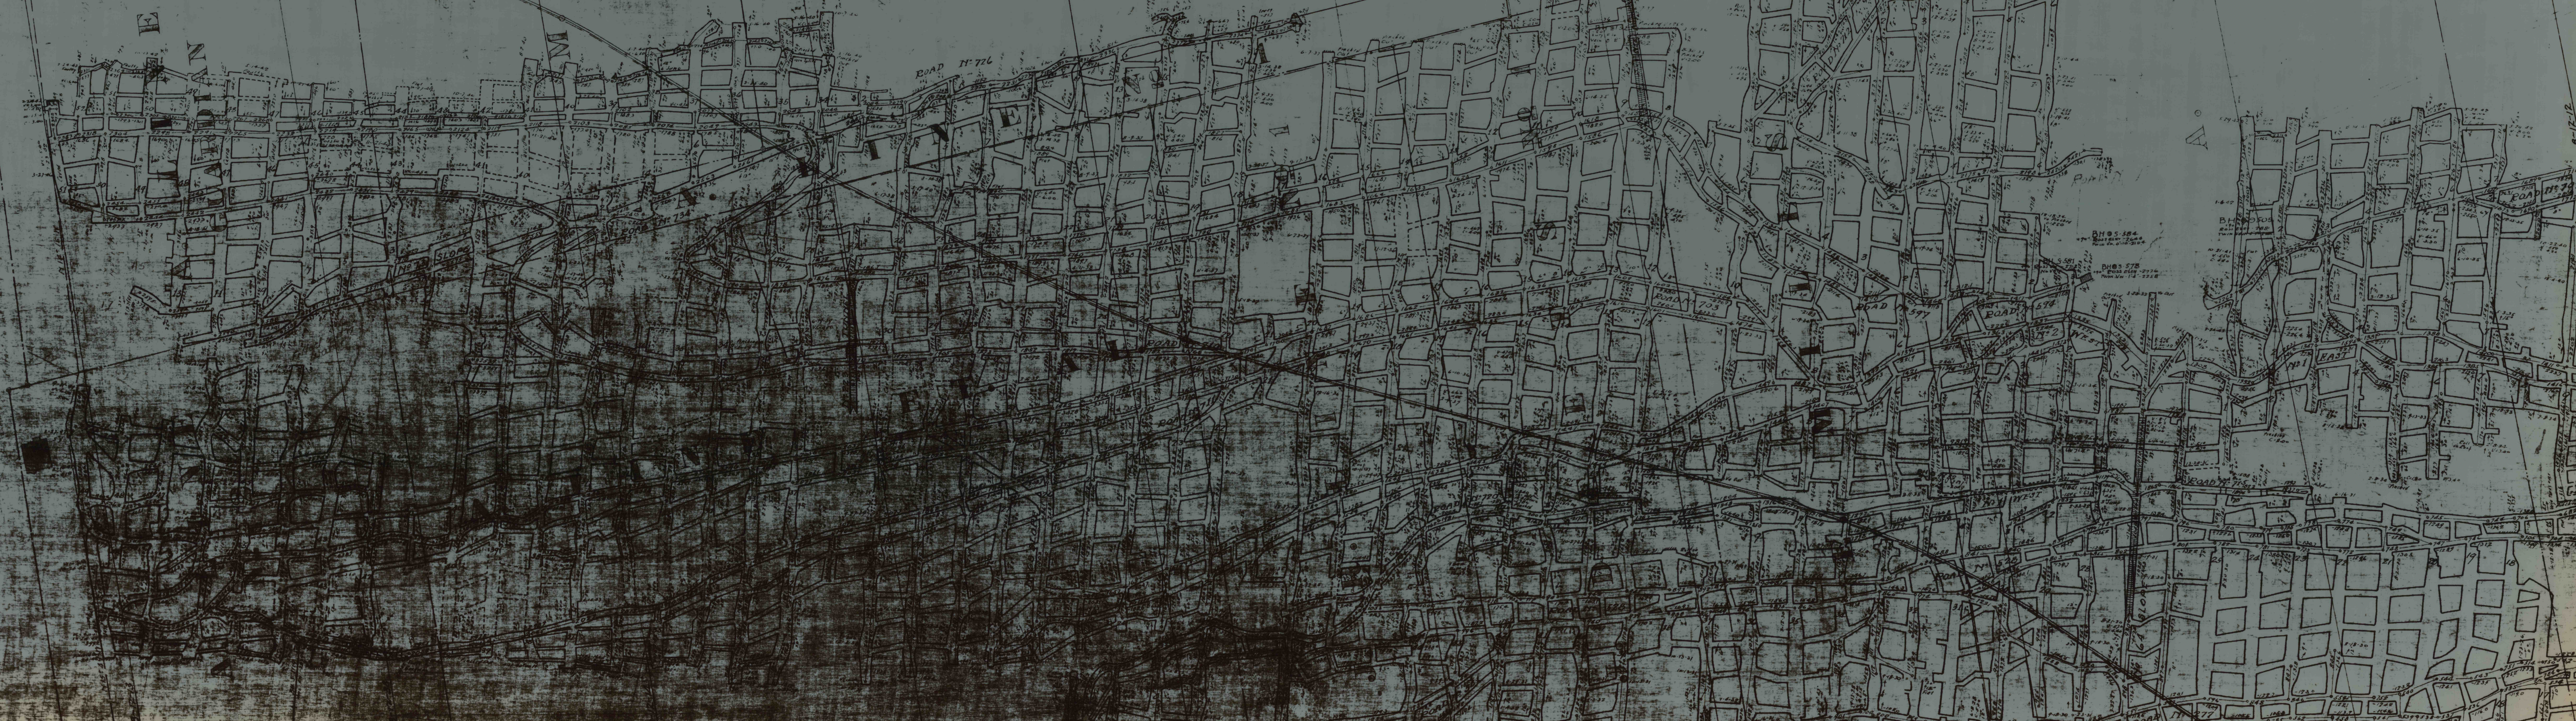

60N

TWIN VEIN

TRACING NO. 10

TRACING NO. 10

60N