


TRACING NO. 9

ROSS VEIN

TRACING NO. 10

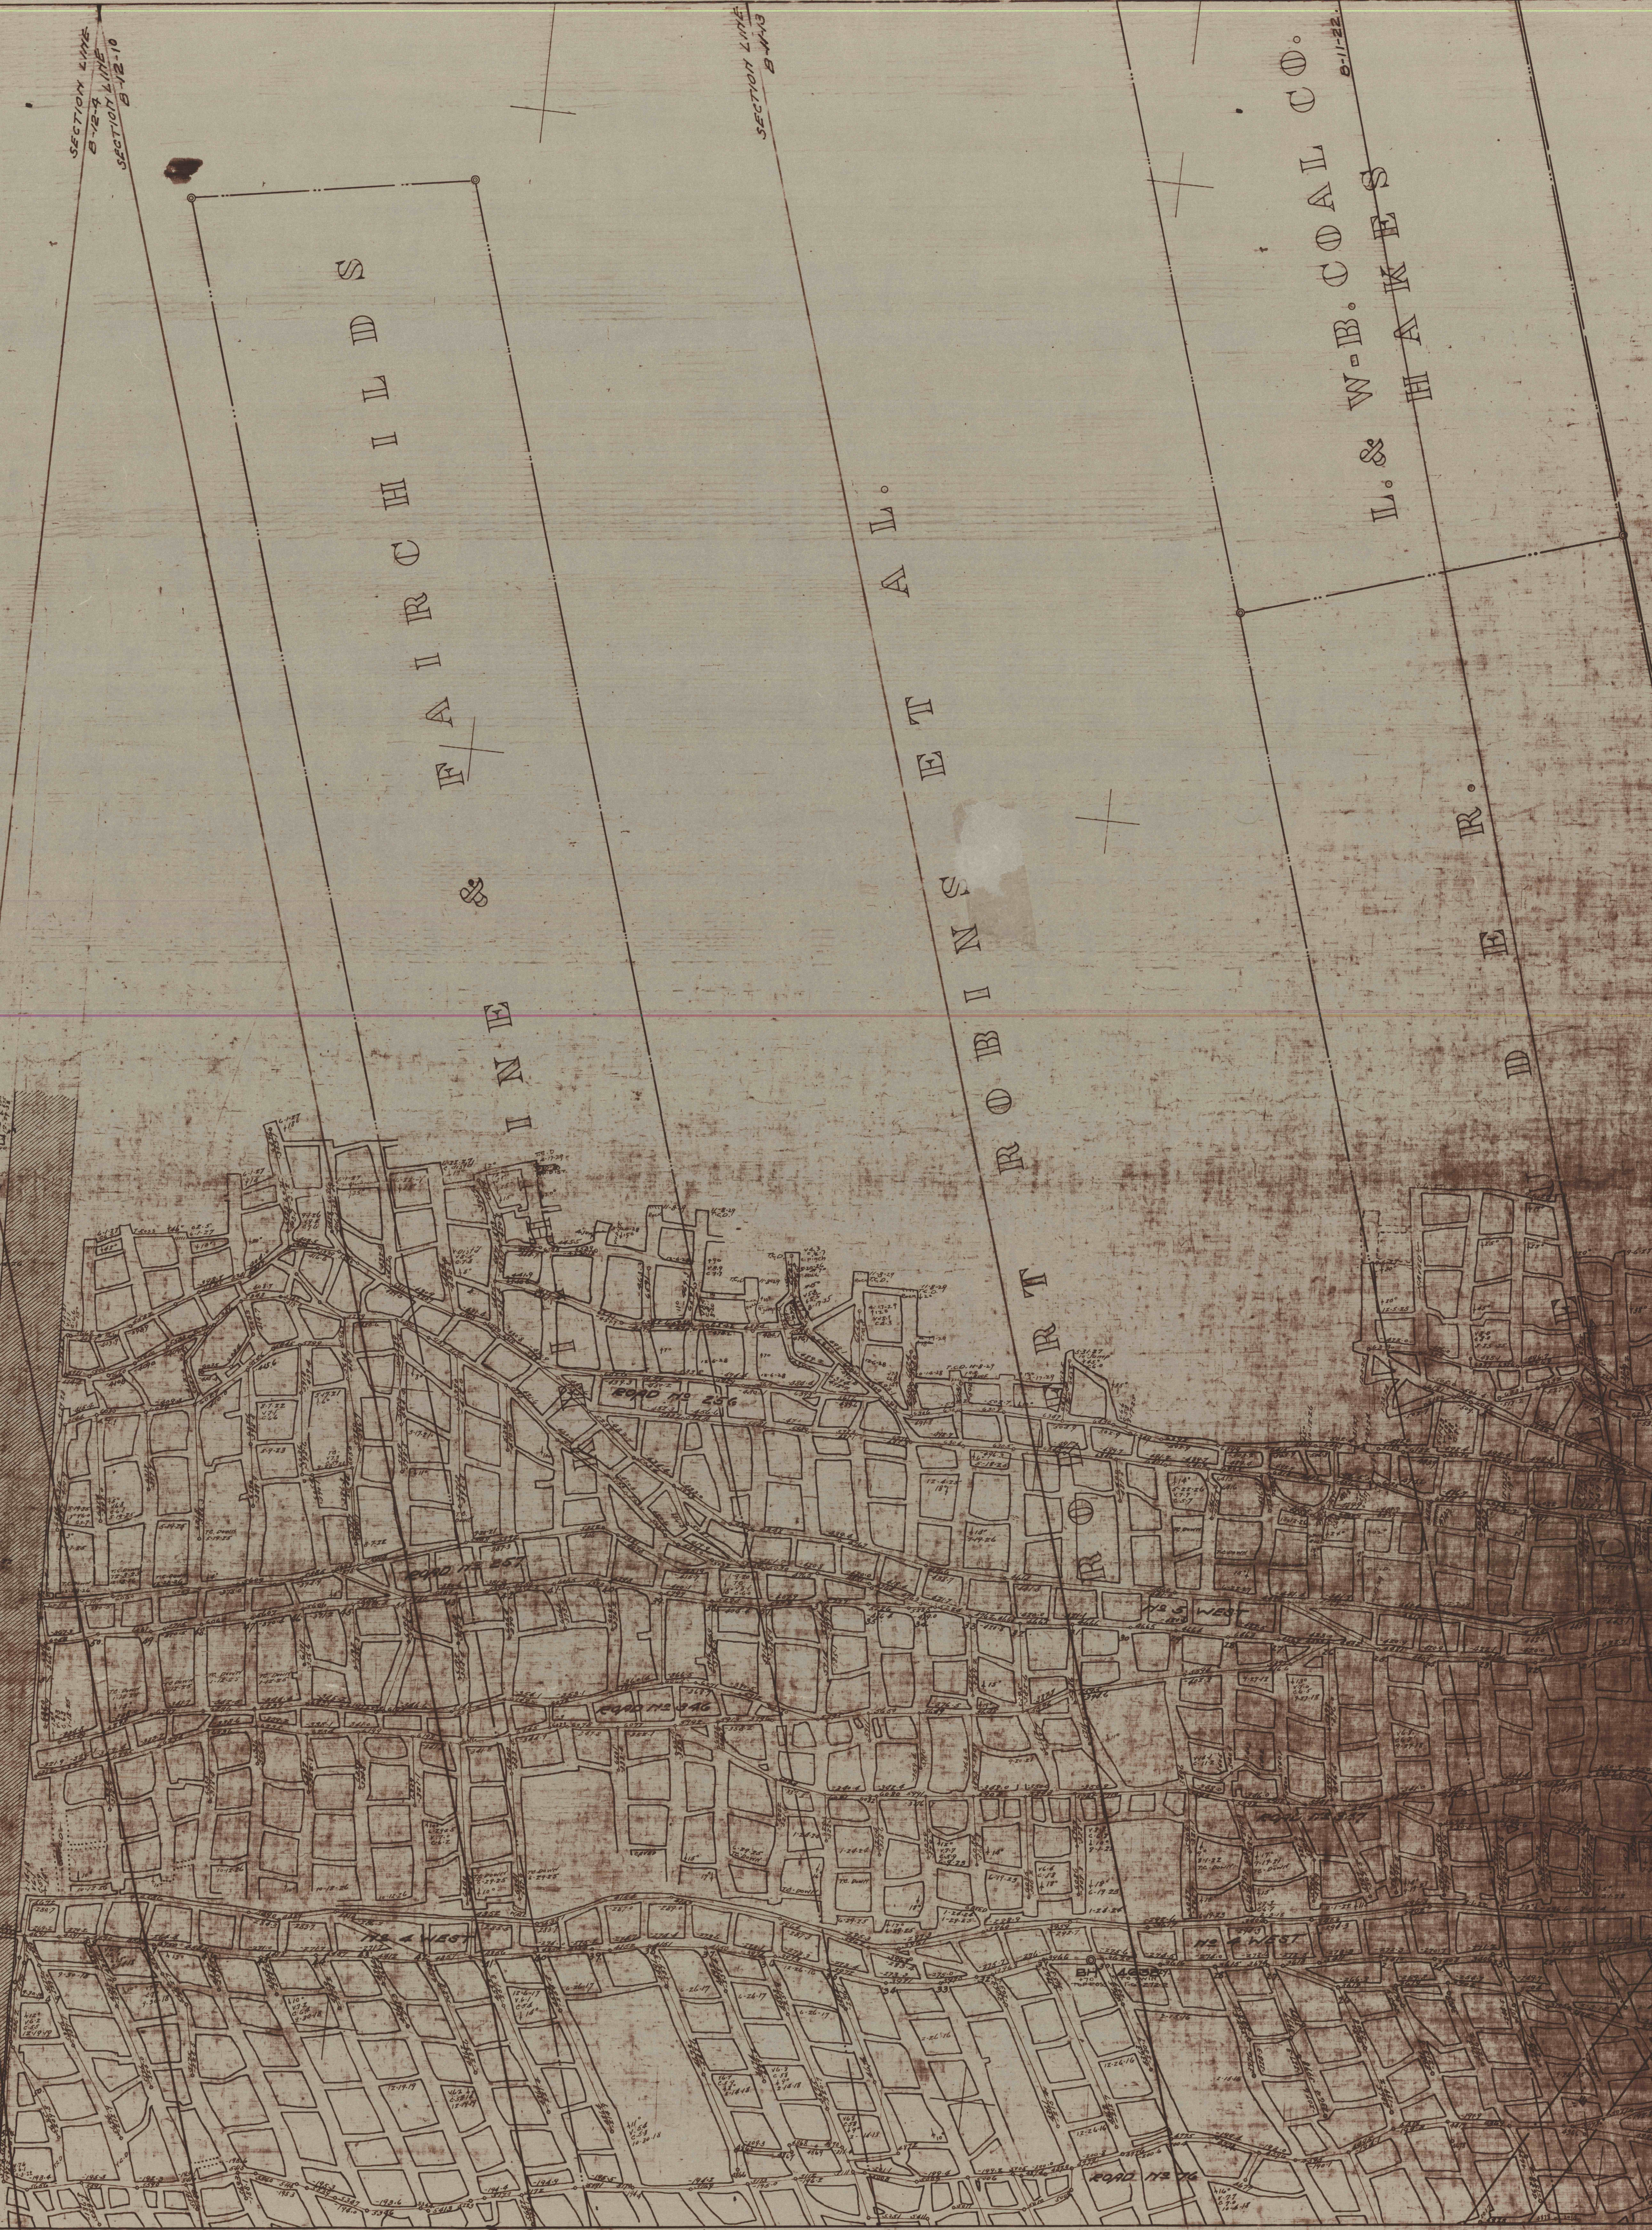

W-B-S-P-C-O-L

FAIRCHILD'S EXAMINE LINE

ROBBINS ET AL.

L. & W-B. COAL CO. WAKES

WASHINGTON LEE No. 3

SECTION LINE B-12-9 B-12-10

SECTION LINE B-12-9 B-12-10

TRACING NO. 10

TRACING NO. 10