

HENRY BARRKETT
J. R. LINNEN

L. B. LANDMESSER.


KEITH LINE & FAIRCHILD S.

ROBERT ROBBINS ET AL.

WASHINGTON LEE No 3.

L. & W. B. COAL CO.
HAKES

WASHINGTON LEE

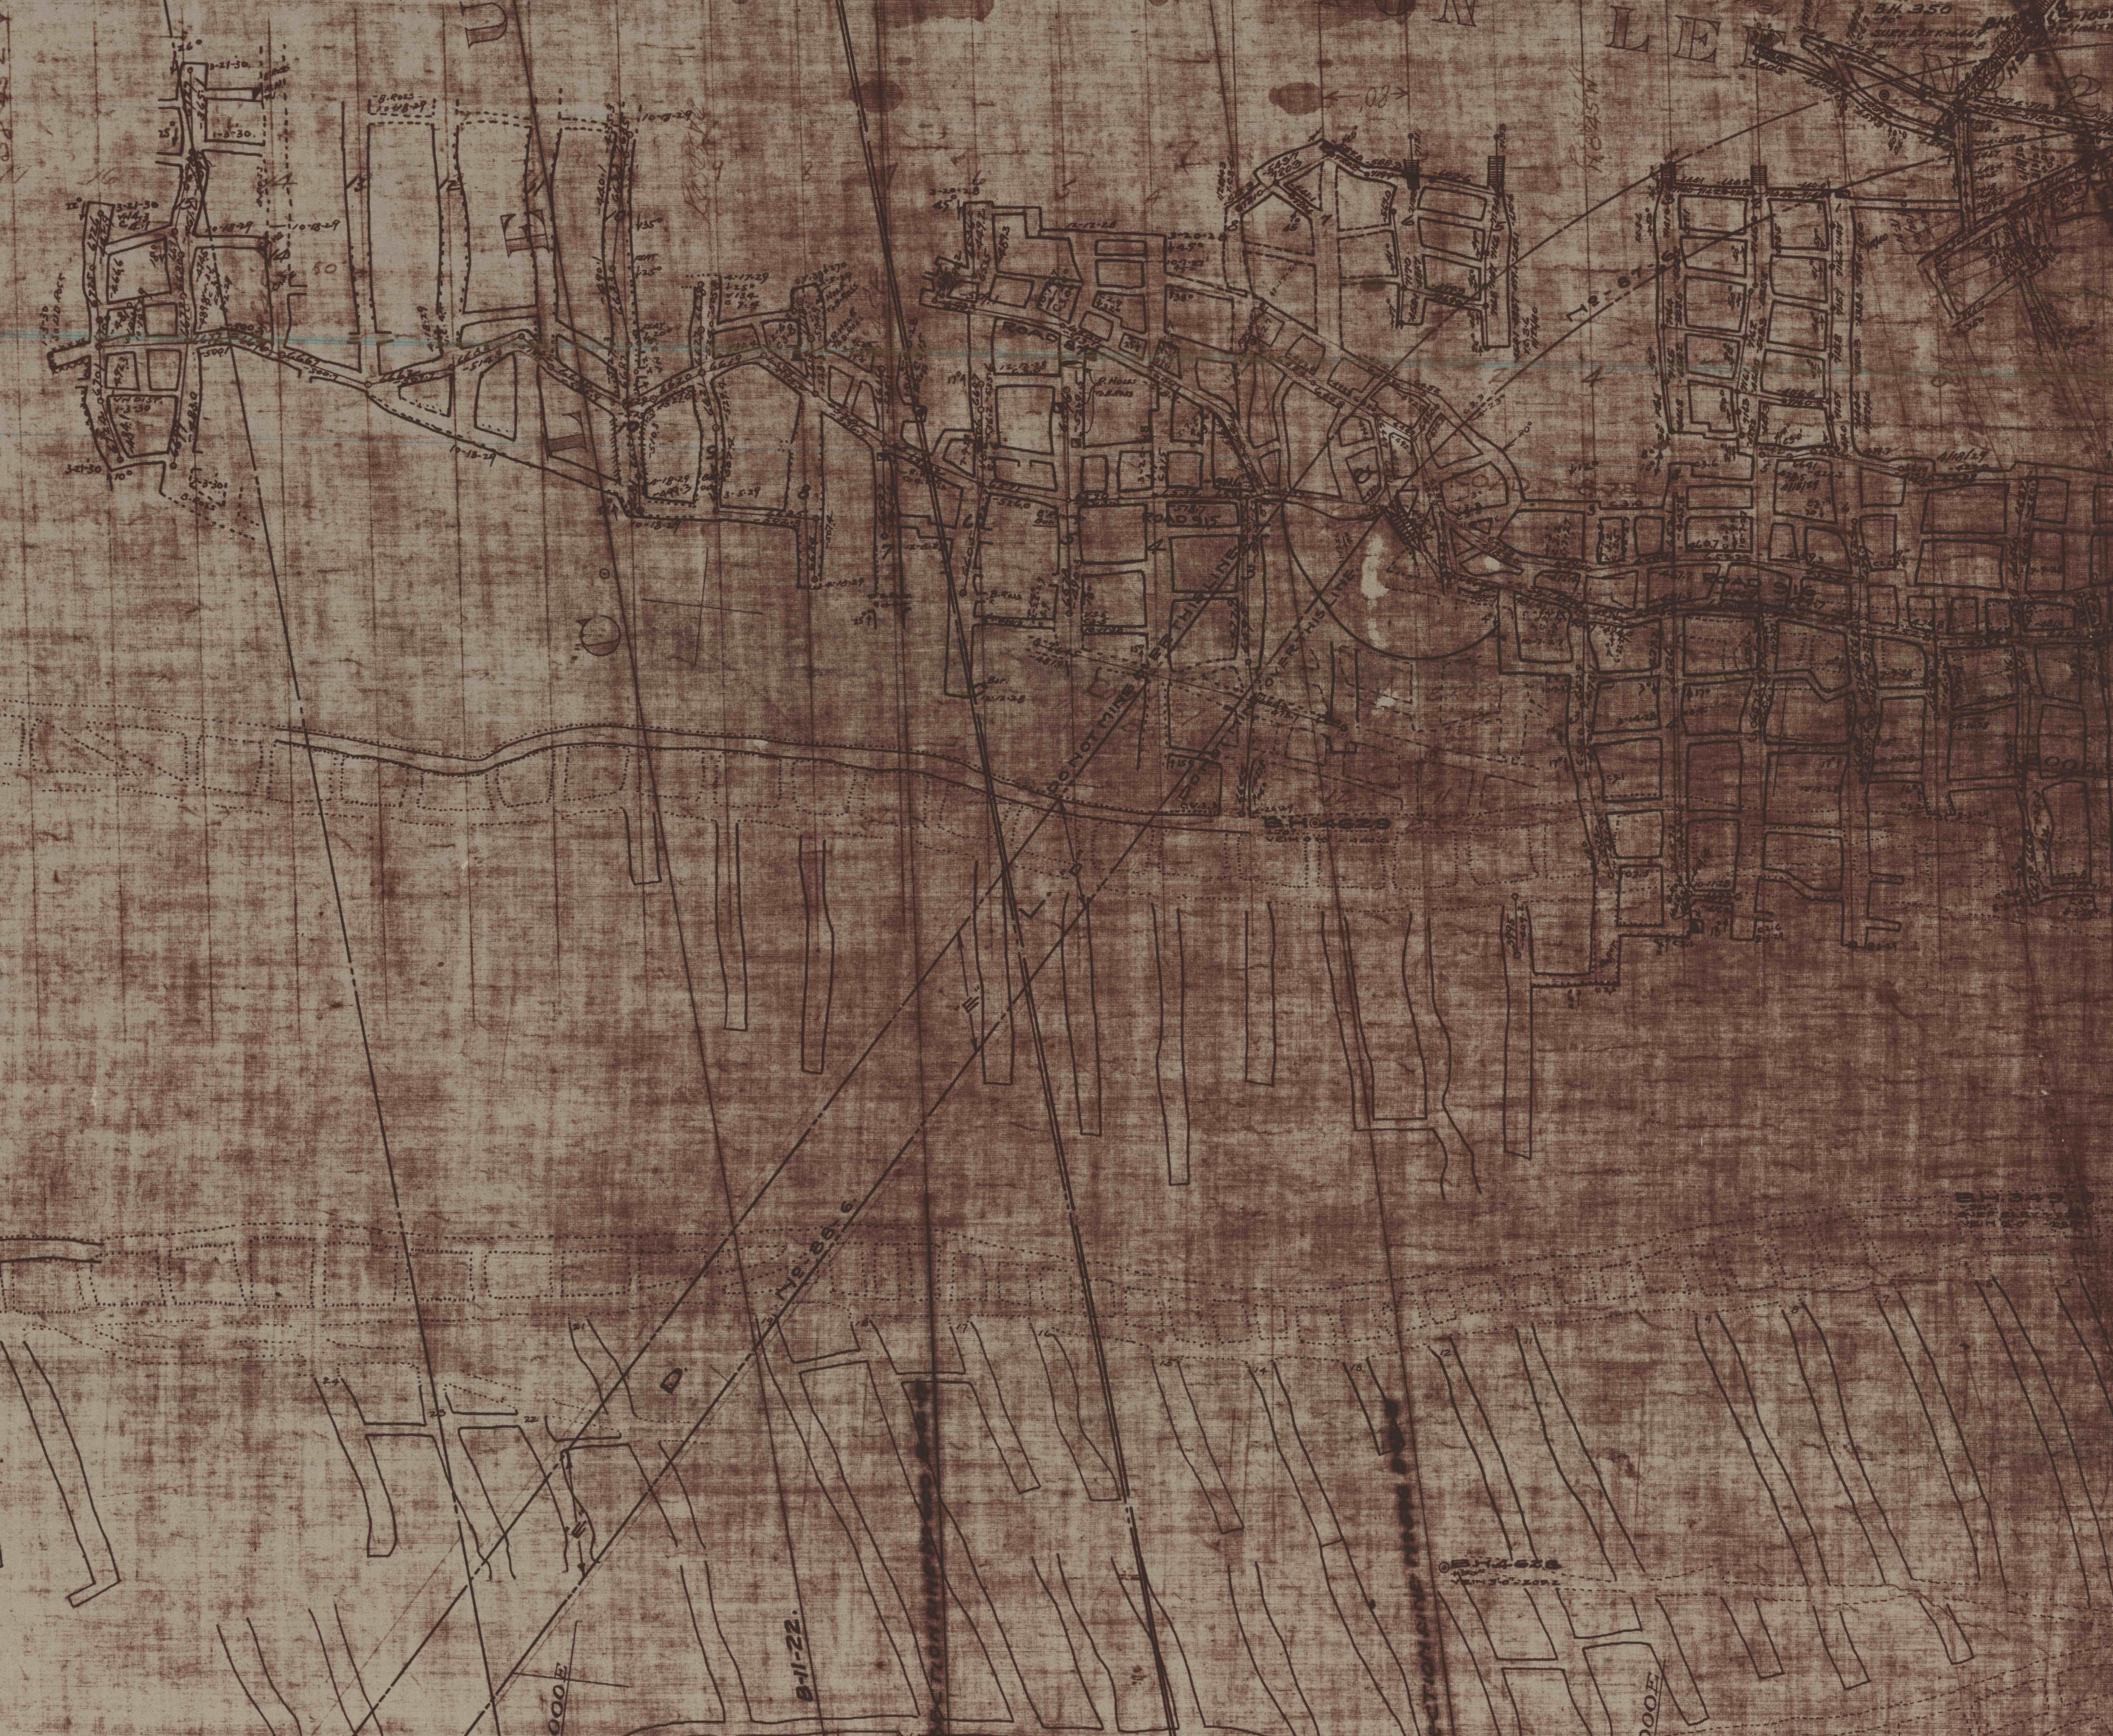

SECTION LINE NORTH 81-1-1
SECTION LINE NORTH 81-1-2
