


NE. 3

B. COLL CO.
PELLO

THOMAS P. COLLINGS

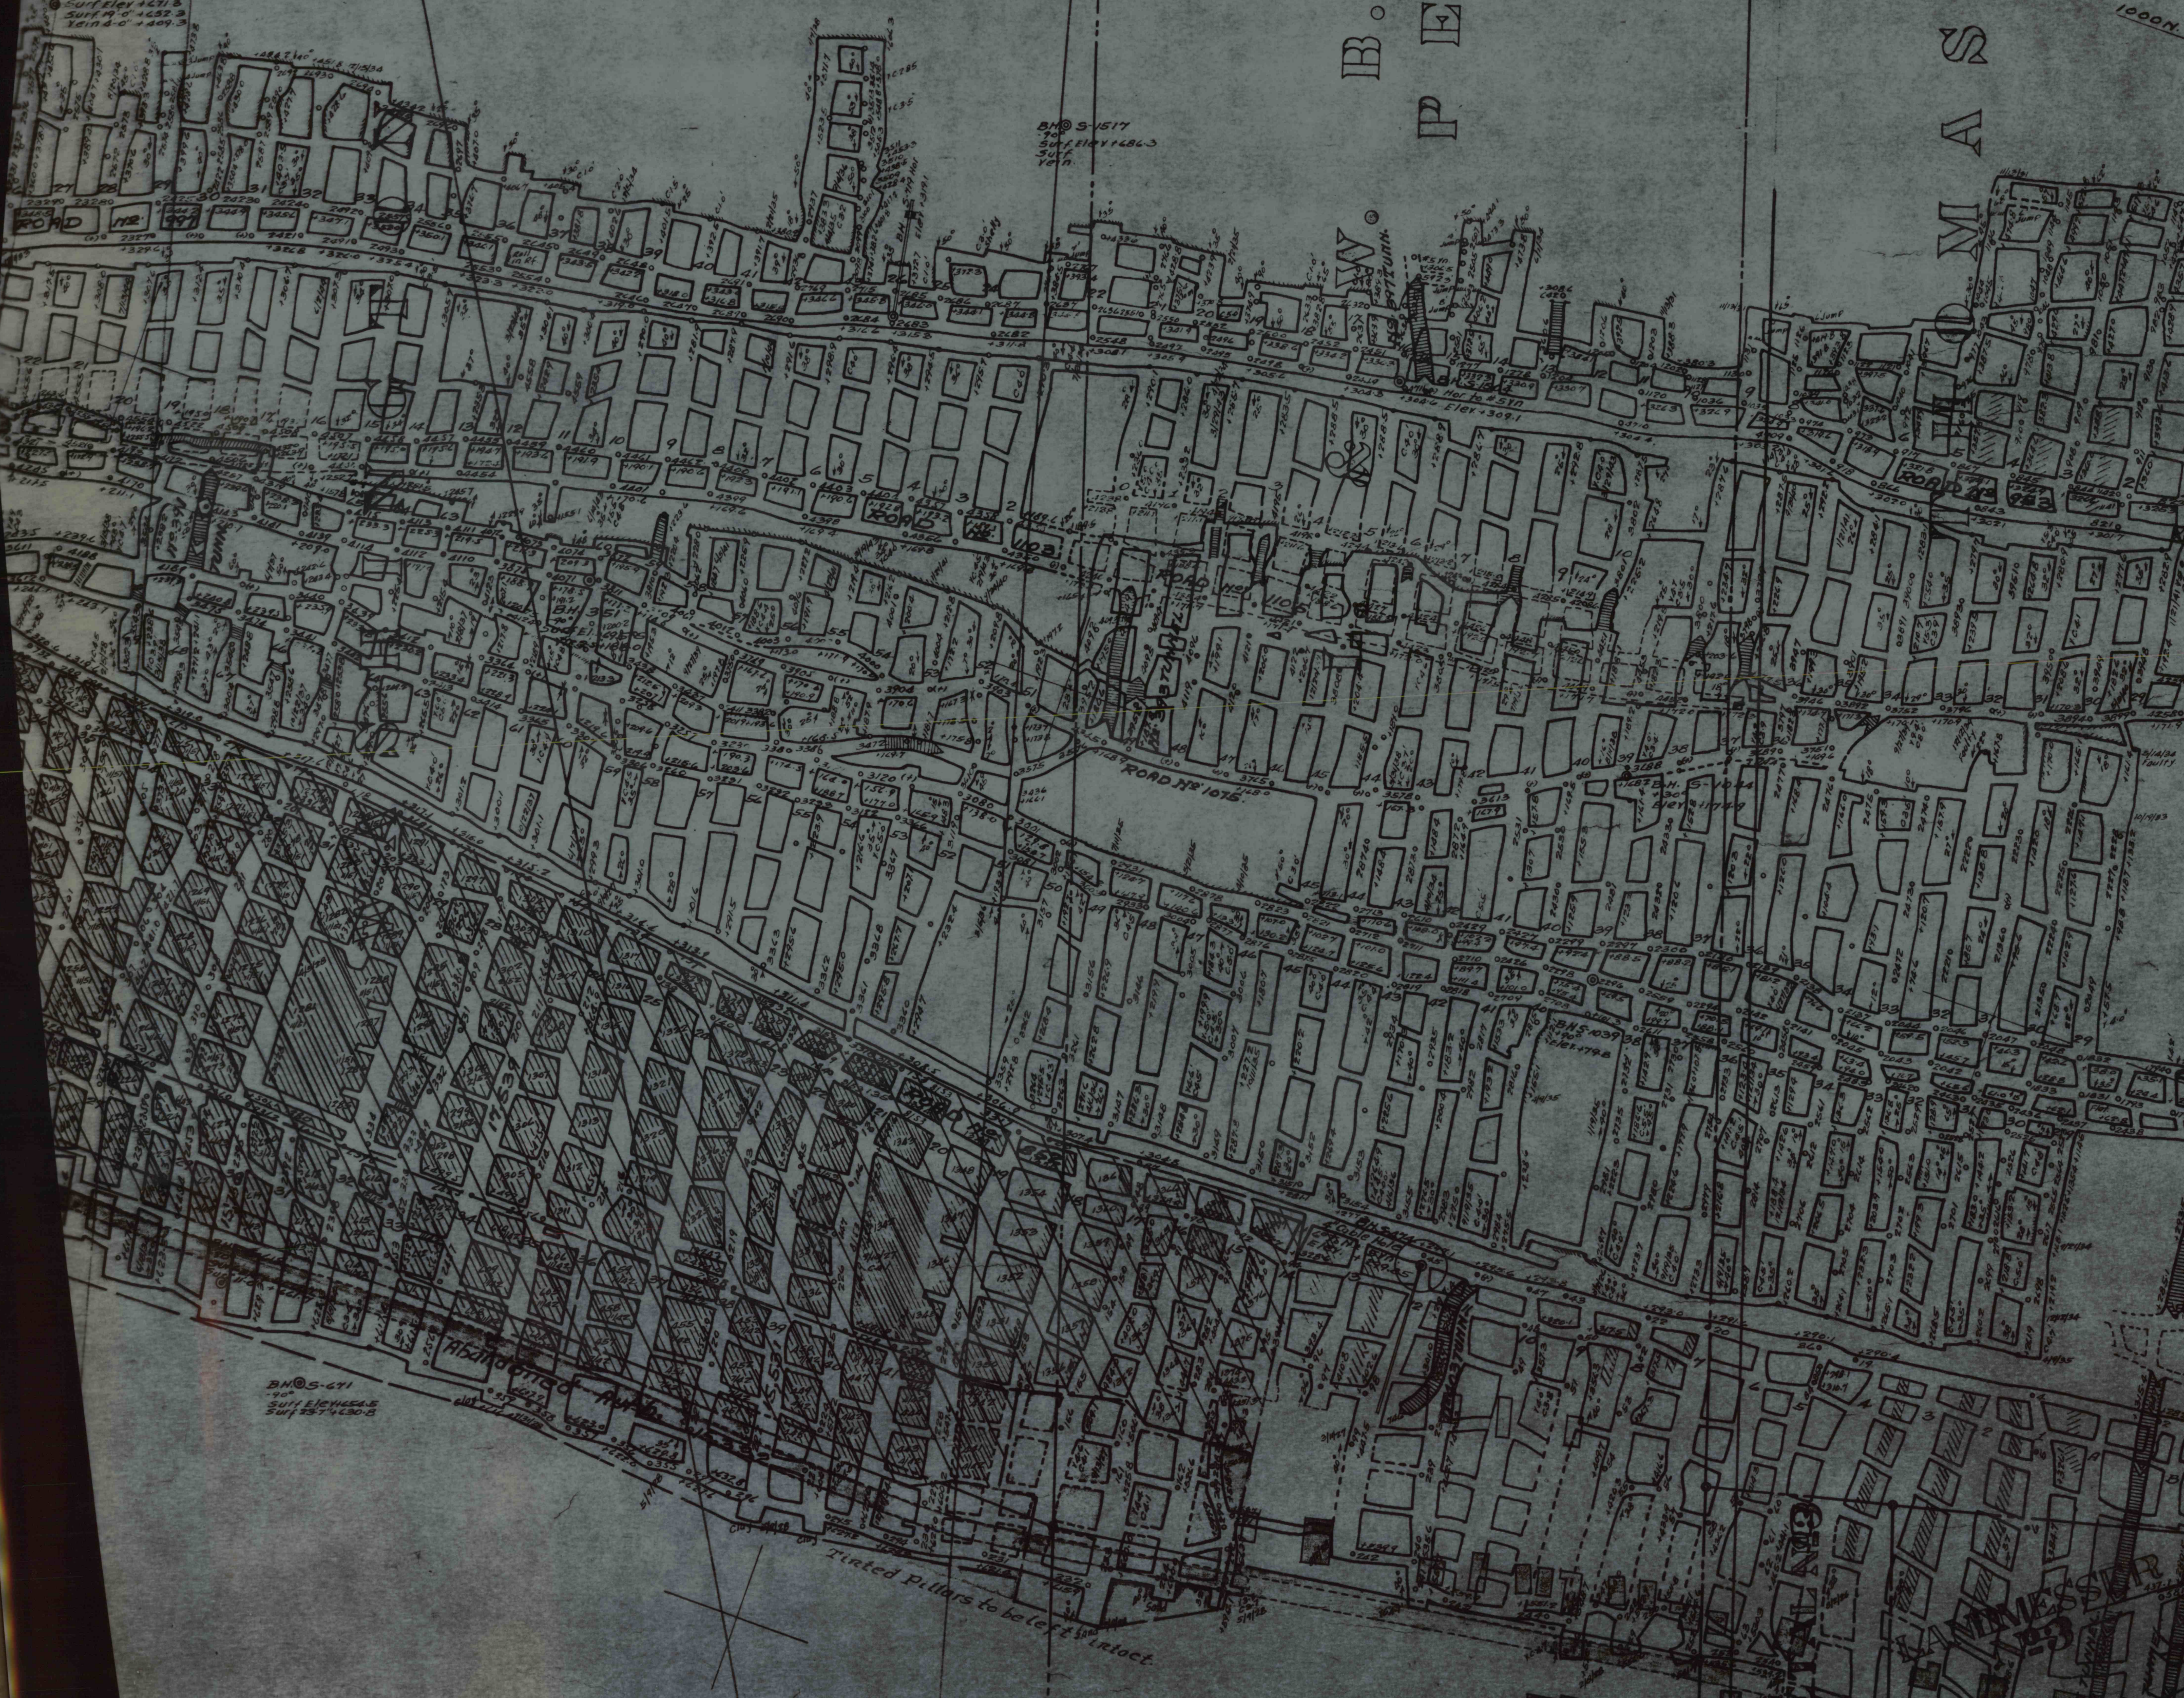

B.M. 5-718
 3071.21 + 471.3




WILKINSON LEE No. 2 T. BEAVER

KEITHLINE No. 3

NO. 4 - VEIN

NO. 5

NO. 5