

NO.14

TRACING NO. 10


TRACING NO. 13

TRUES LAST PILE/CR NO. 16

ABBOTT VEIN

TRACING NO. 14

NO.14

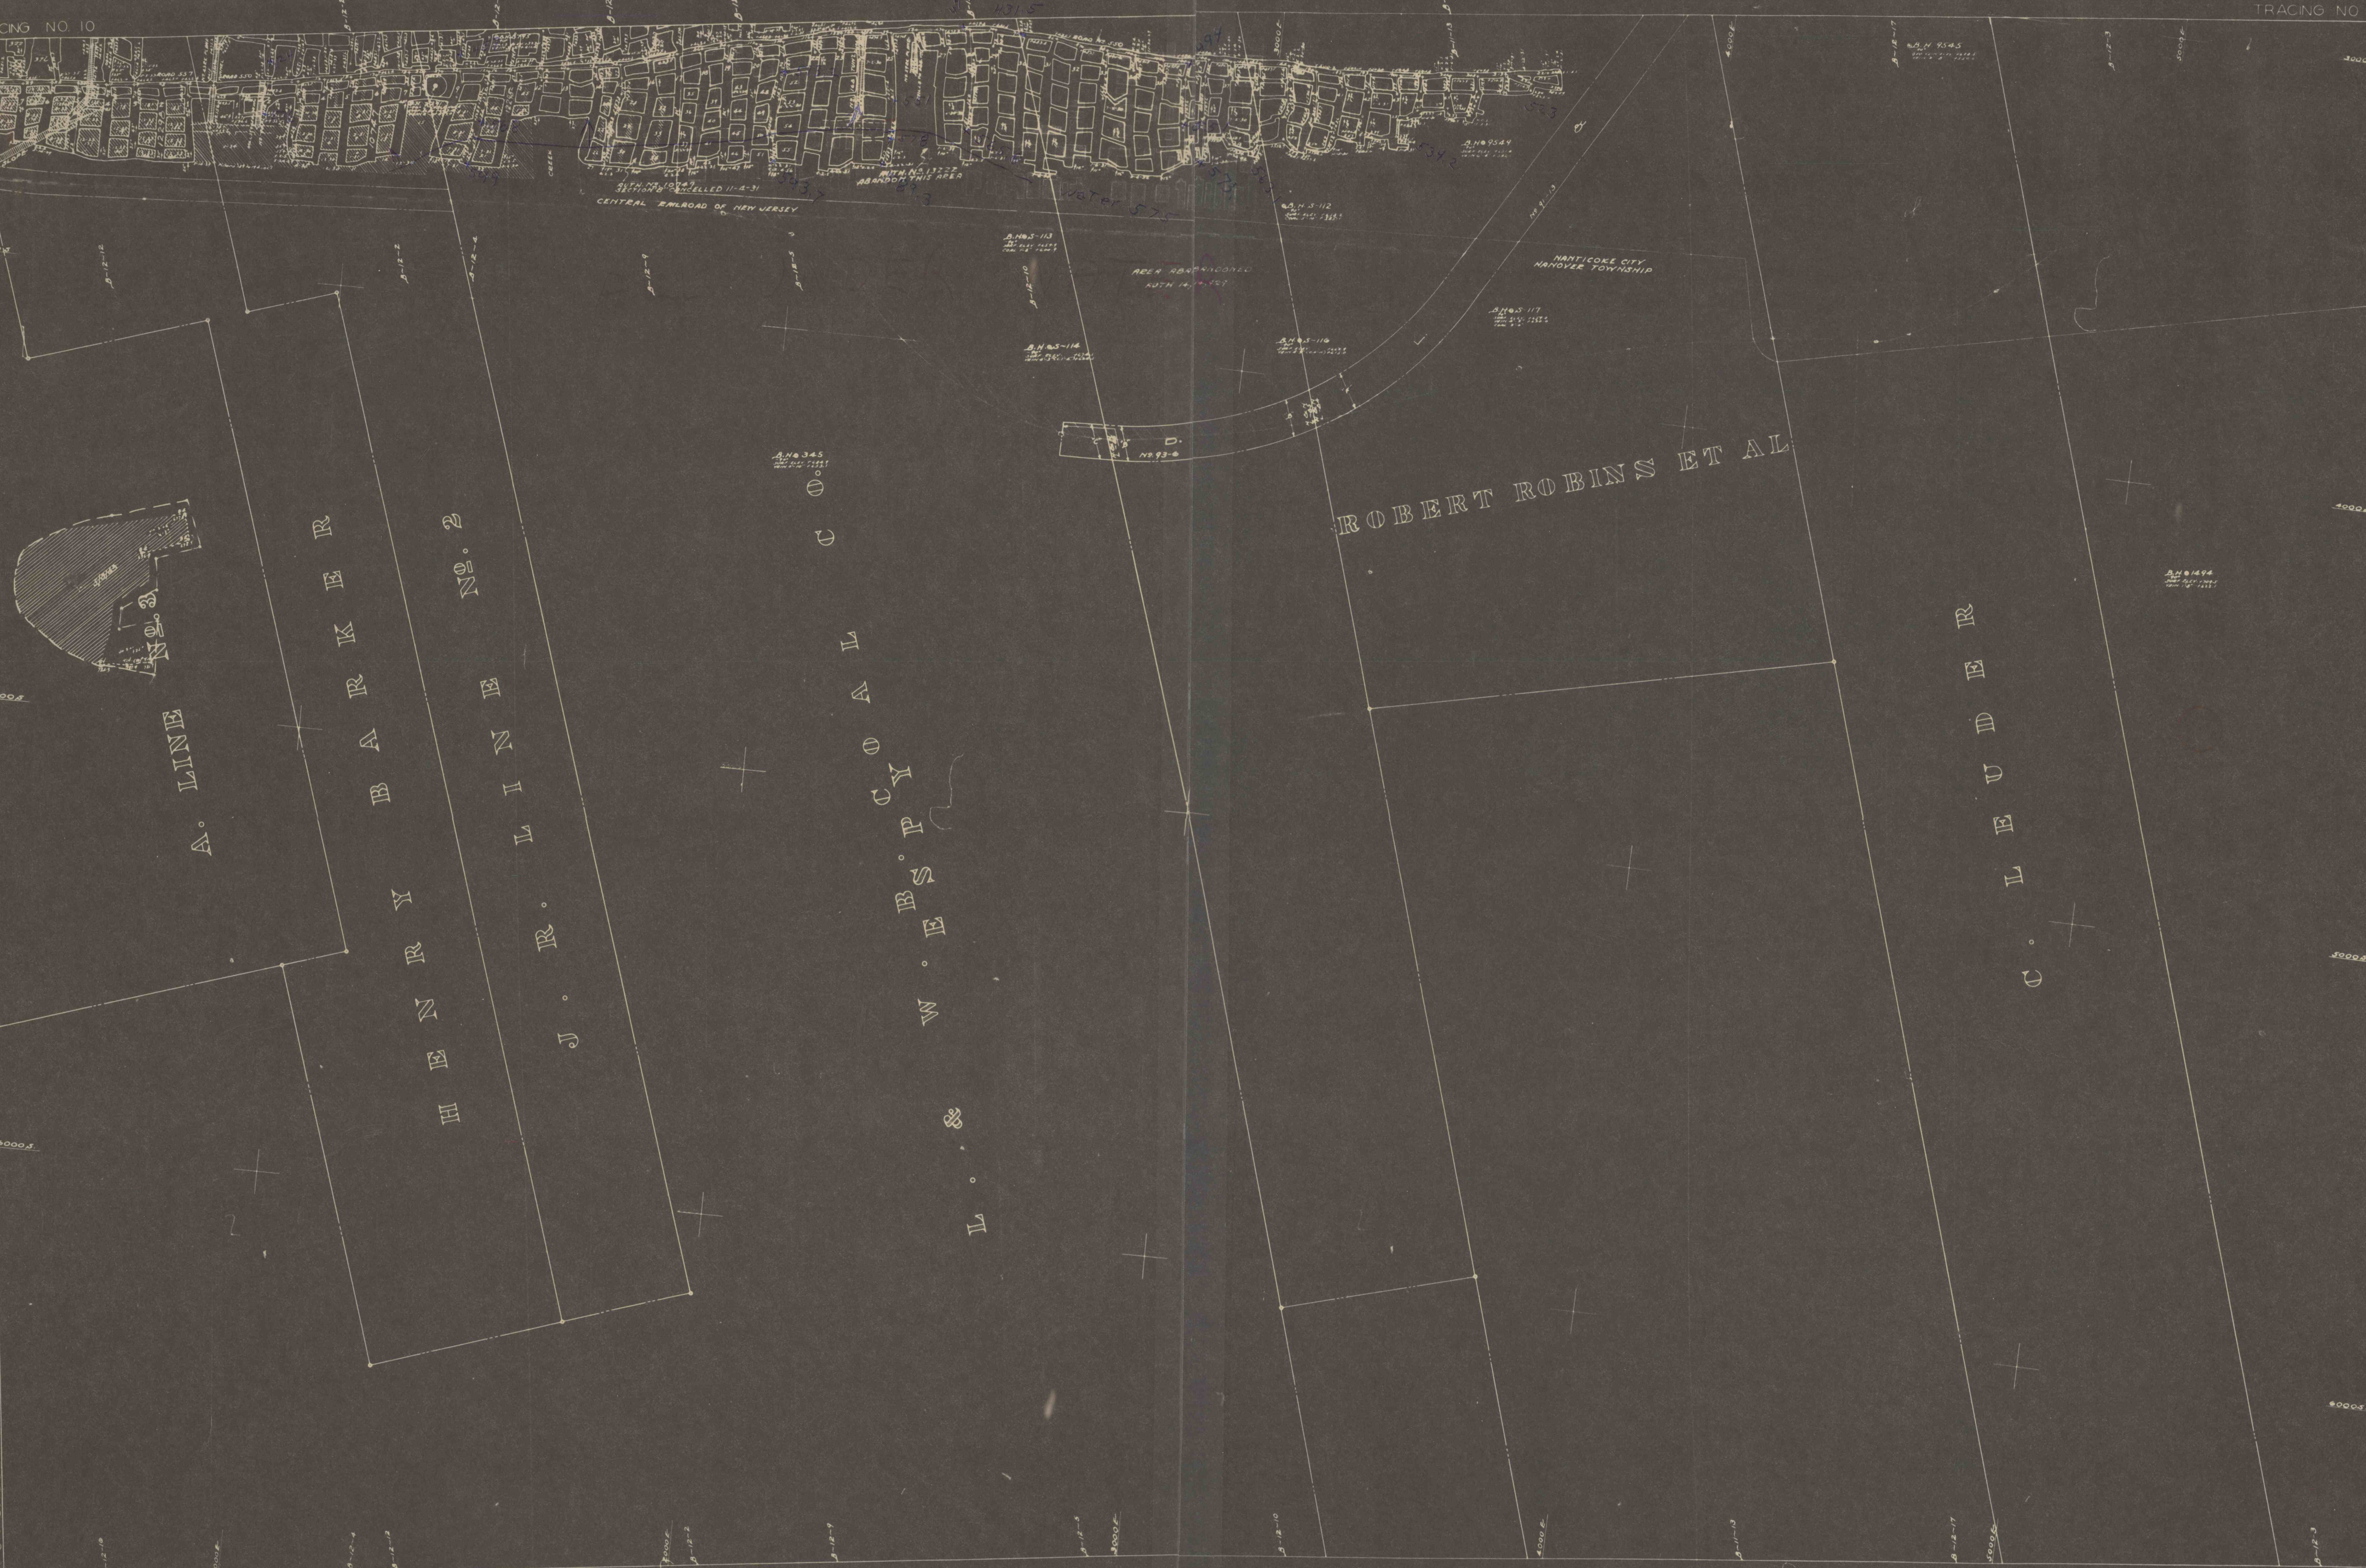

TRACING NO. 10

TRACING NO. 15

NO.14

ABBOTT VEIN

TRACING NO. 15

NO.14

1 | N/O | 1 - | 0 3 8 | 1/2 - | 100 | 30