


HOUSE

OUTLINE OF CULM. DUMP

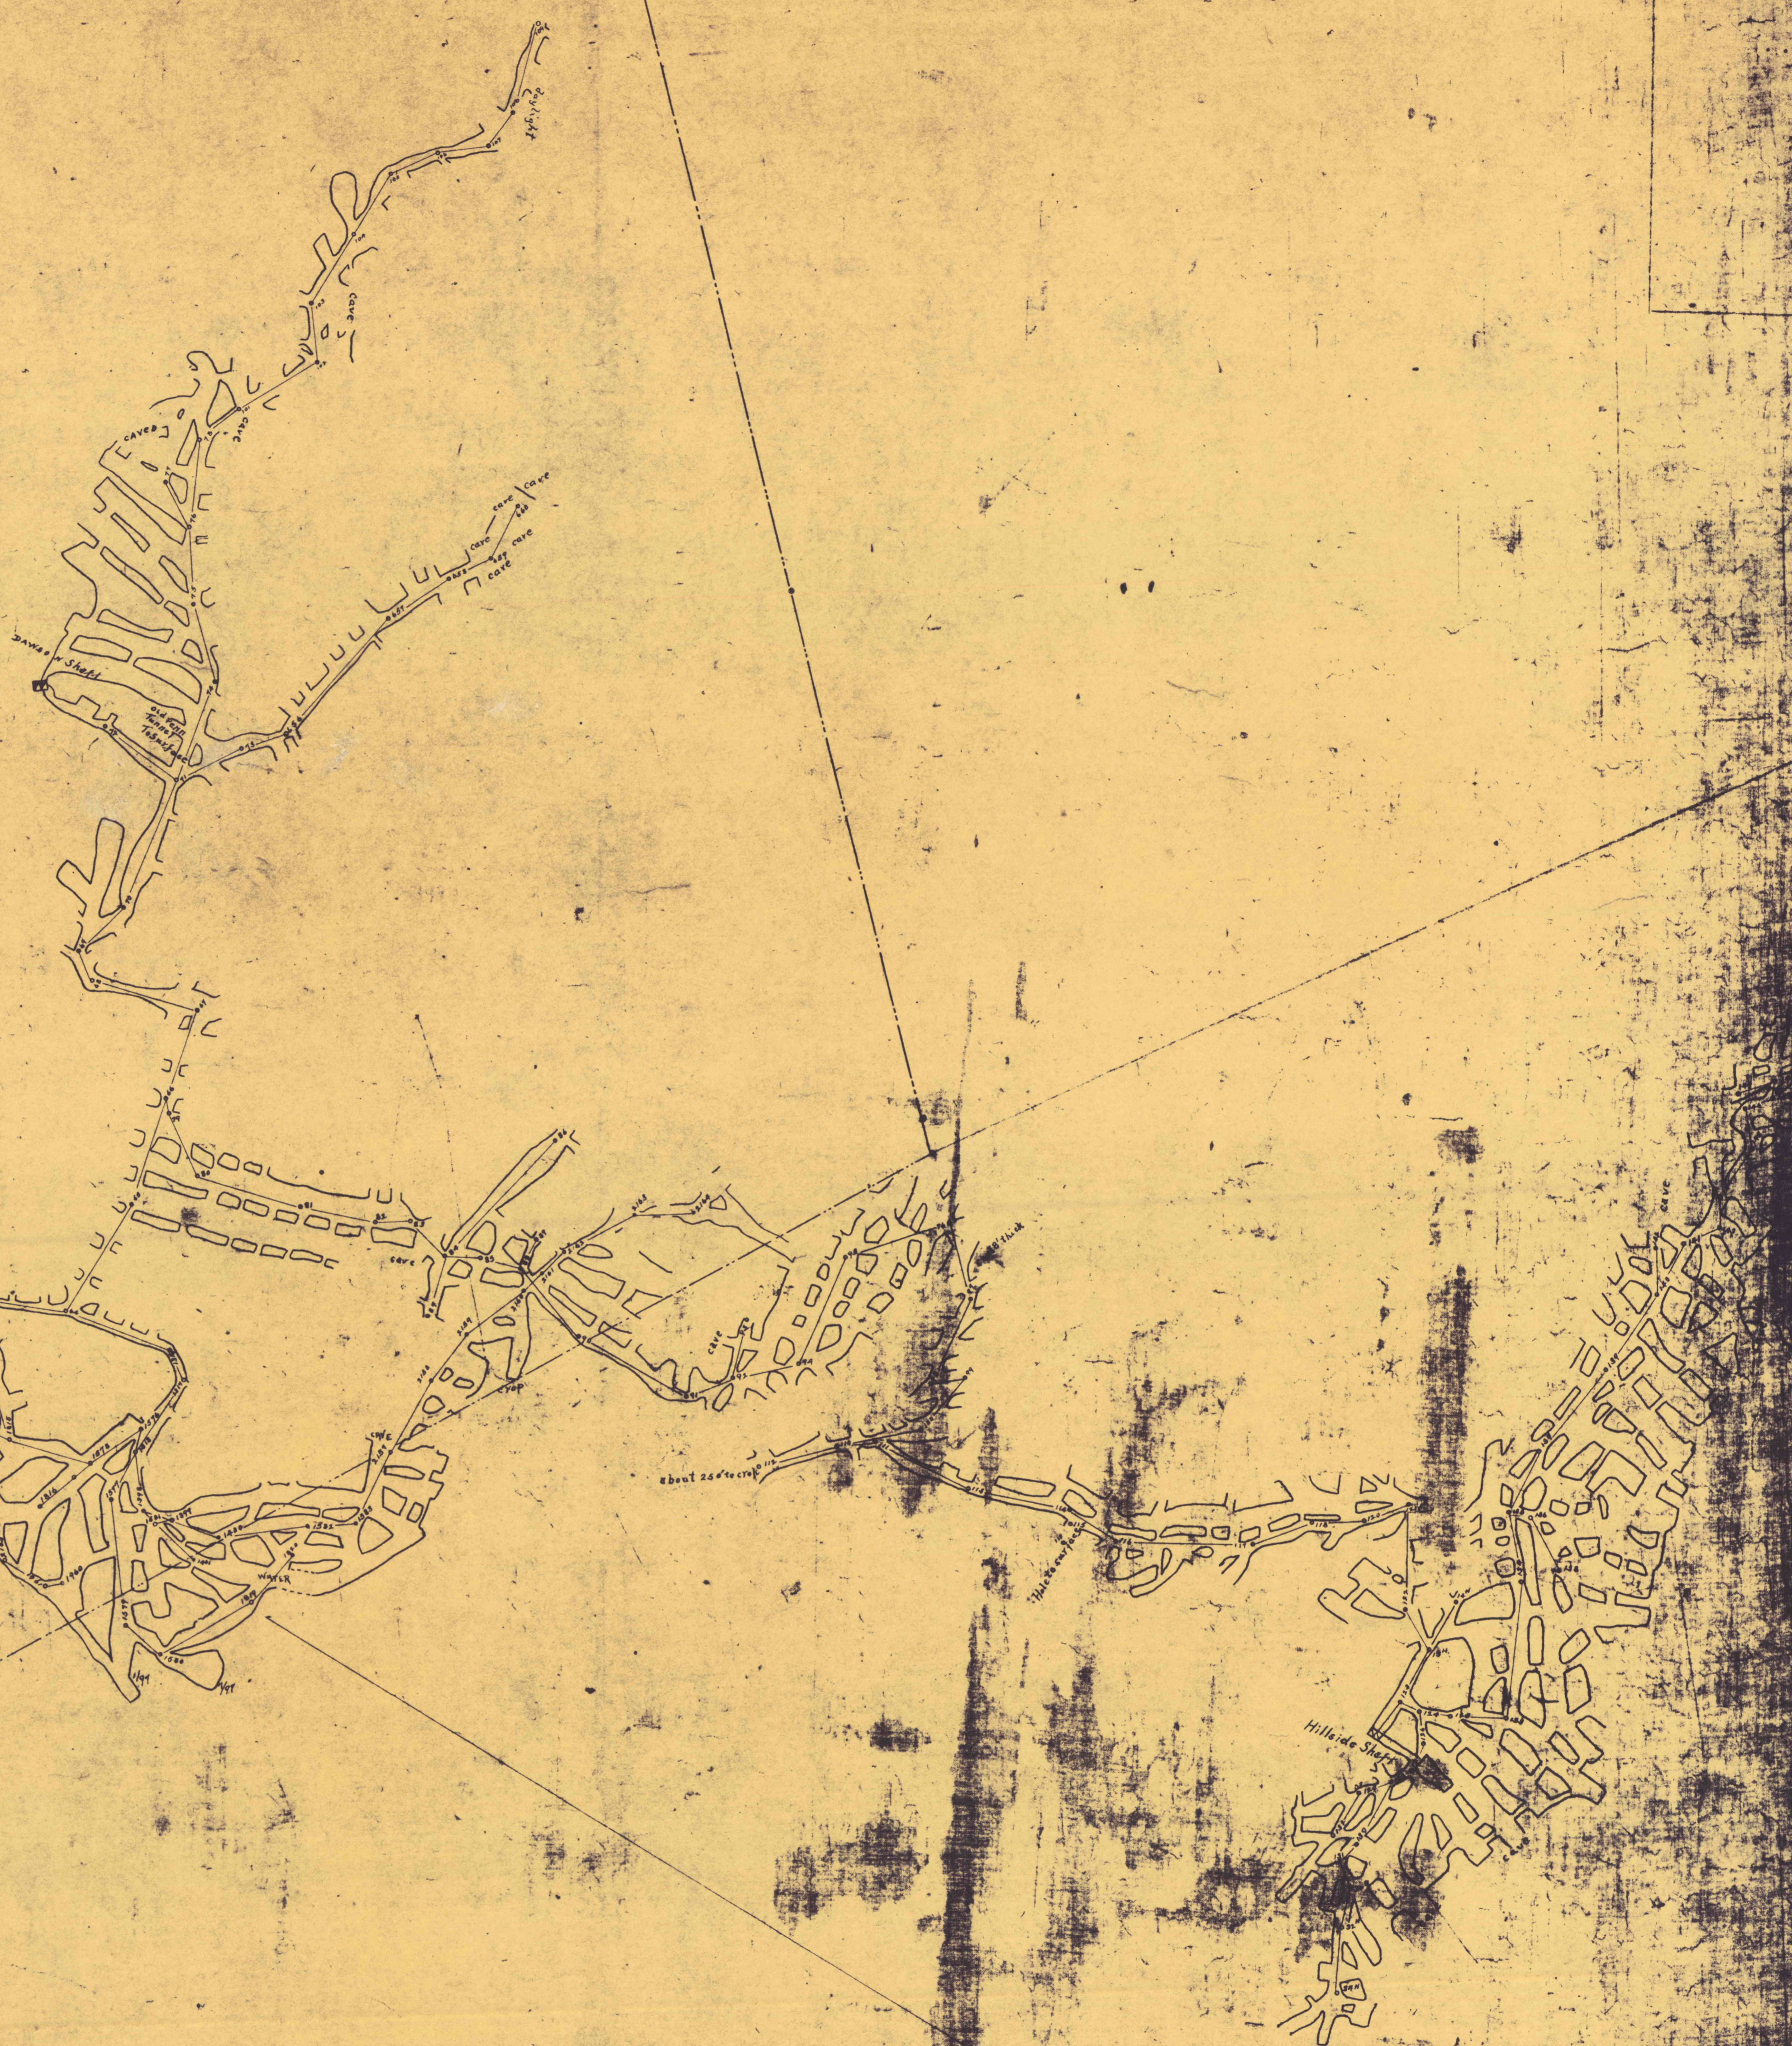

MARCY VEIN
 OF
LANGCLIFFE COAL CO.

AVOCA.

Scale 100' = 1"

Naught P-714