


#128 Dura  
#2-A  
#128 Dura - Checker Dept

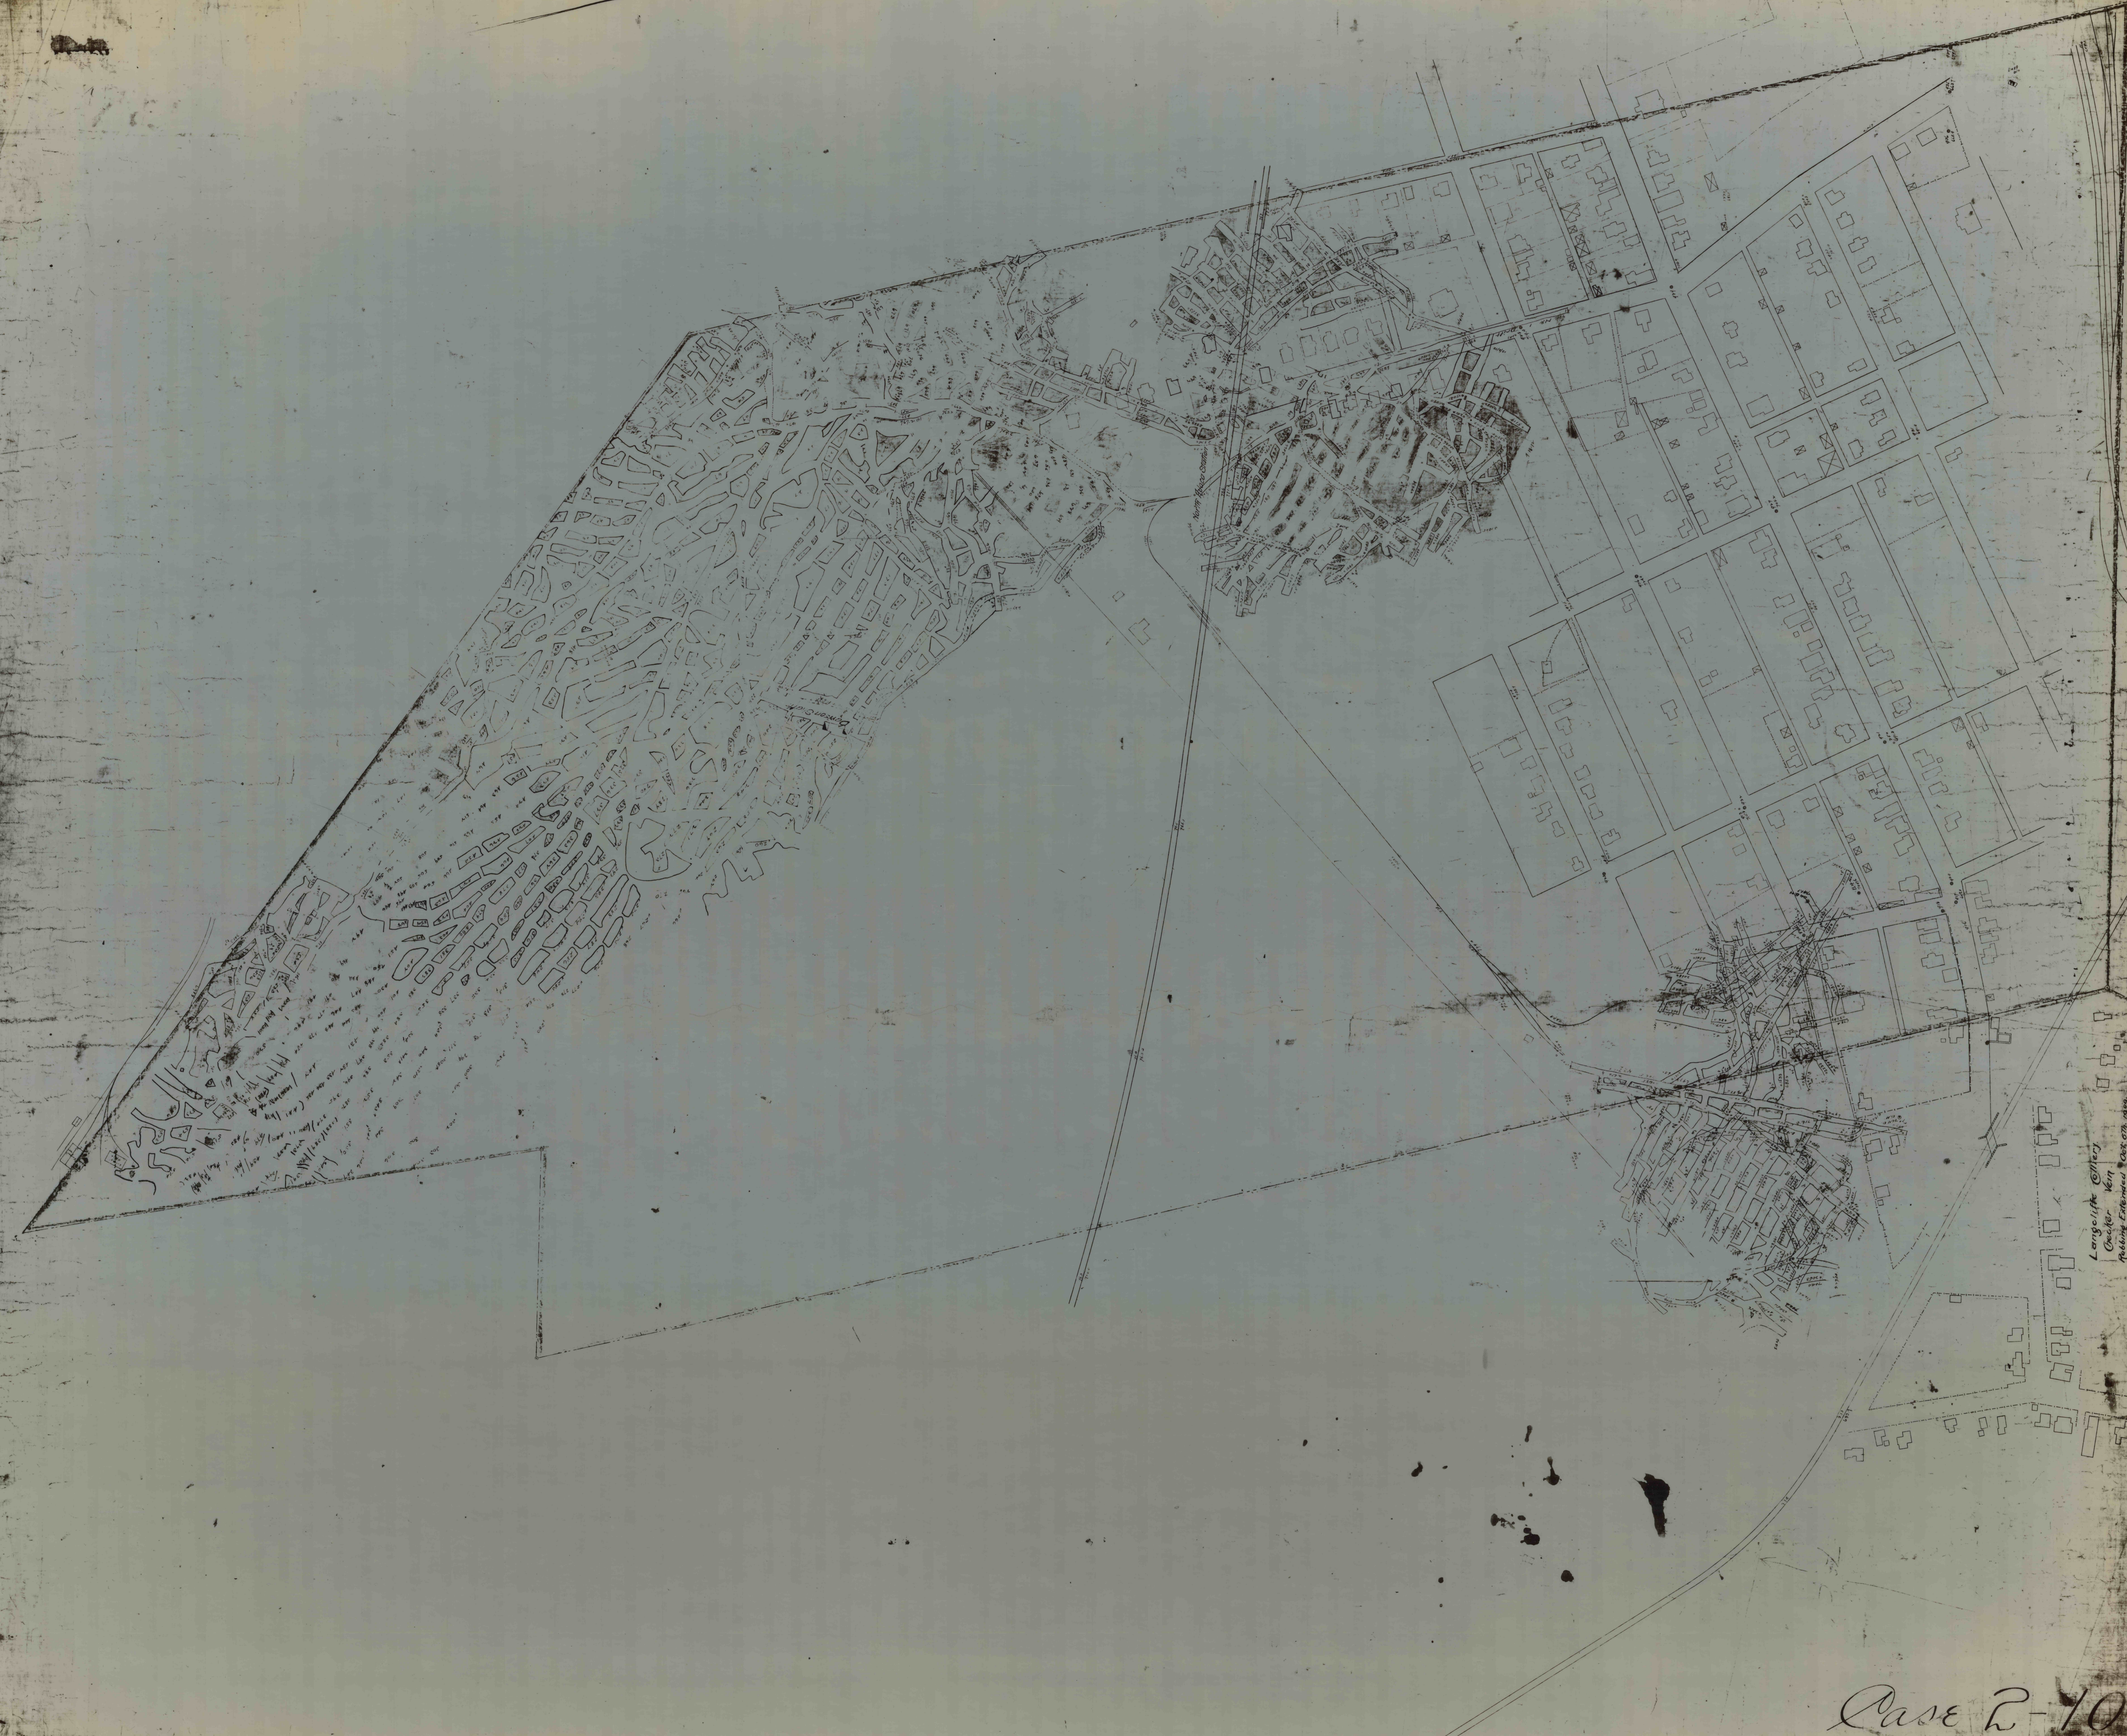

Checker Dept  
July 27, 1877

#128 Dura - Checker Dept


