


2-15 Langcliffe Coal Co. March Bed

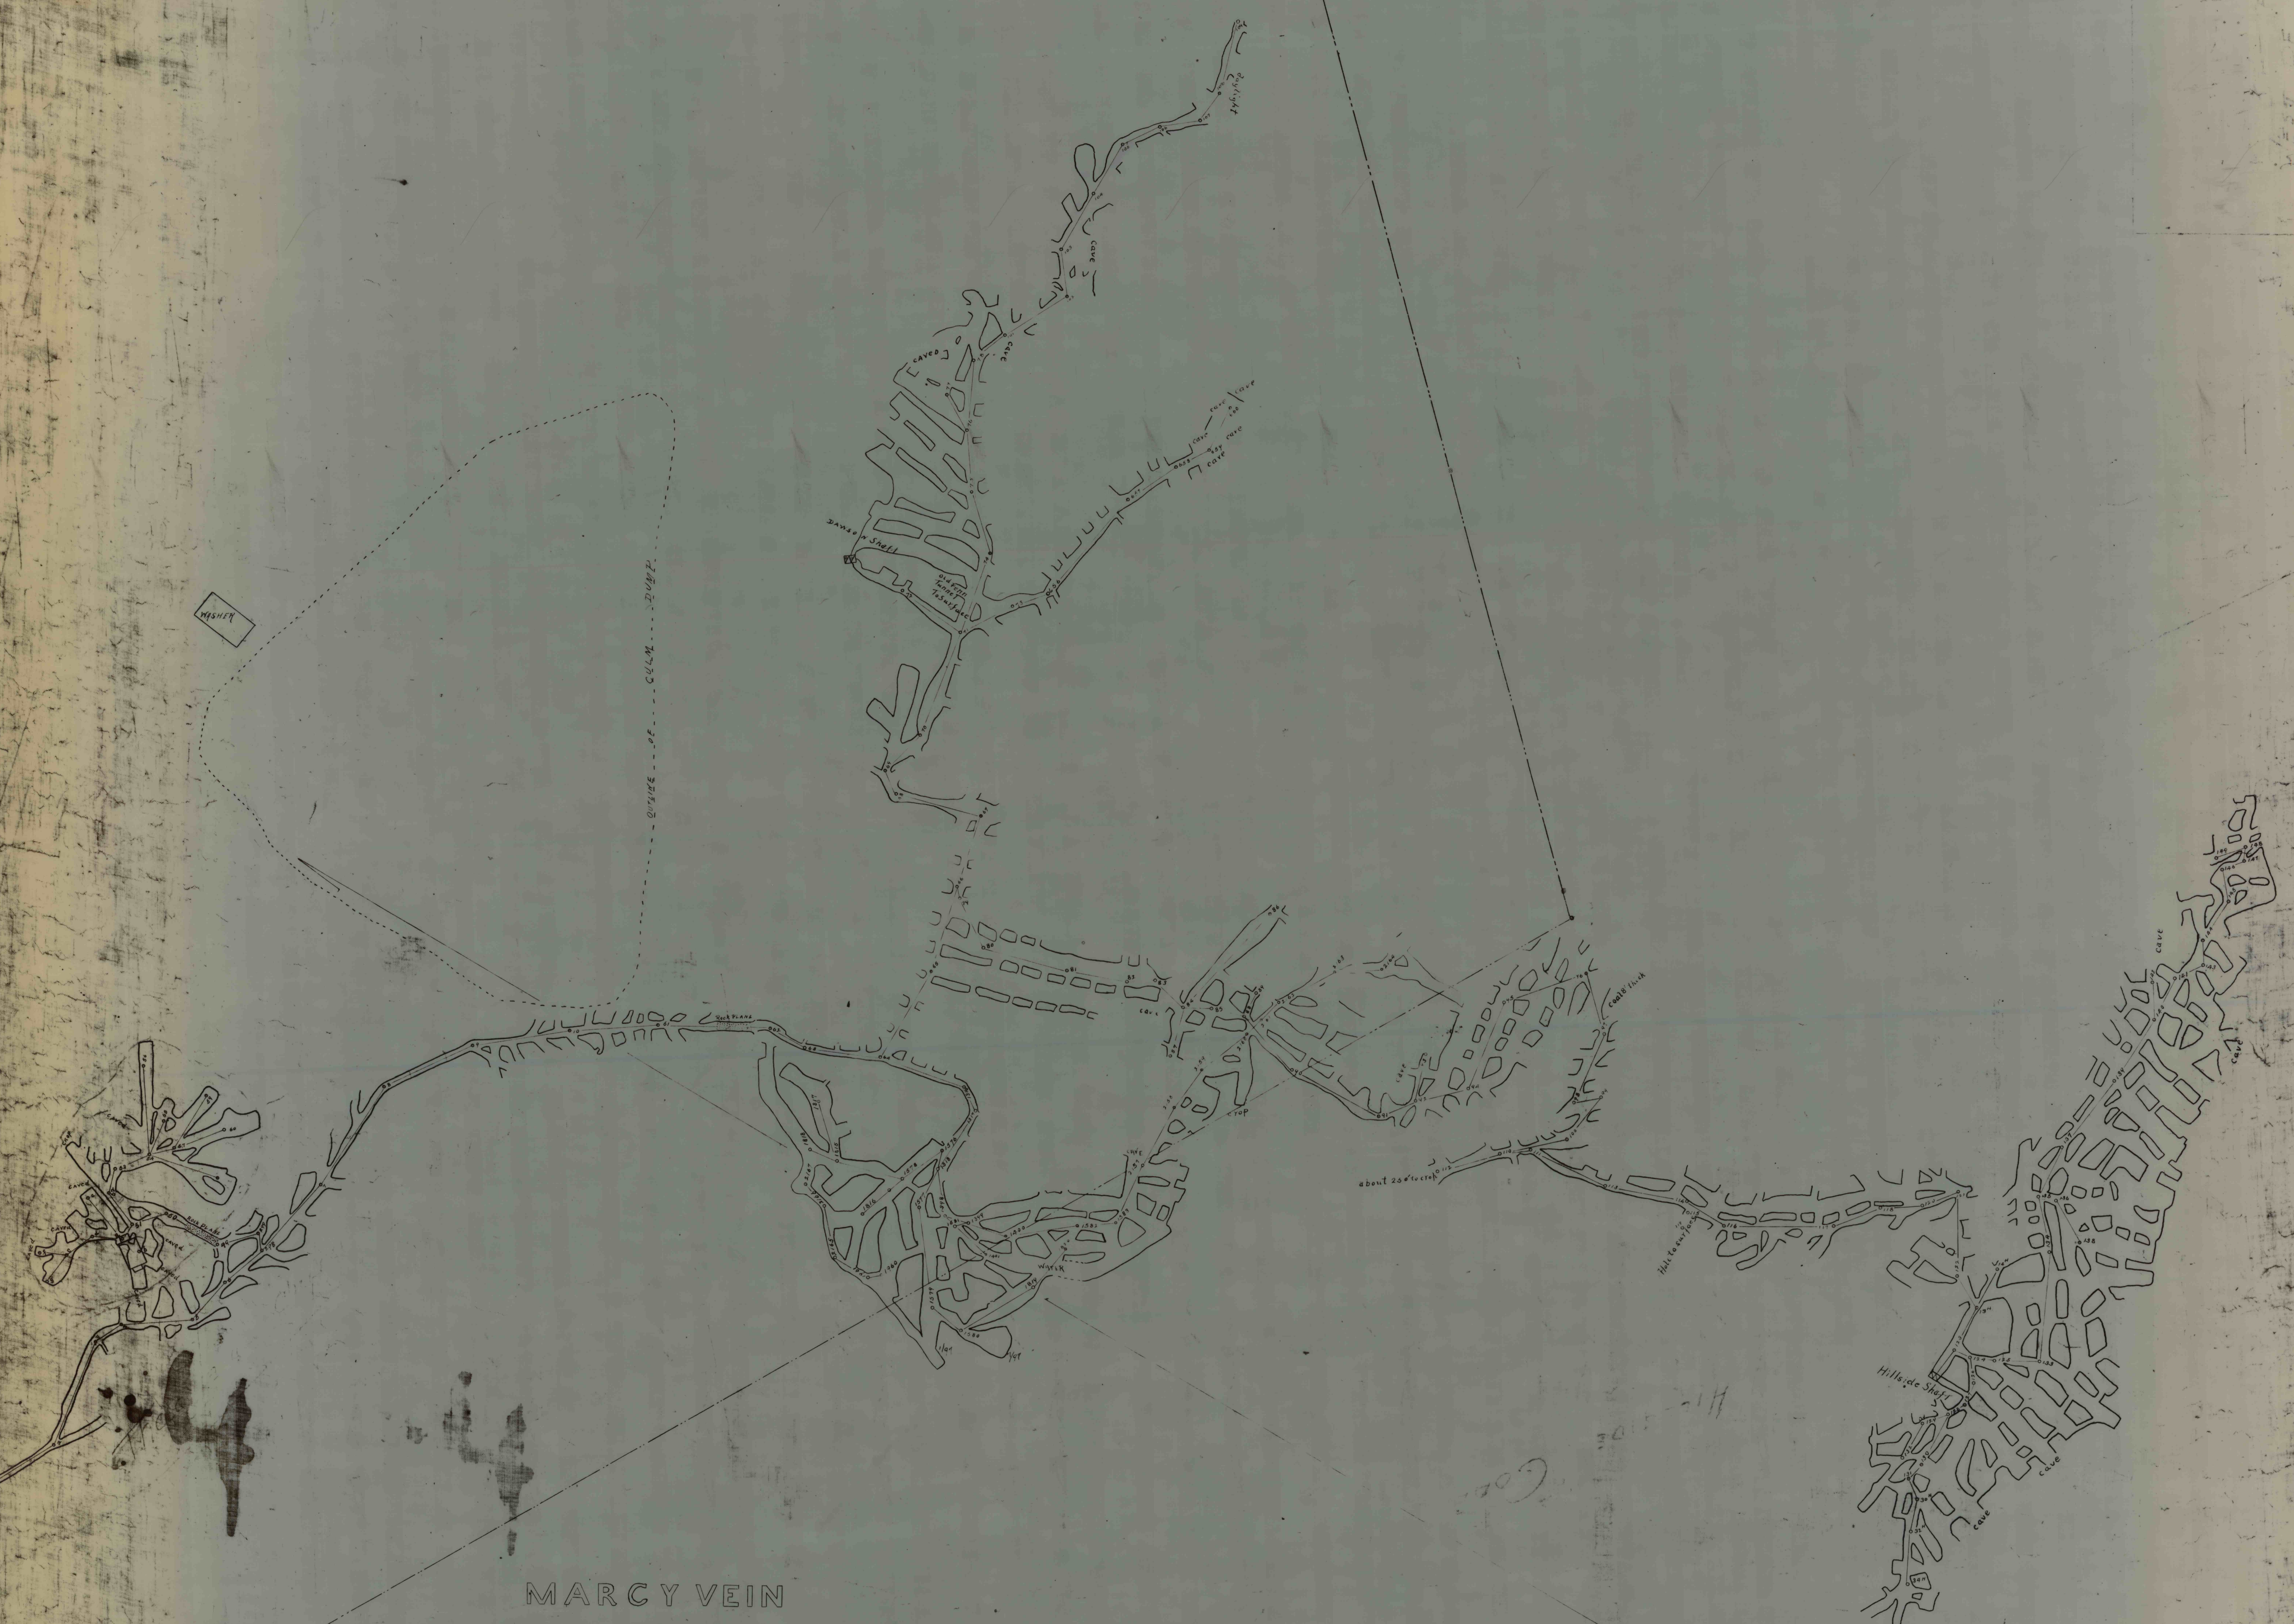

MARCY VEIN  
 OF  
**LANGCLIFFE COAL CO.**  
 AVOCA.  
 Scale 100' = 1"

Vault 2-714