


RCHEMENT 1919

2-B/210

3-B/210

4-B/210


627.02

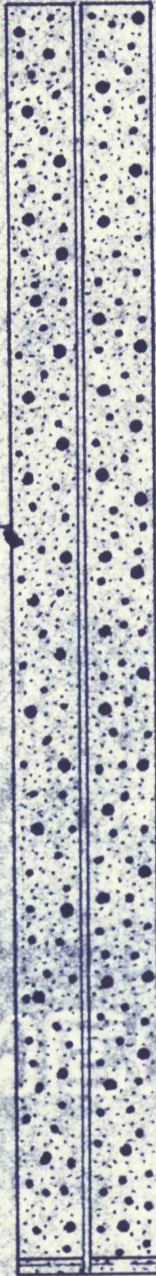

65-3/2 Surface

0-9/2 Rock

635.45

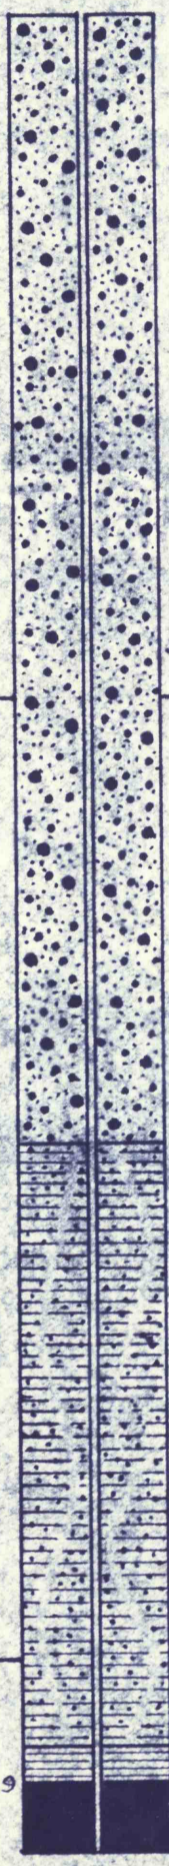

58-9 Surface


31-3 Rock (hard)

1-11/2 Slate

3-6 1/2 Coal

543.49

633.77

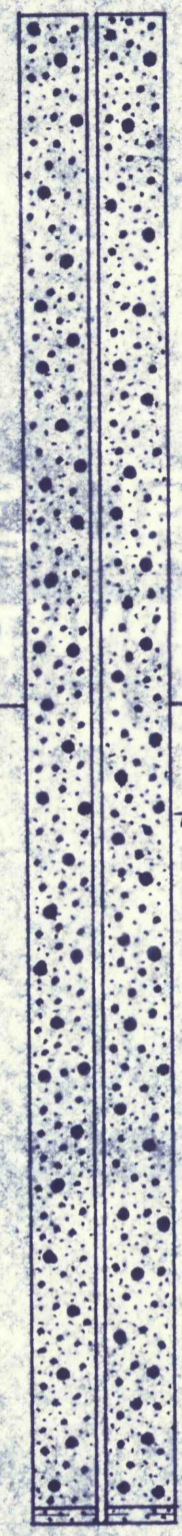

77-6 Surface

0-9/2 Rock

STRATHMORE PARCHMENT  
STRATHMORE QUALITY  
U.S.A.