




386C

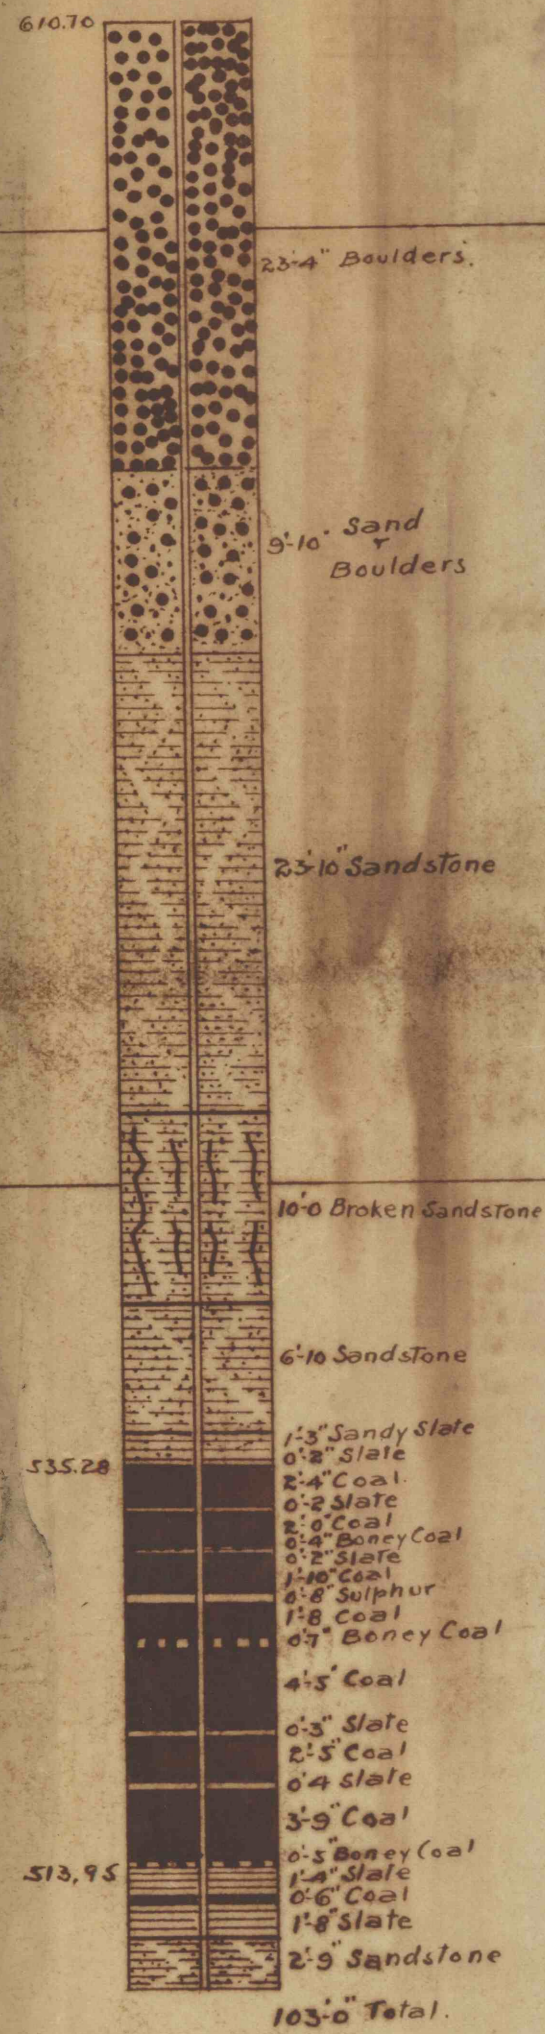


443C

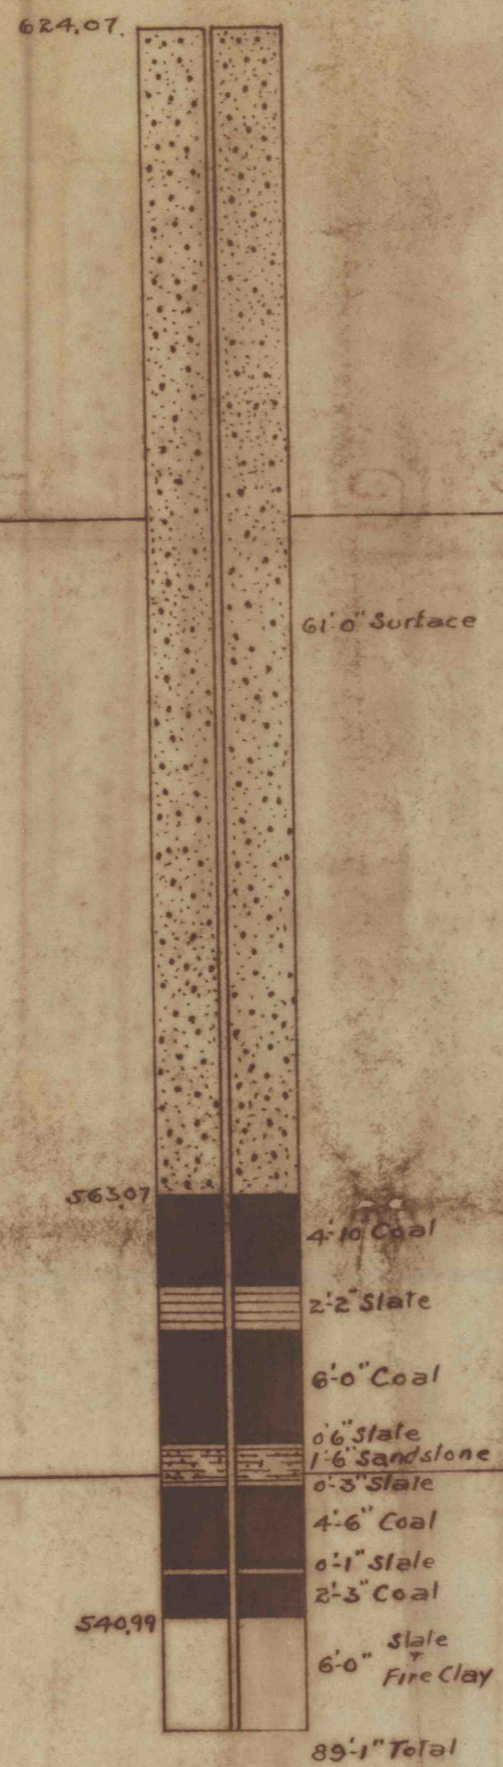


445C

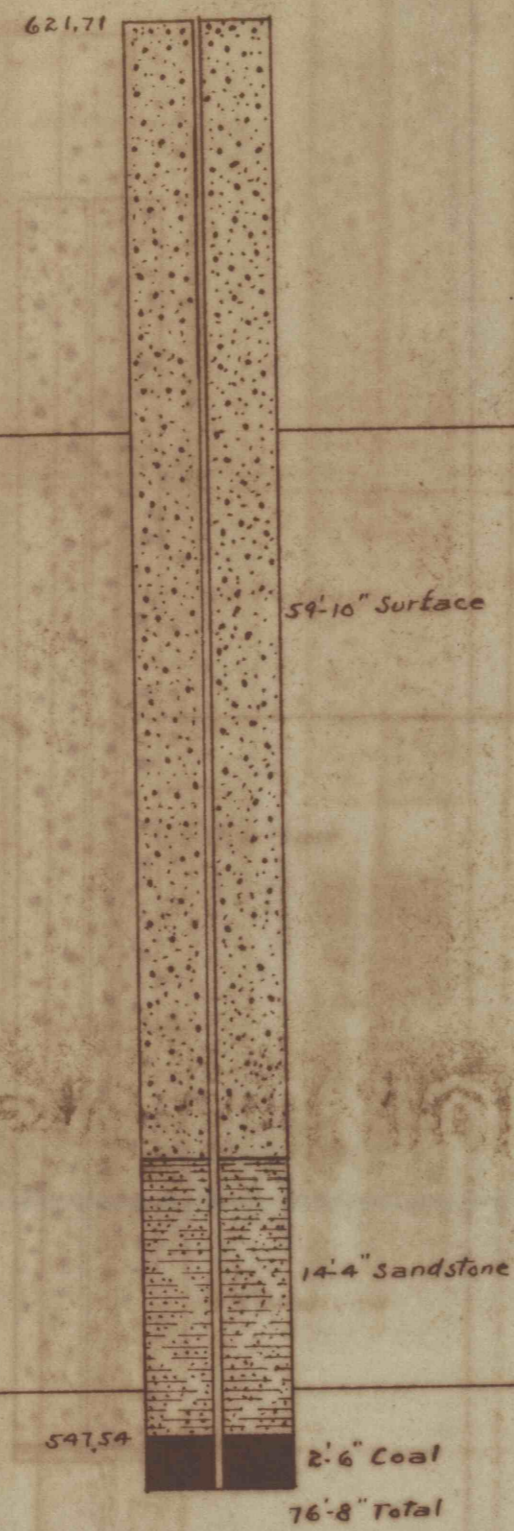


448C

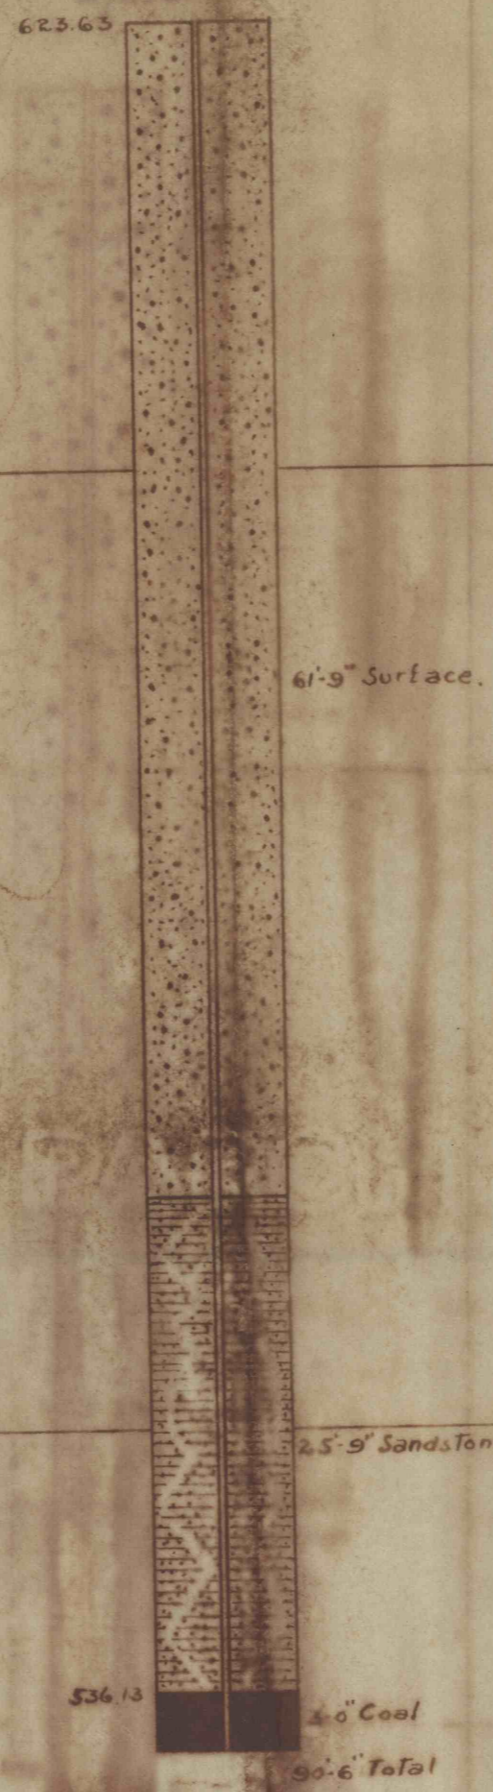


449C

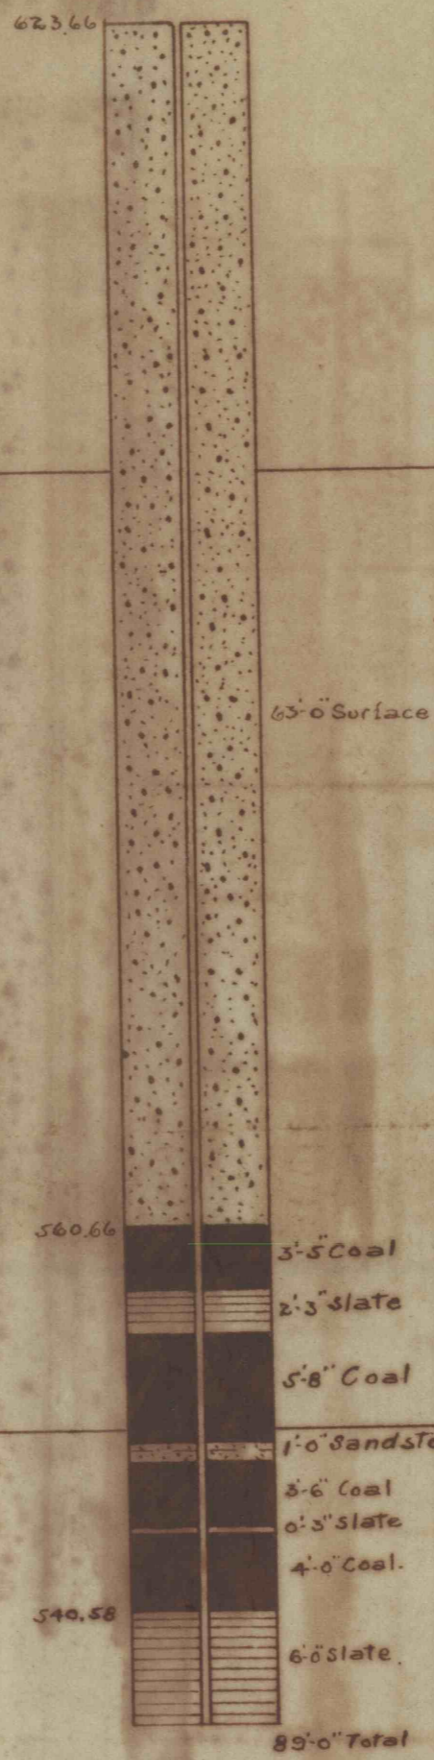

451C

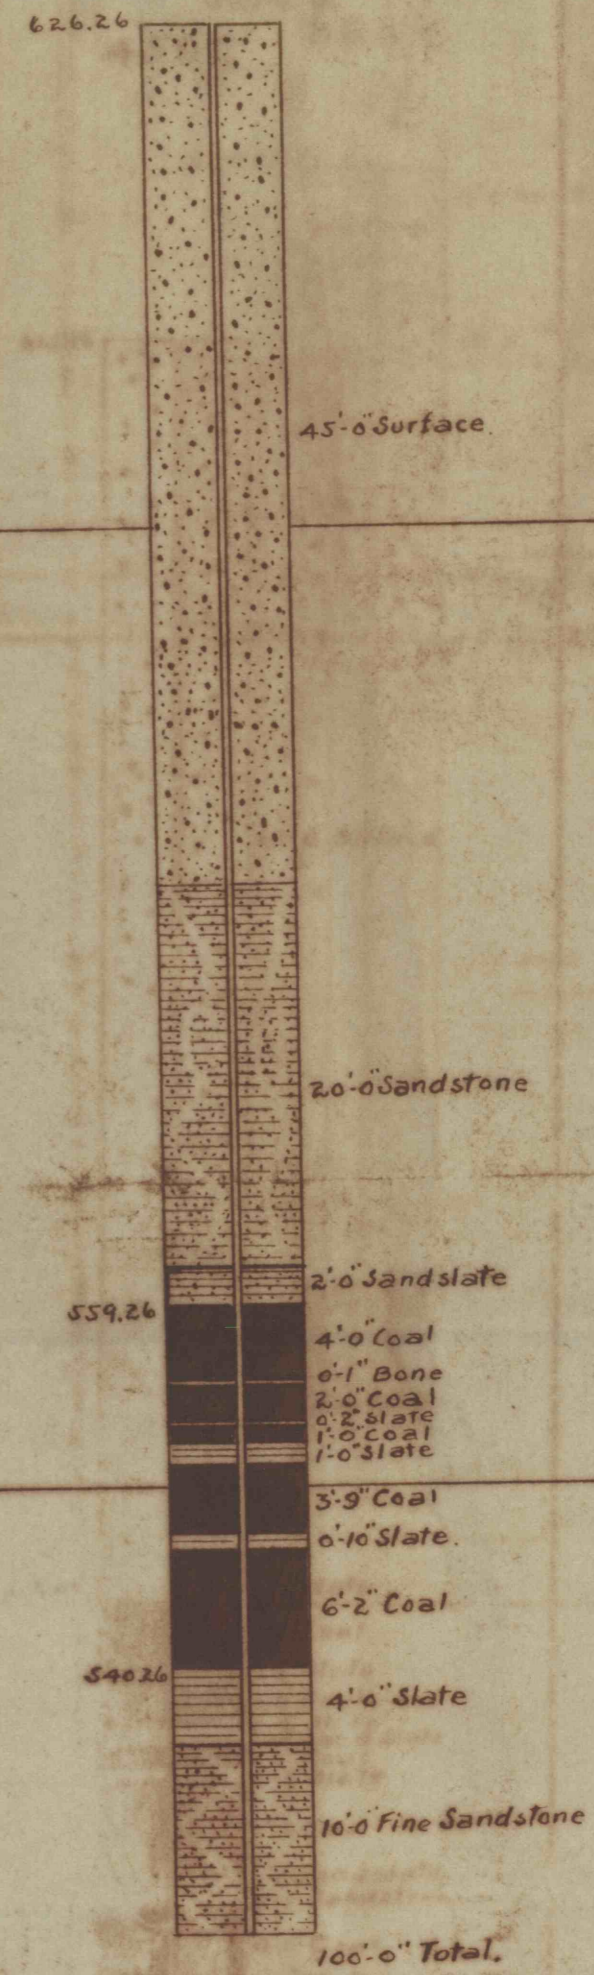

453C

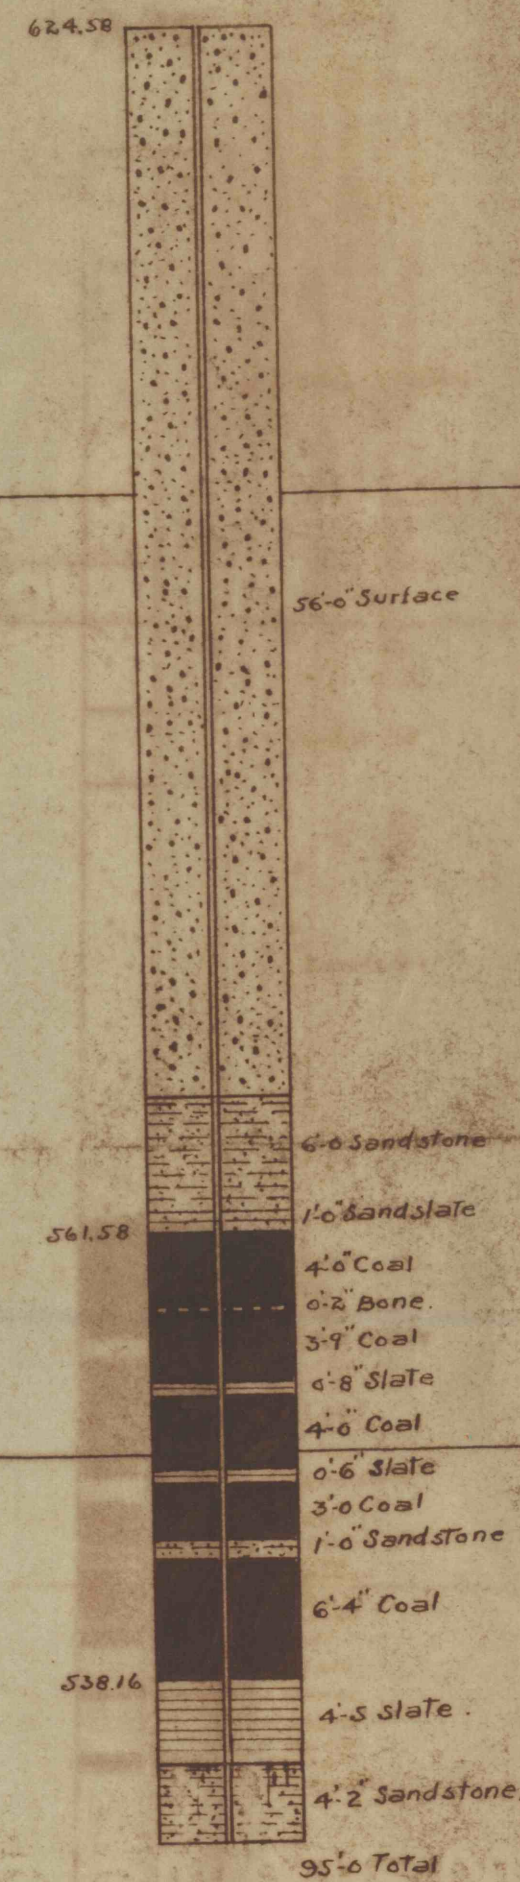

PARCEMENT 9119