


455C

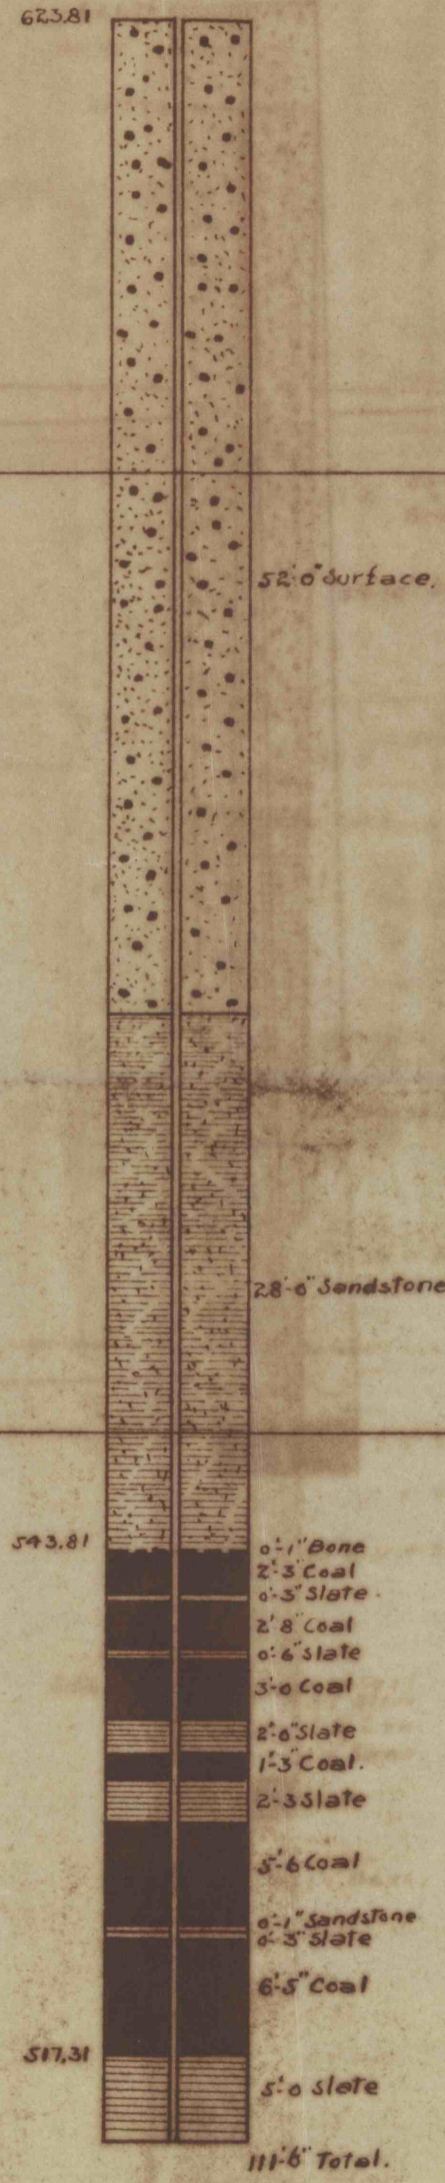

456C



457C




458C




459C



387C
A/89

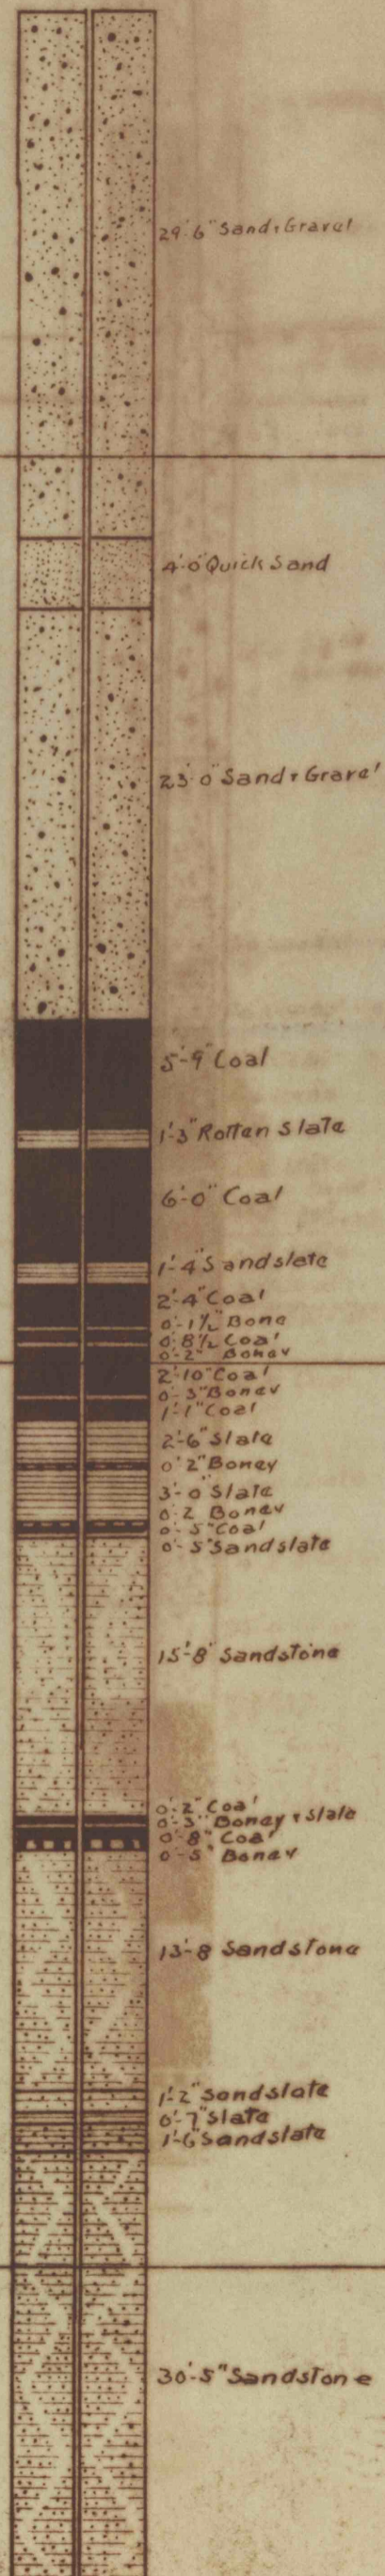

5
B/211.

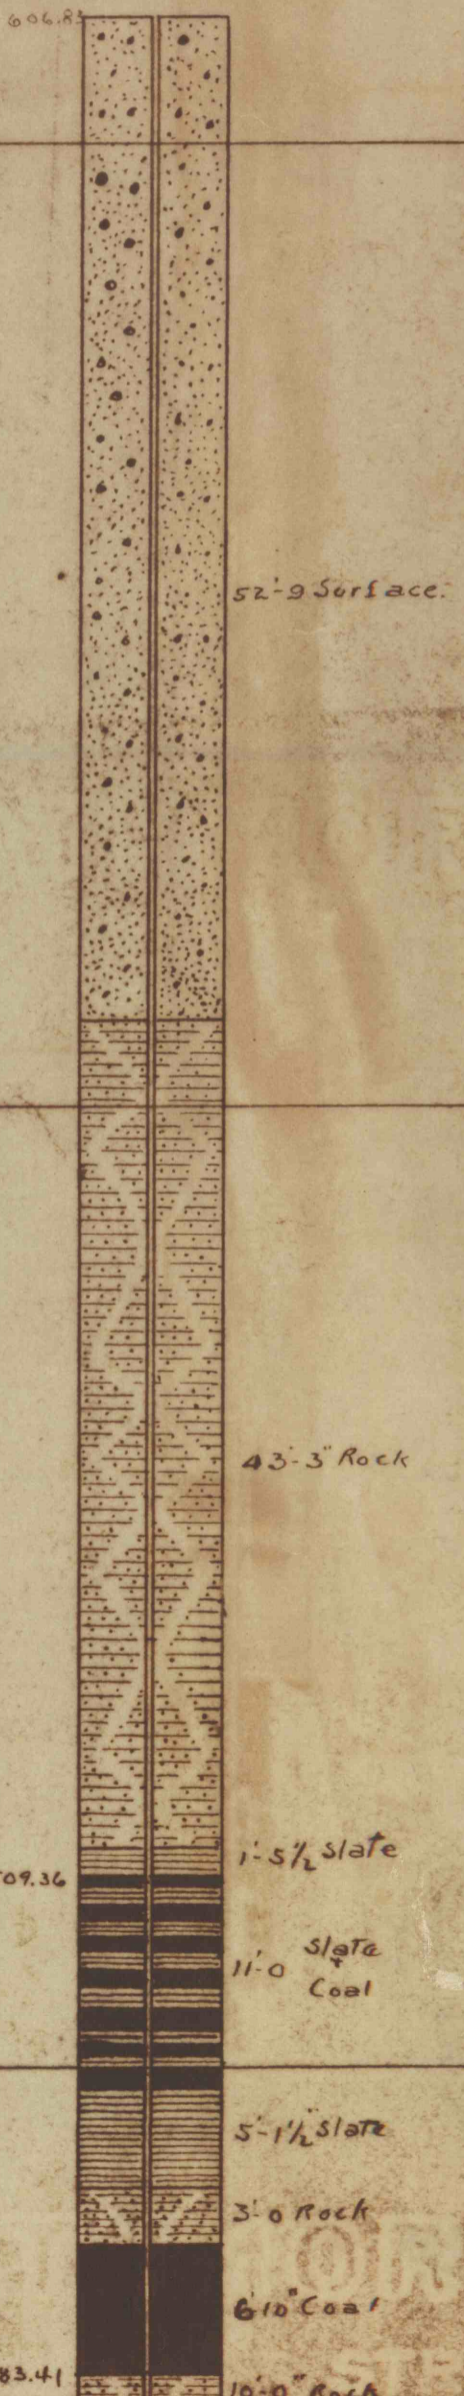

STRAITHMORE PARCLEMENT
STRAITHMORE QUARRY