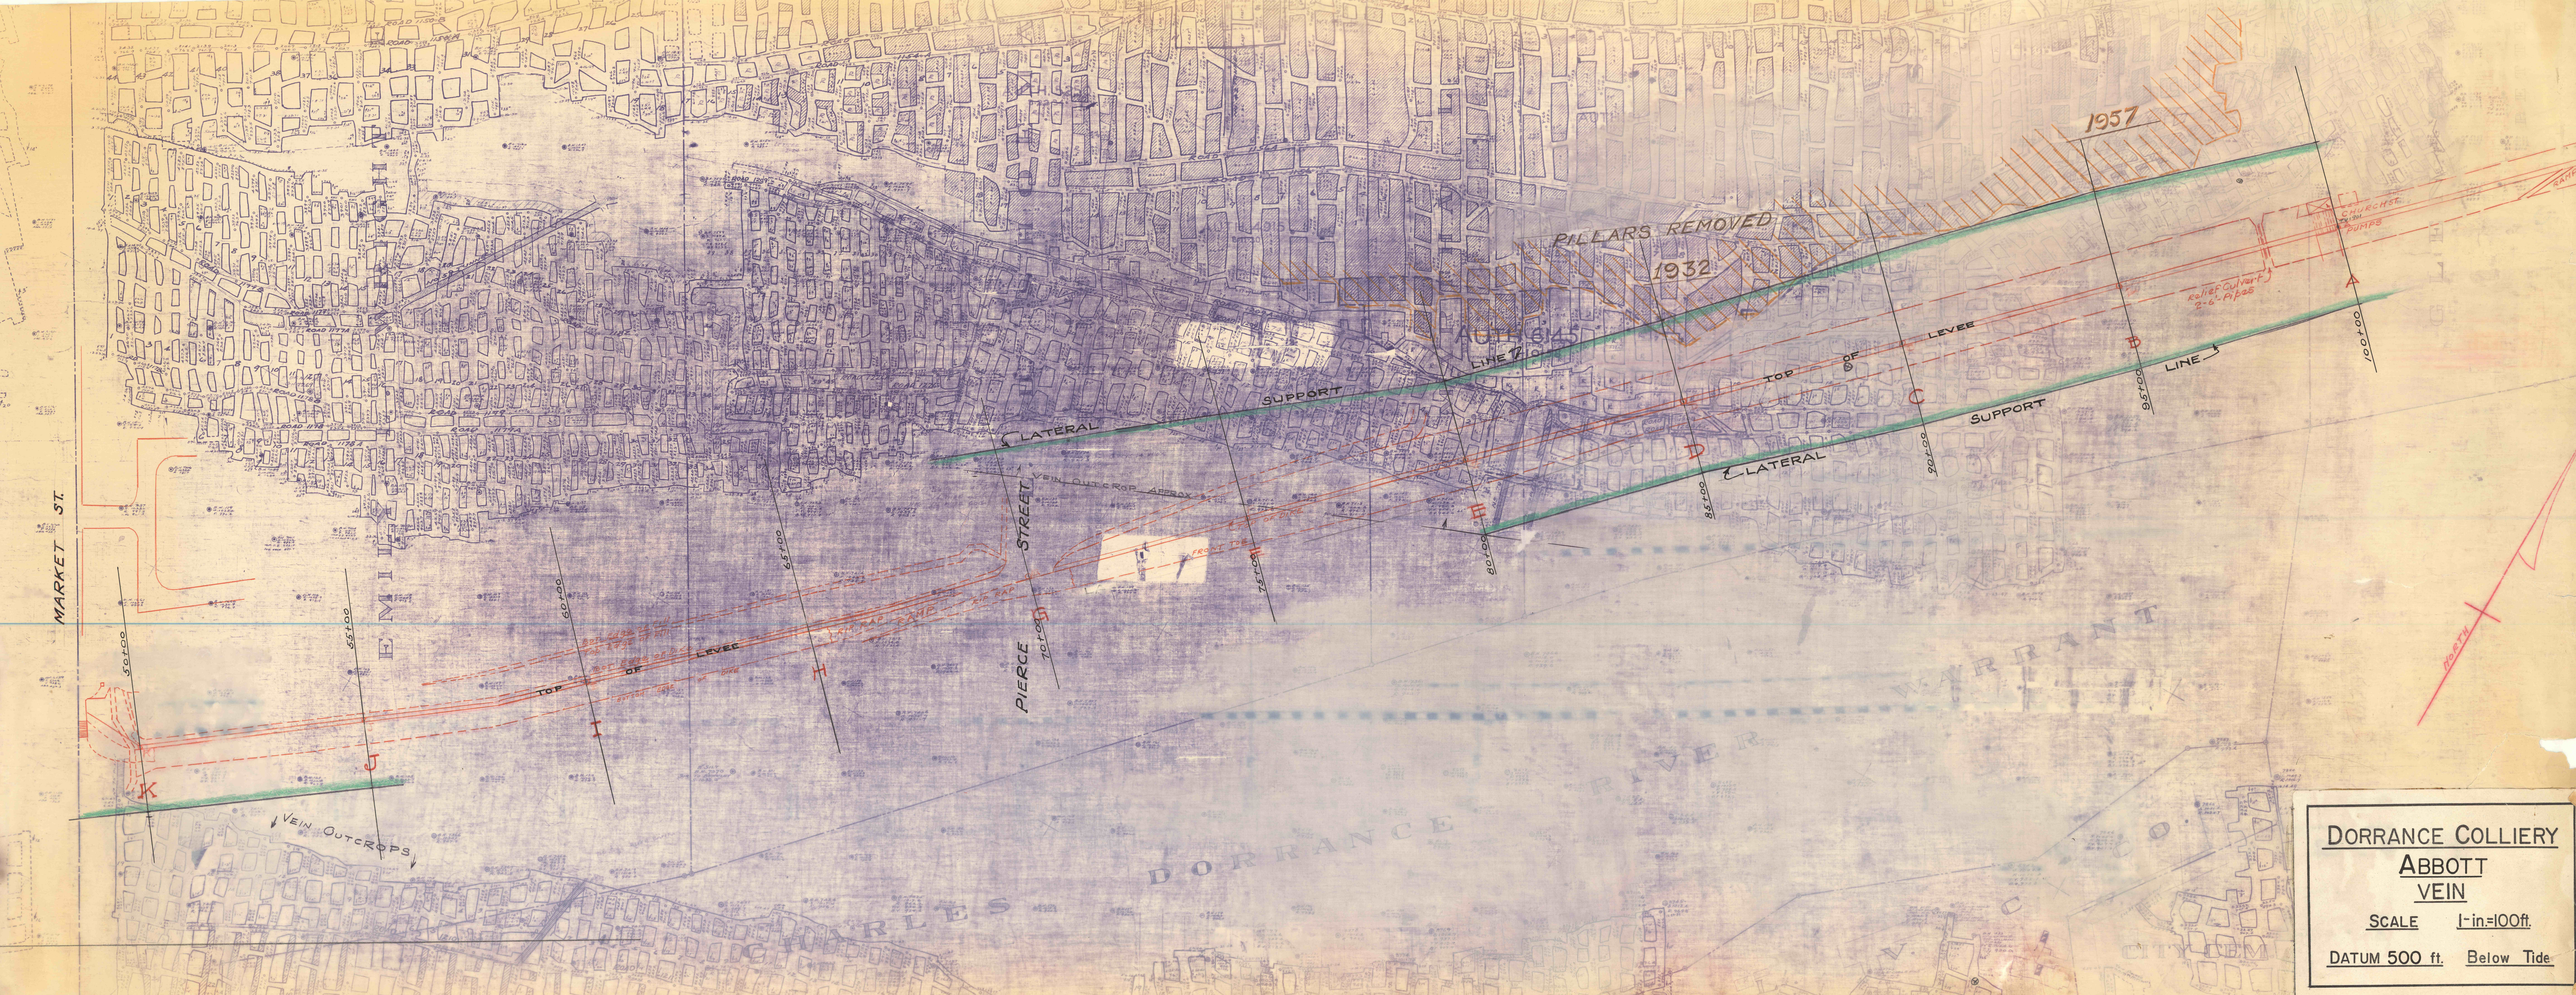
DORRANCE COLLIERY
ABBOTT
VEIN
SCALE 1-in.=100ft.
DATUM 500 ft. Below Tide
1957
PILLARS REMOVED
1932
AUG 1945
LINE OF
SUPPORT
LATERAL
TOP OF LEVEE
PIERCE STREET
MARKET ST.
VEIN OUTCROPS
VEIN OUTCROP APPROX.
FRONT TOP
RELIEF CULVERT 2-6" PIPES
COLLECTOR PIPES
NORTH
A
B
C
D
E
F
G
H
I
J
K
10+00
50+00
55+00
60+00
65+00
70+00
75+00
80+00
85+00
90+00
95+00
100+00
DORRANCE
WARRANT