


PAYNE COAL CO.  
EAST BOSTON COLLIERY

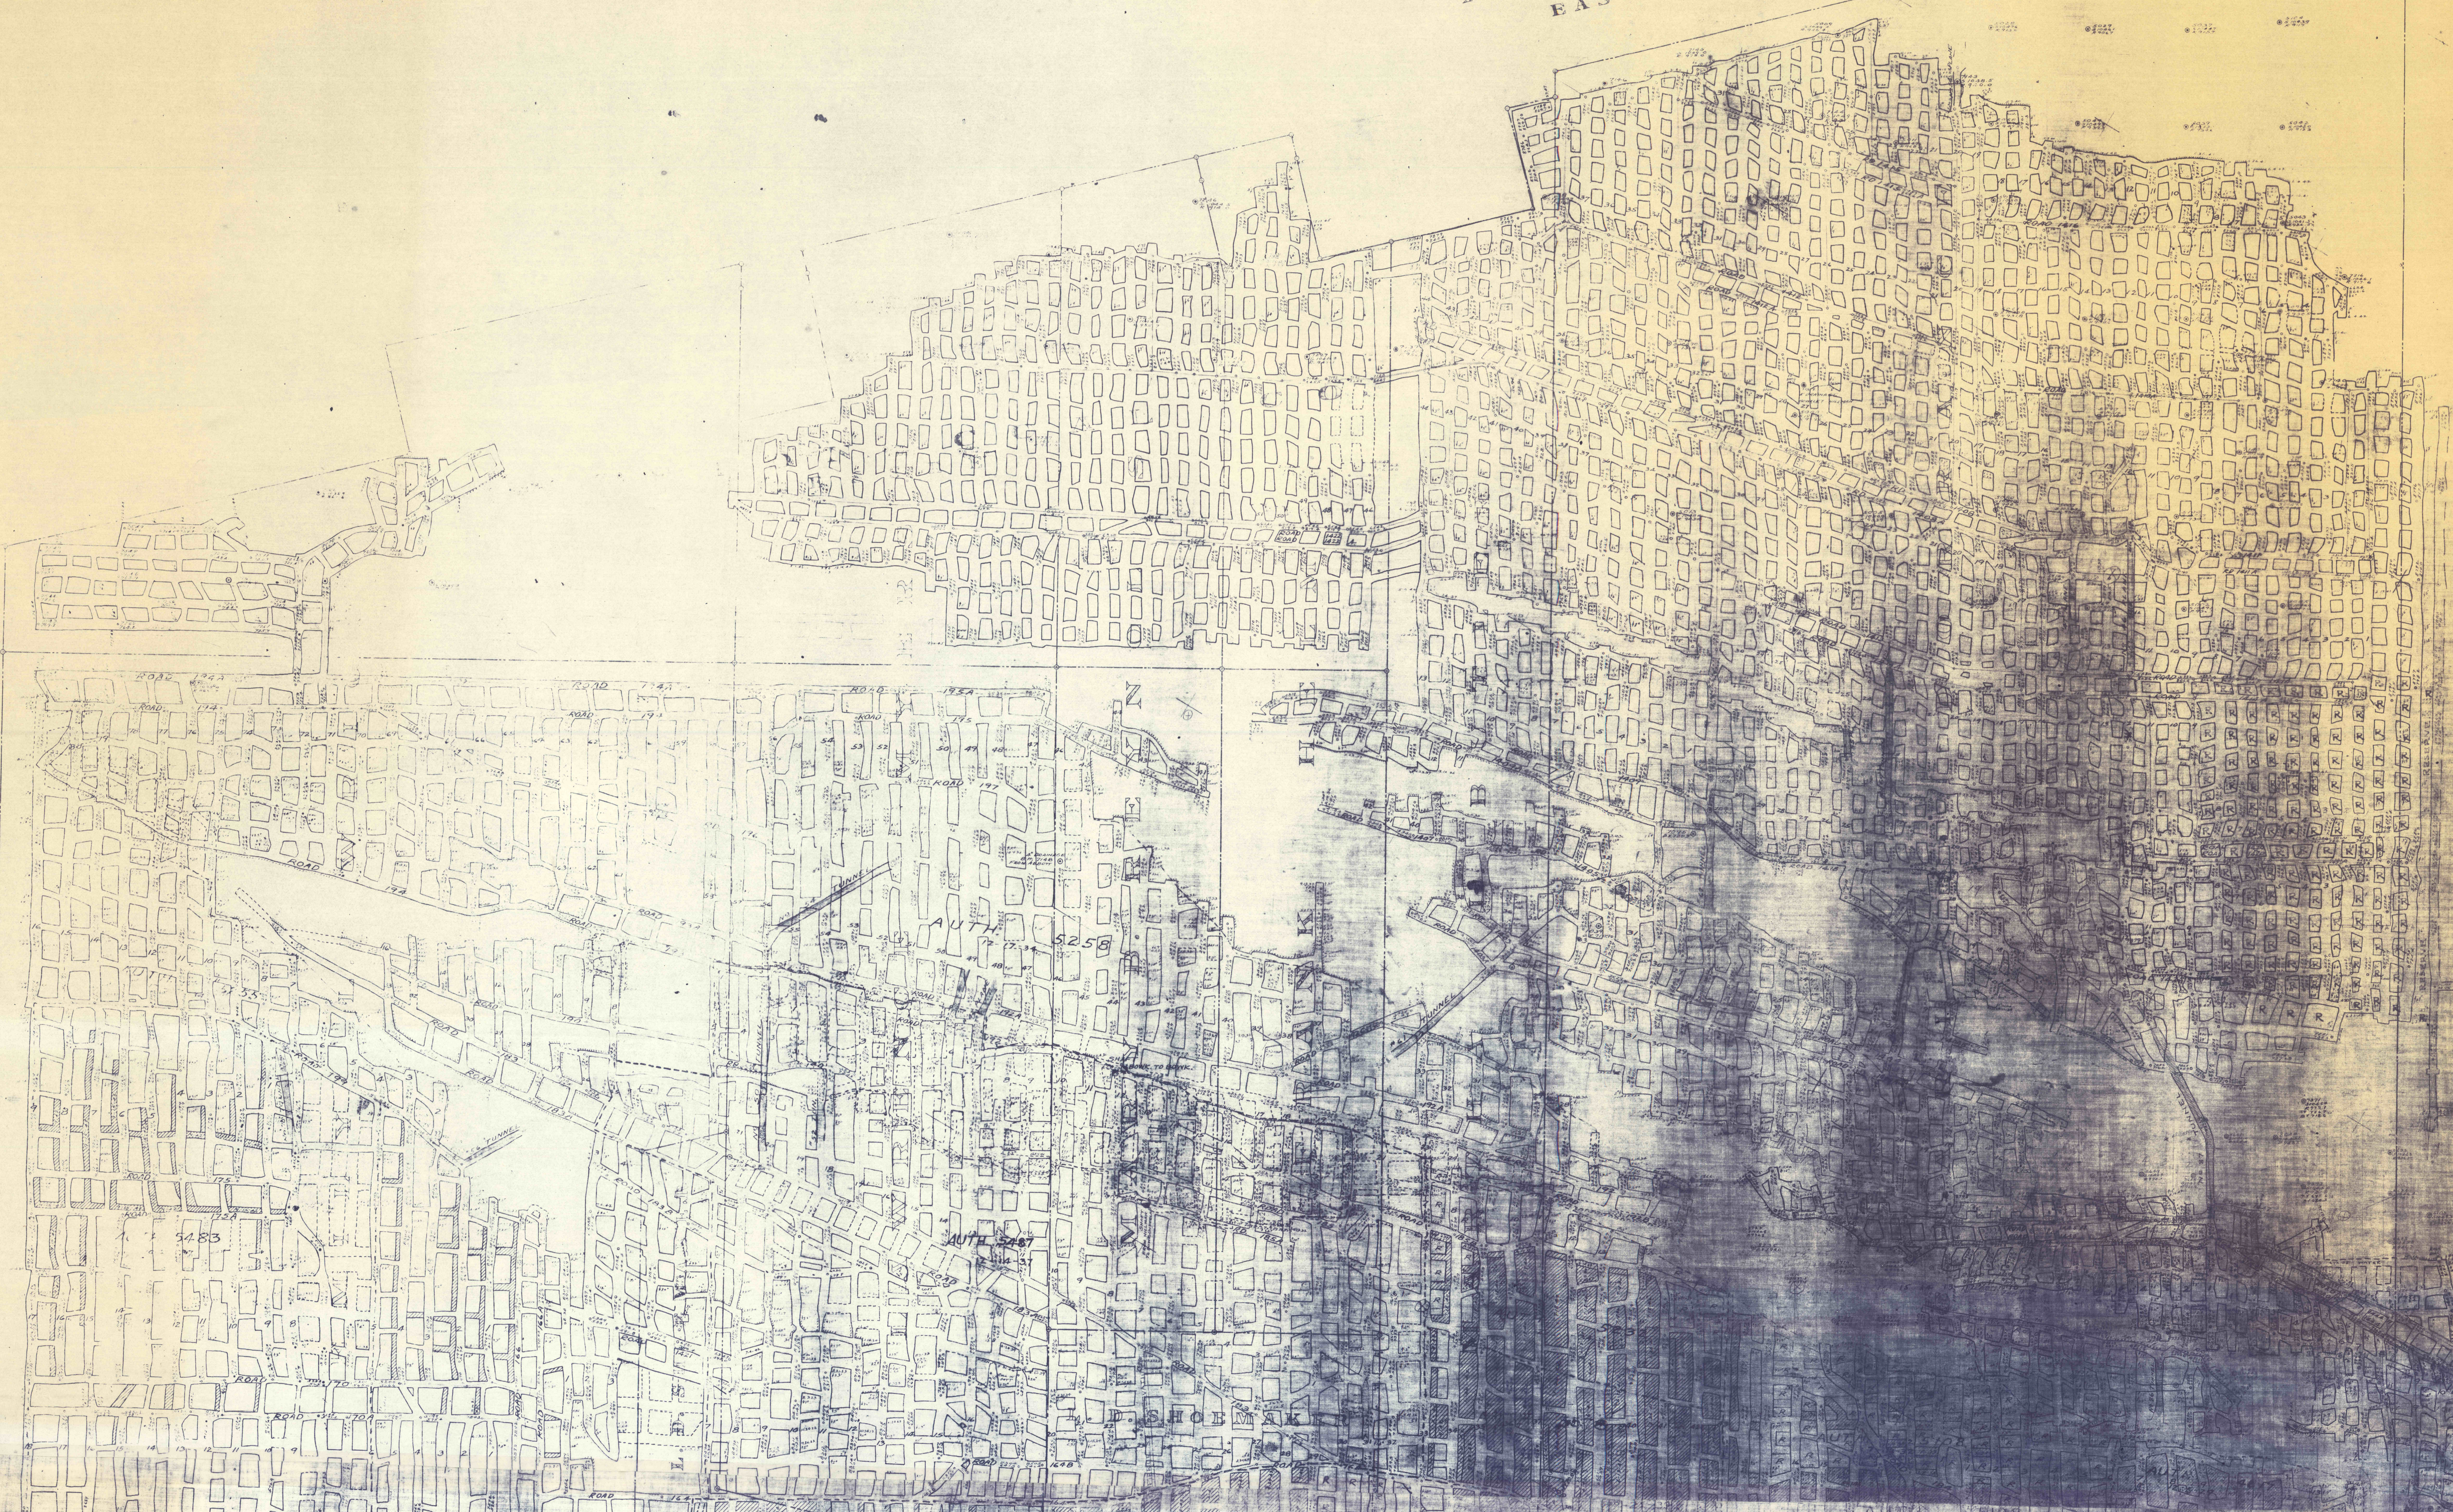

GLLEN ALDEN COAL CO.  
PETTIBONE COLLIERY

*Bowling Green*

5283

5250

5257

5108