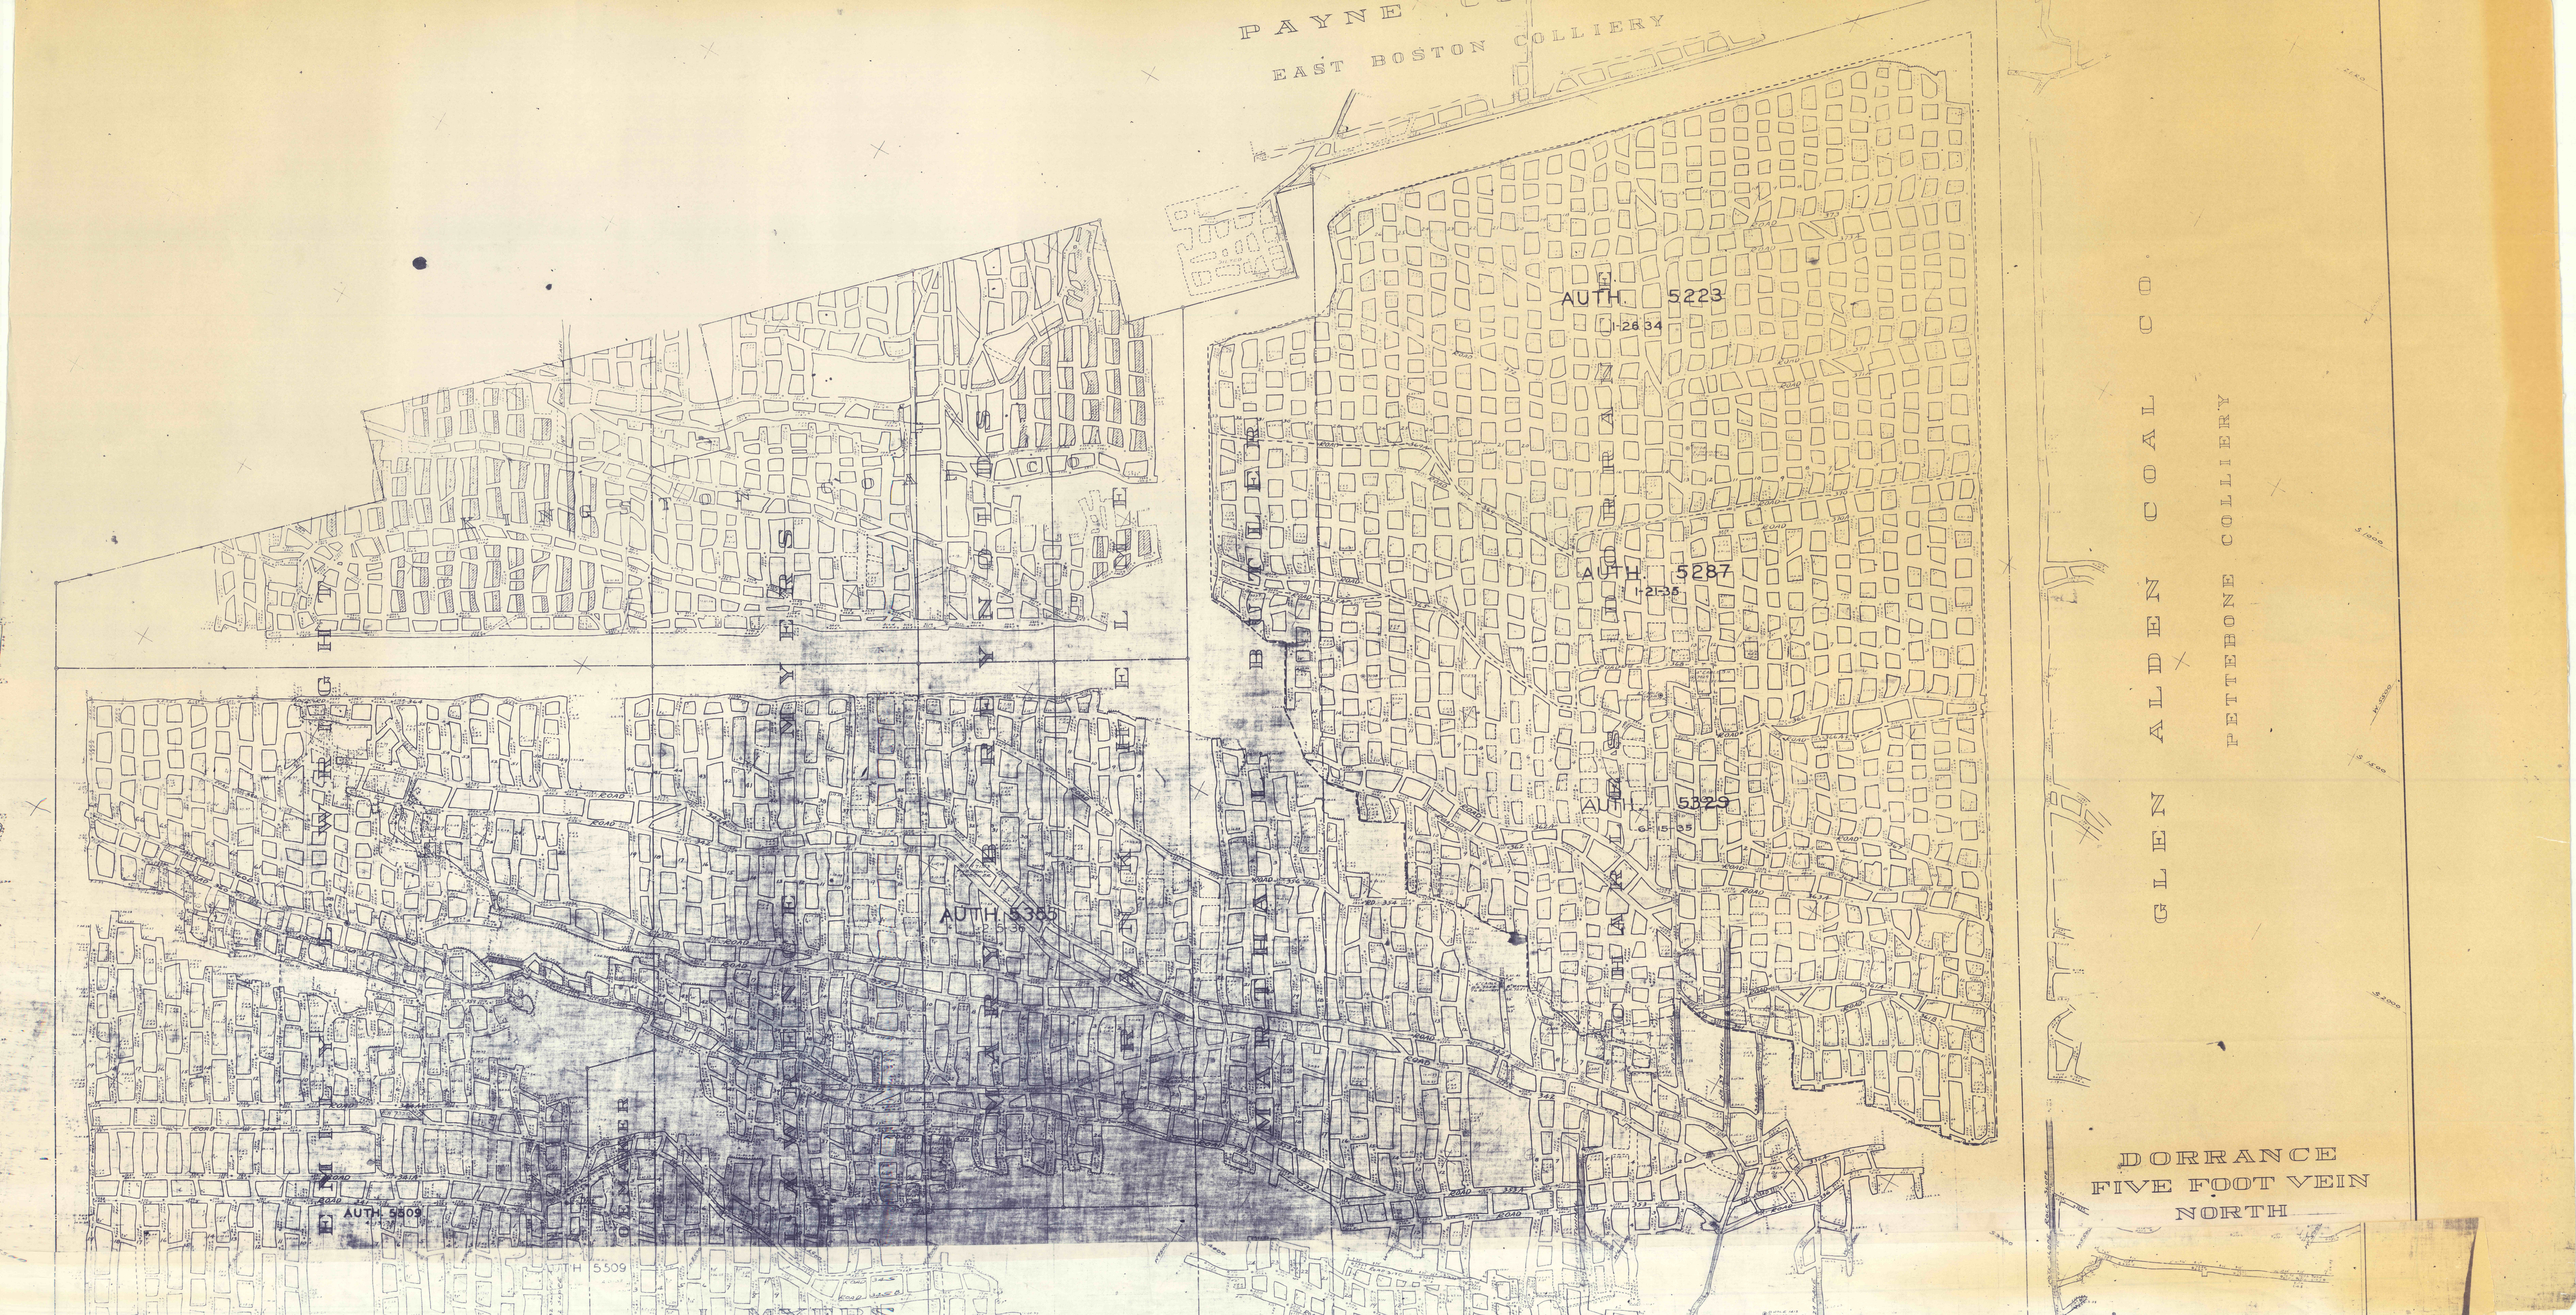
PAYNE
EAST BOSTON COLLIERY
AUTH. 5223
1-26-34
AUTH. 5287
1-21-35
AUTH. 5329
6-15-35
AUTH. 5355
AUTH. 5509
GLEN ALDEN COAL CO
PETTIBONE COLLIERY
DORRANCE
FIVE FOOT VEIN
NORTH