


DORRANCE  
BENNETT VEIN  
NORTH

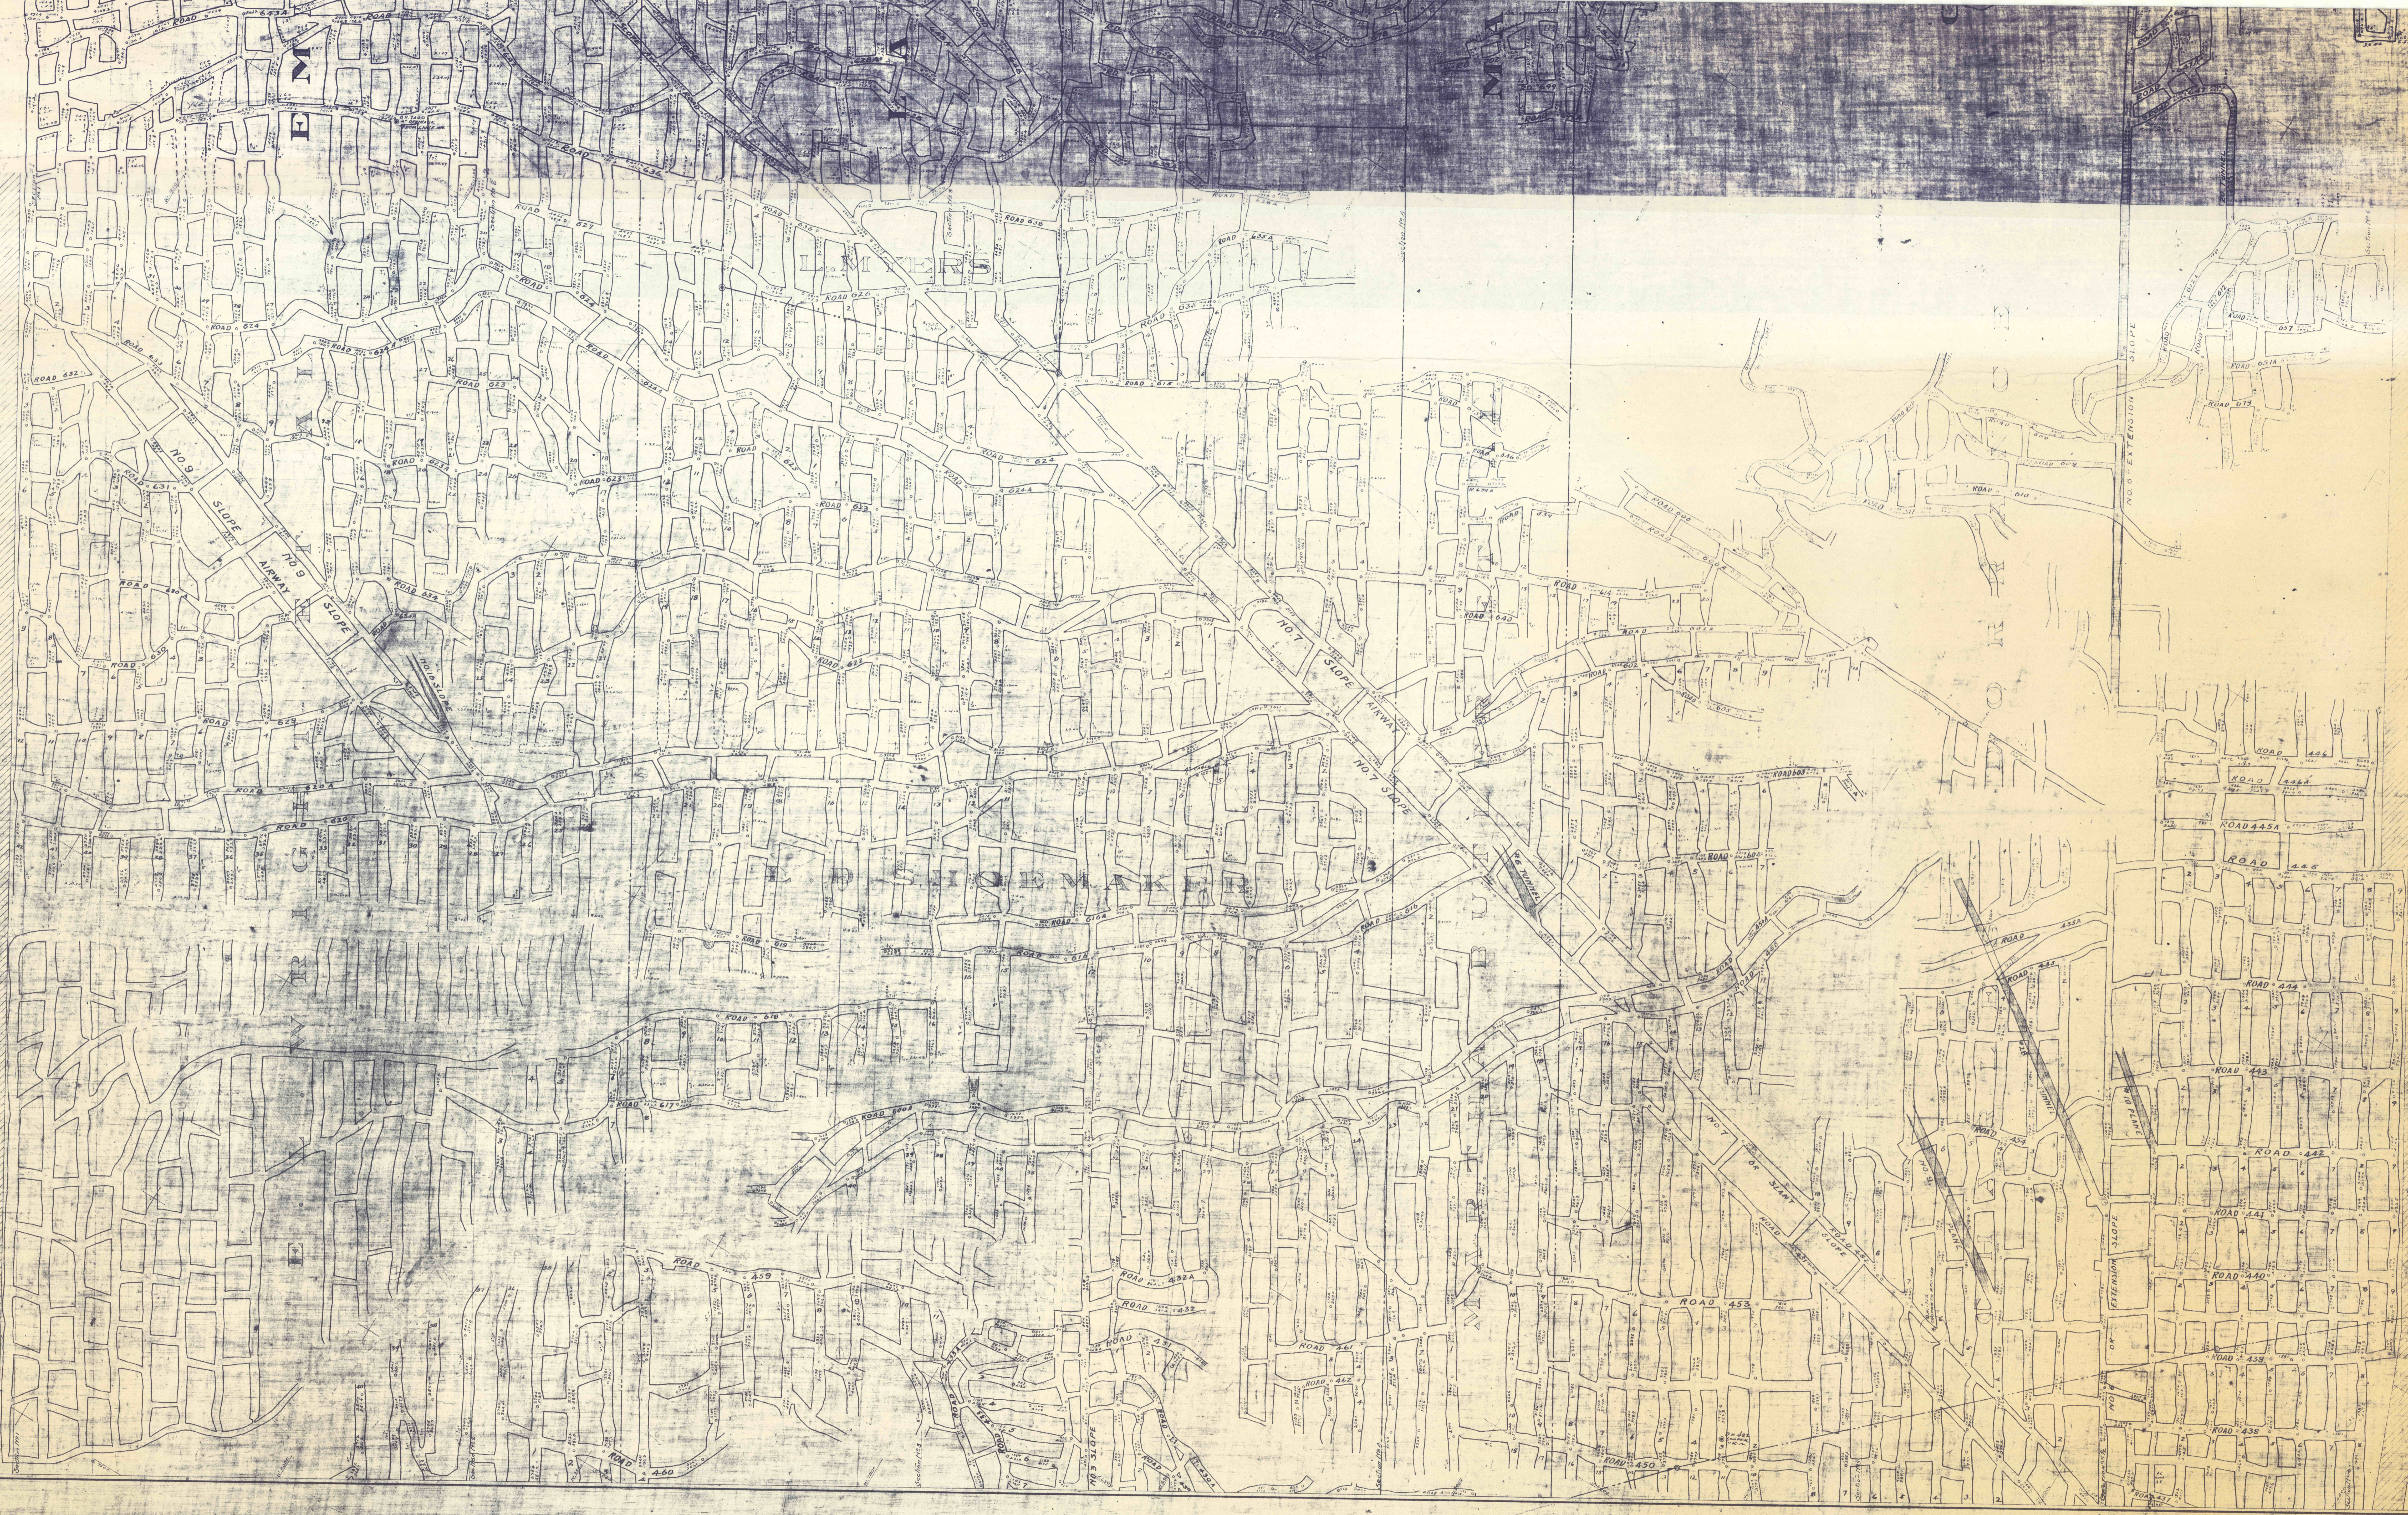

DORRANCE  
BENNETT VEIN  
MIDDLE

BENNETT VEIN