

EMILY L WRIGHT

L D SHOEMAKER

MARTHA L BUTLER


CHARLES DORRANCE

CHAS

DORRANCE
CHECKER
MIDDLE

CHECKER VEIN

LEWIS

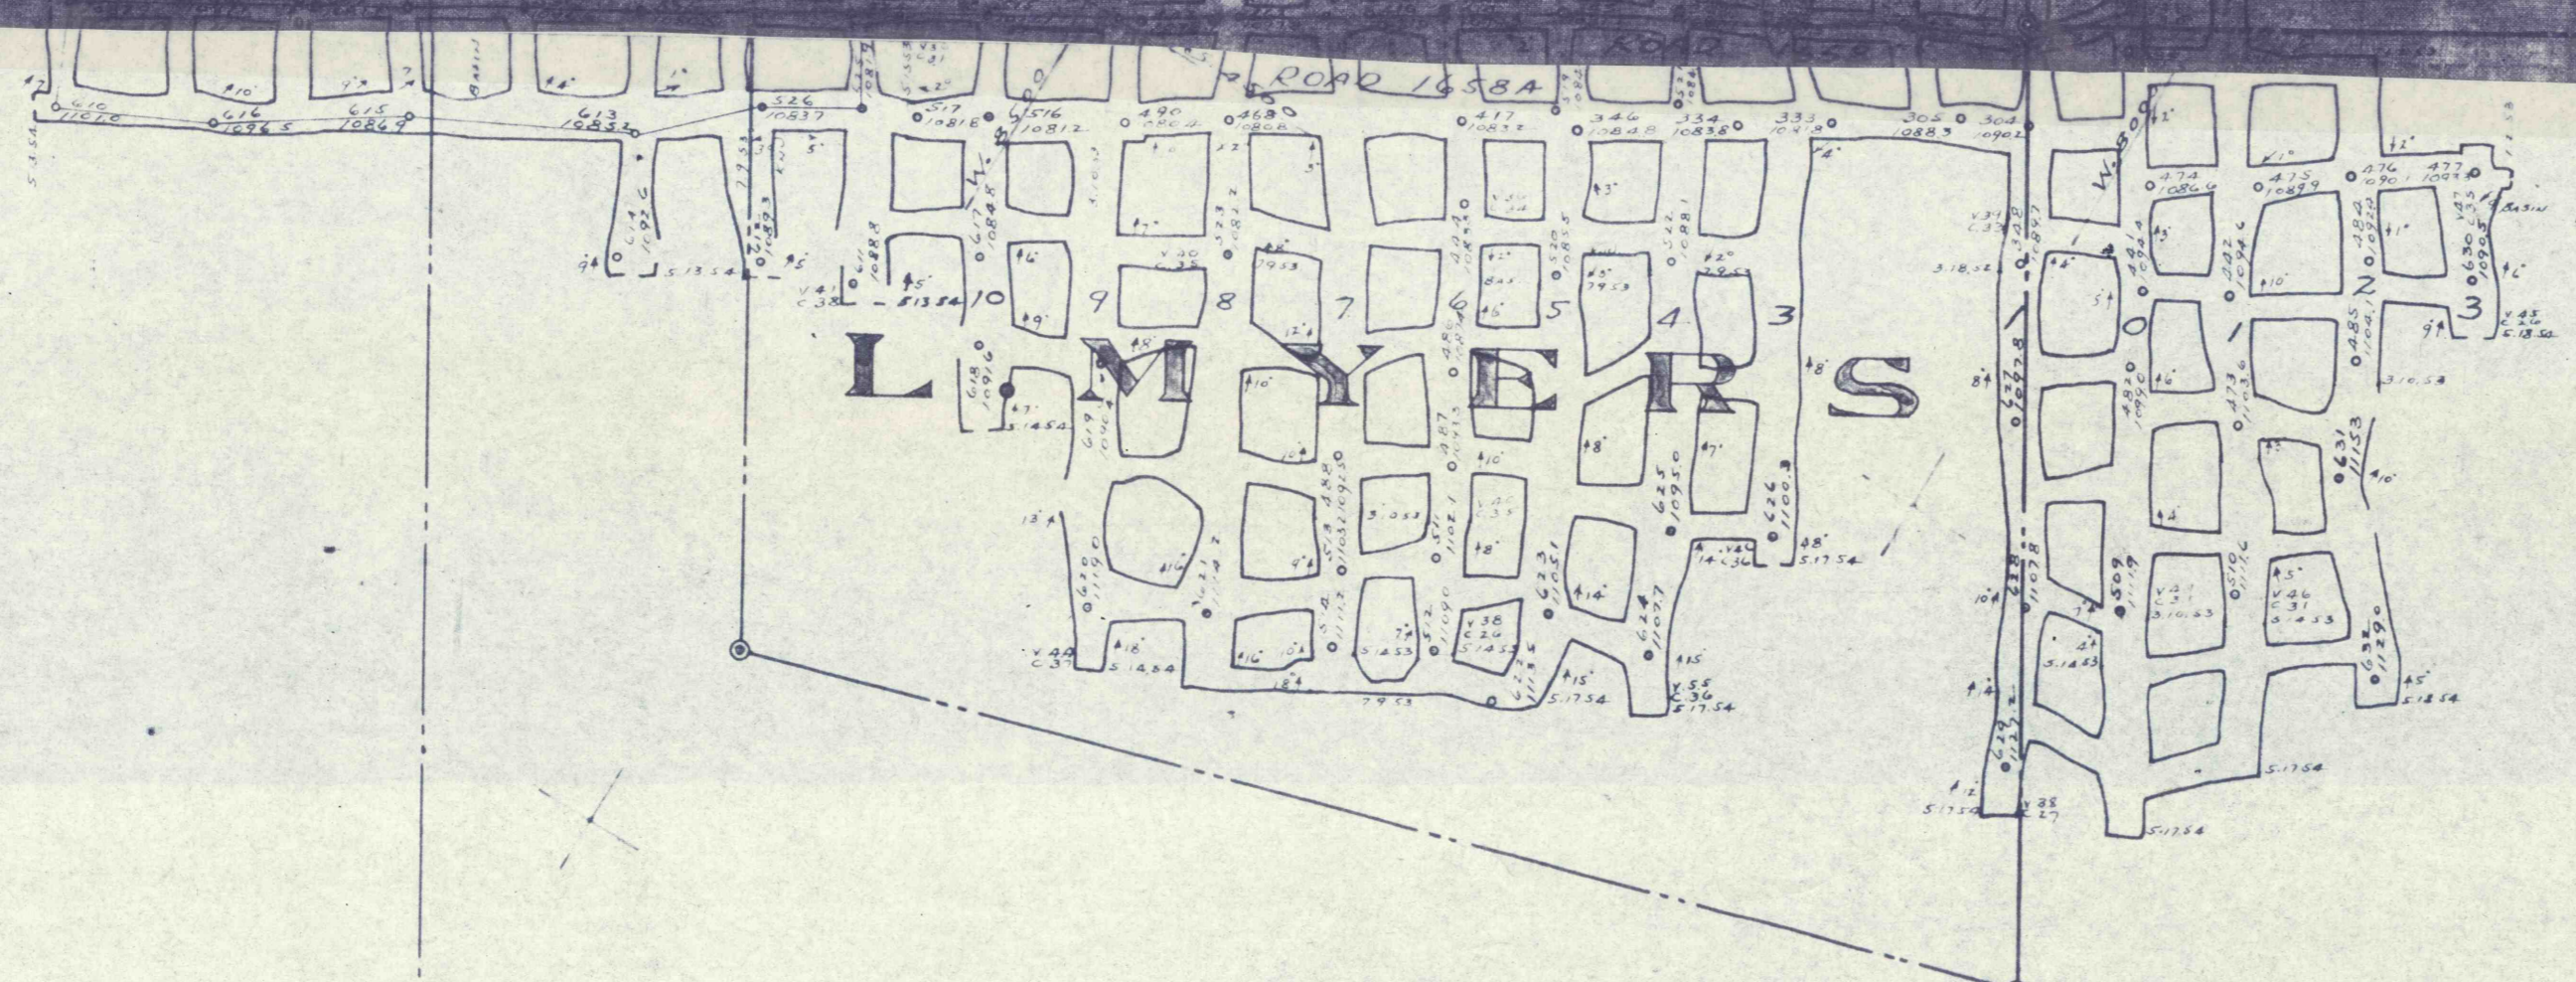

CHECKER MIDDLE