


APPROVED BARRIER PILLAR H.W.M. To D.L.D. 5-26-45

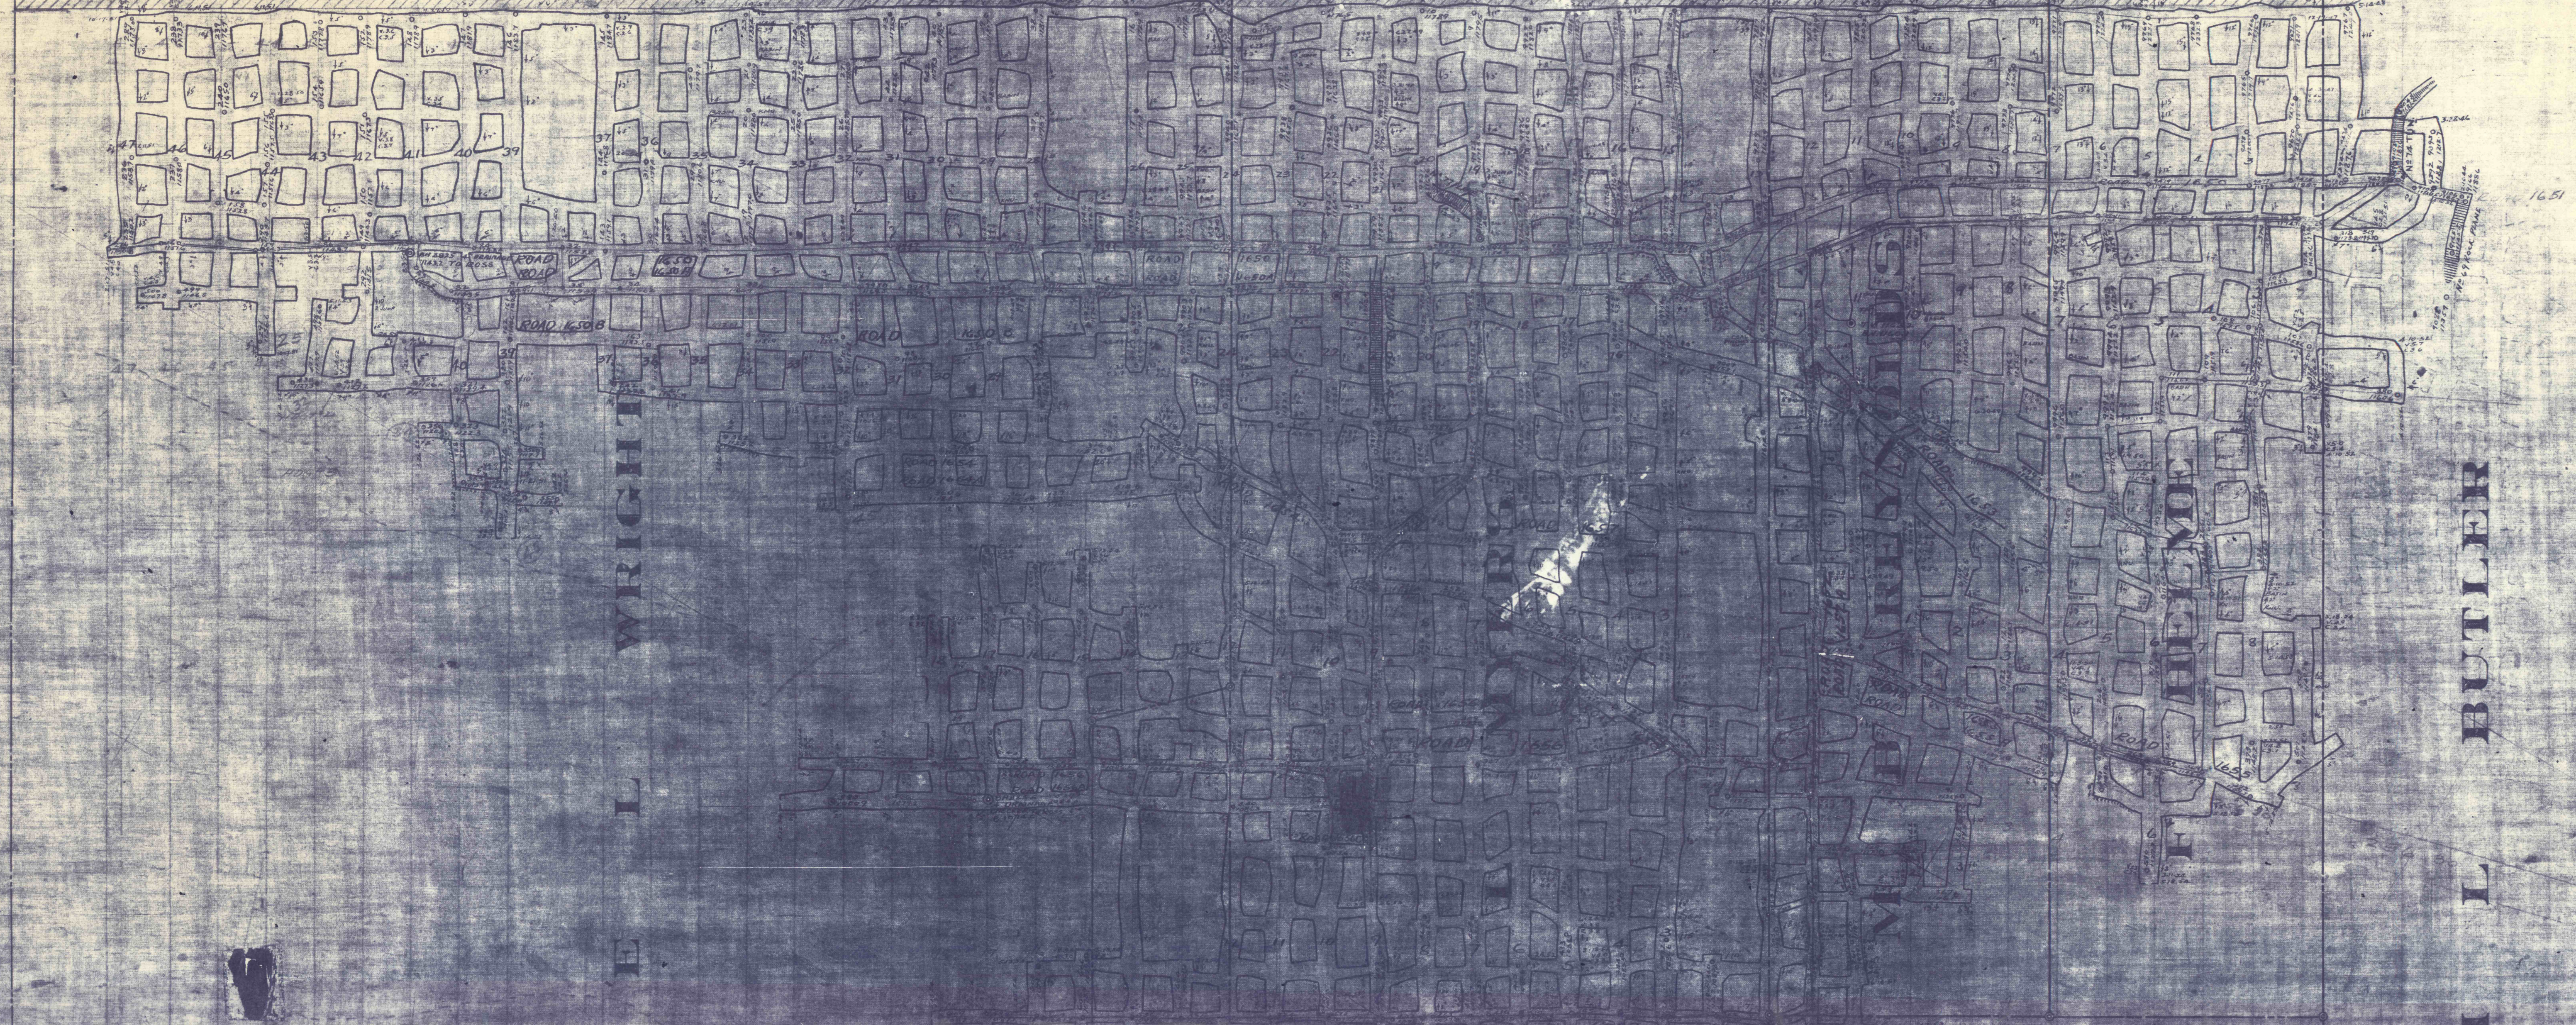

E L WRIGHT

VILLAGE SQUARE

H F HEYWOOD

E L BUTLER

CHAS DORRANCE