


DORRANCE  
SKIDMORE VEIN  
NORTH

GLENN ALDEN COAL CO.  
PETTERBONE COLLIERY

DORRANCE  
SKIDMORE  
MIDDLE

CHARLES  
DORRANCE

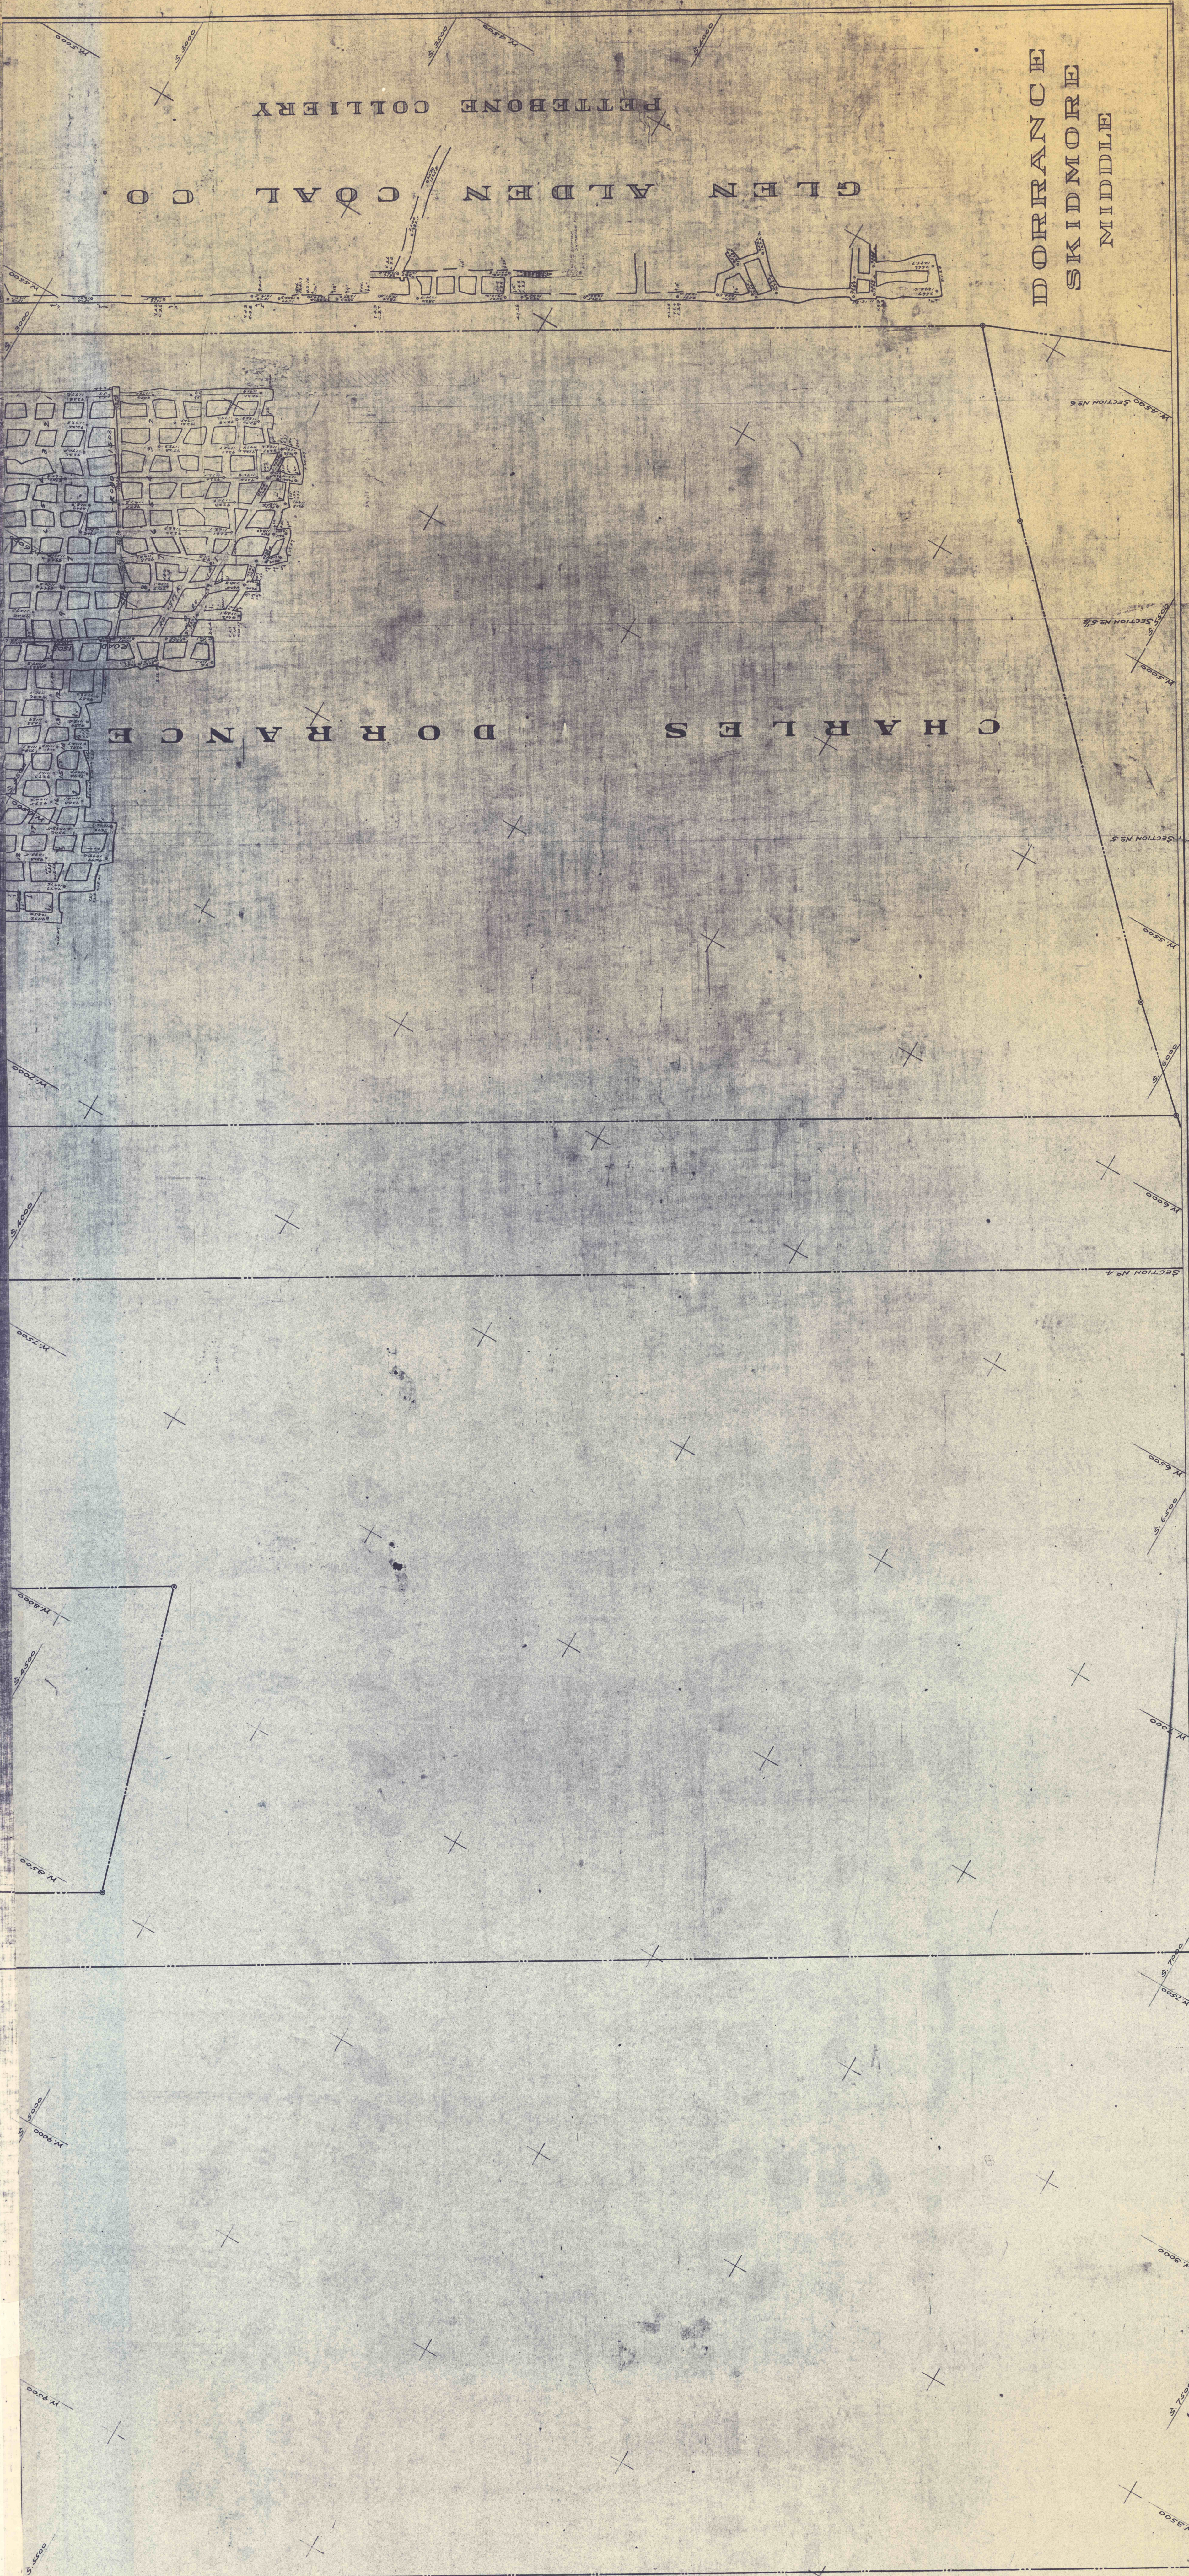

SKIDMORE VEIN