


ANCE COLLIERY
VEIN NORTH
100 FT. BELOW TIDE
1 IN. = 100 FT.

PAYNE COAL

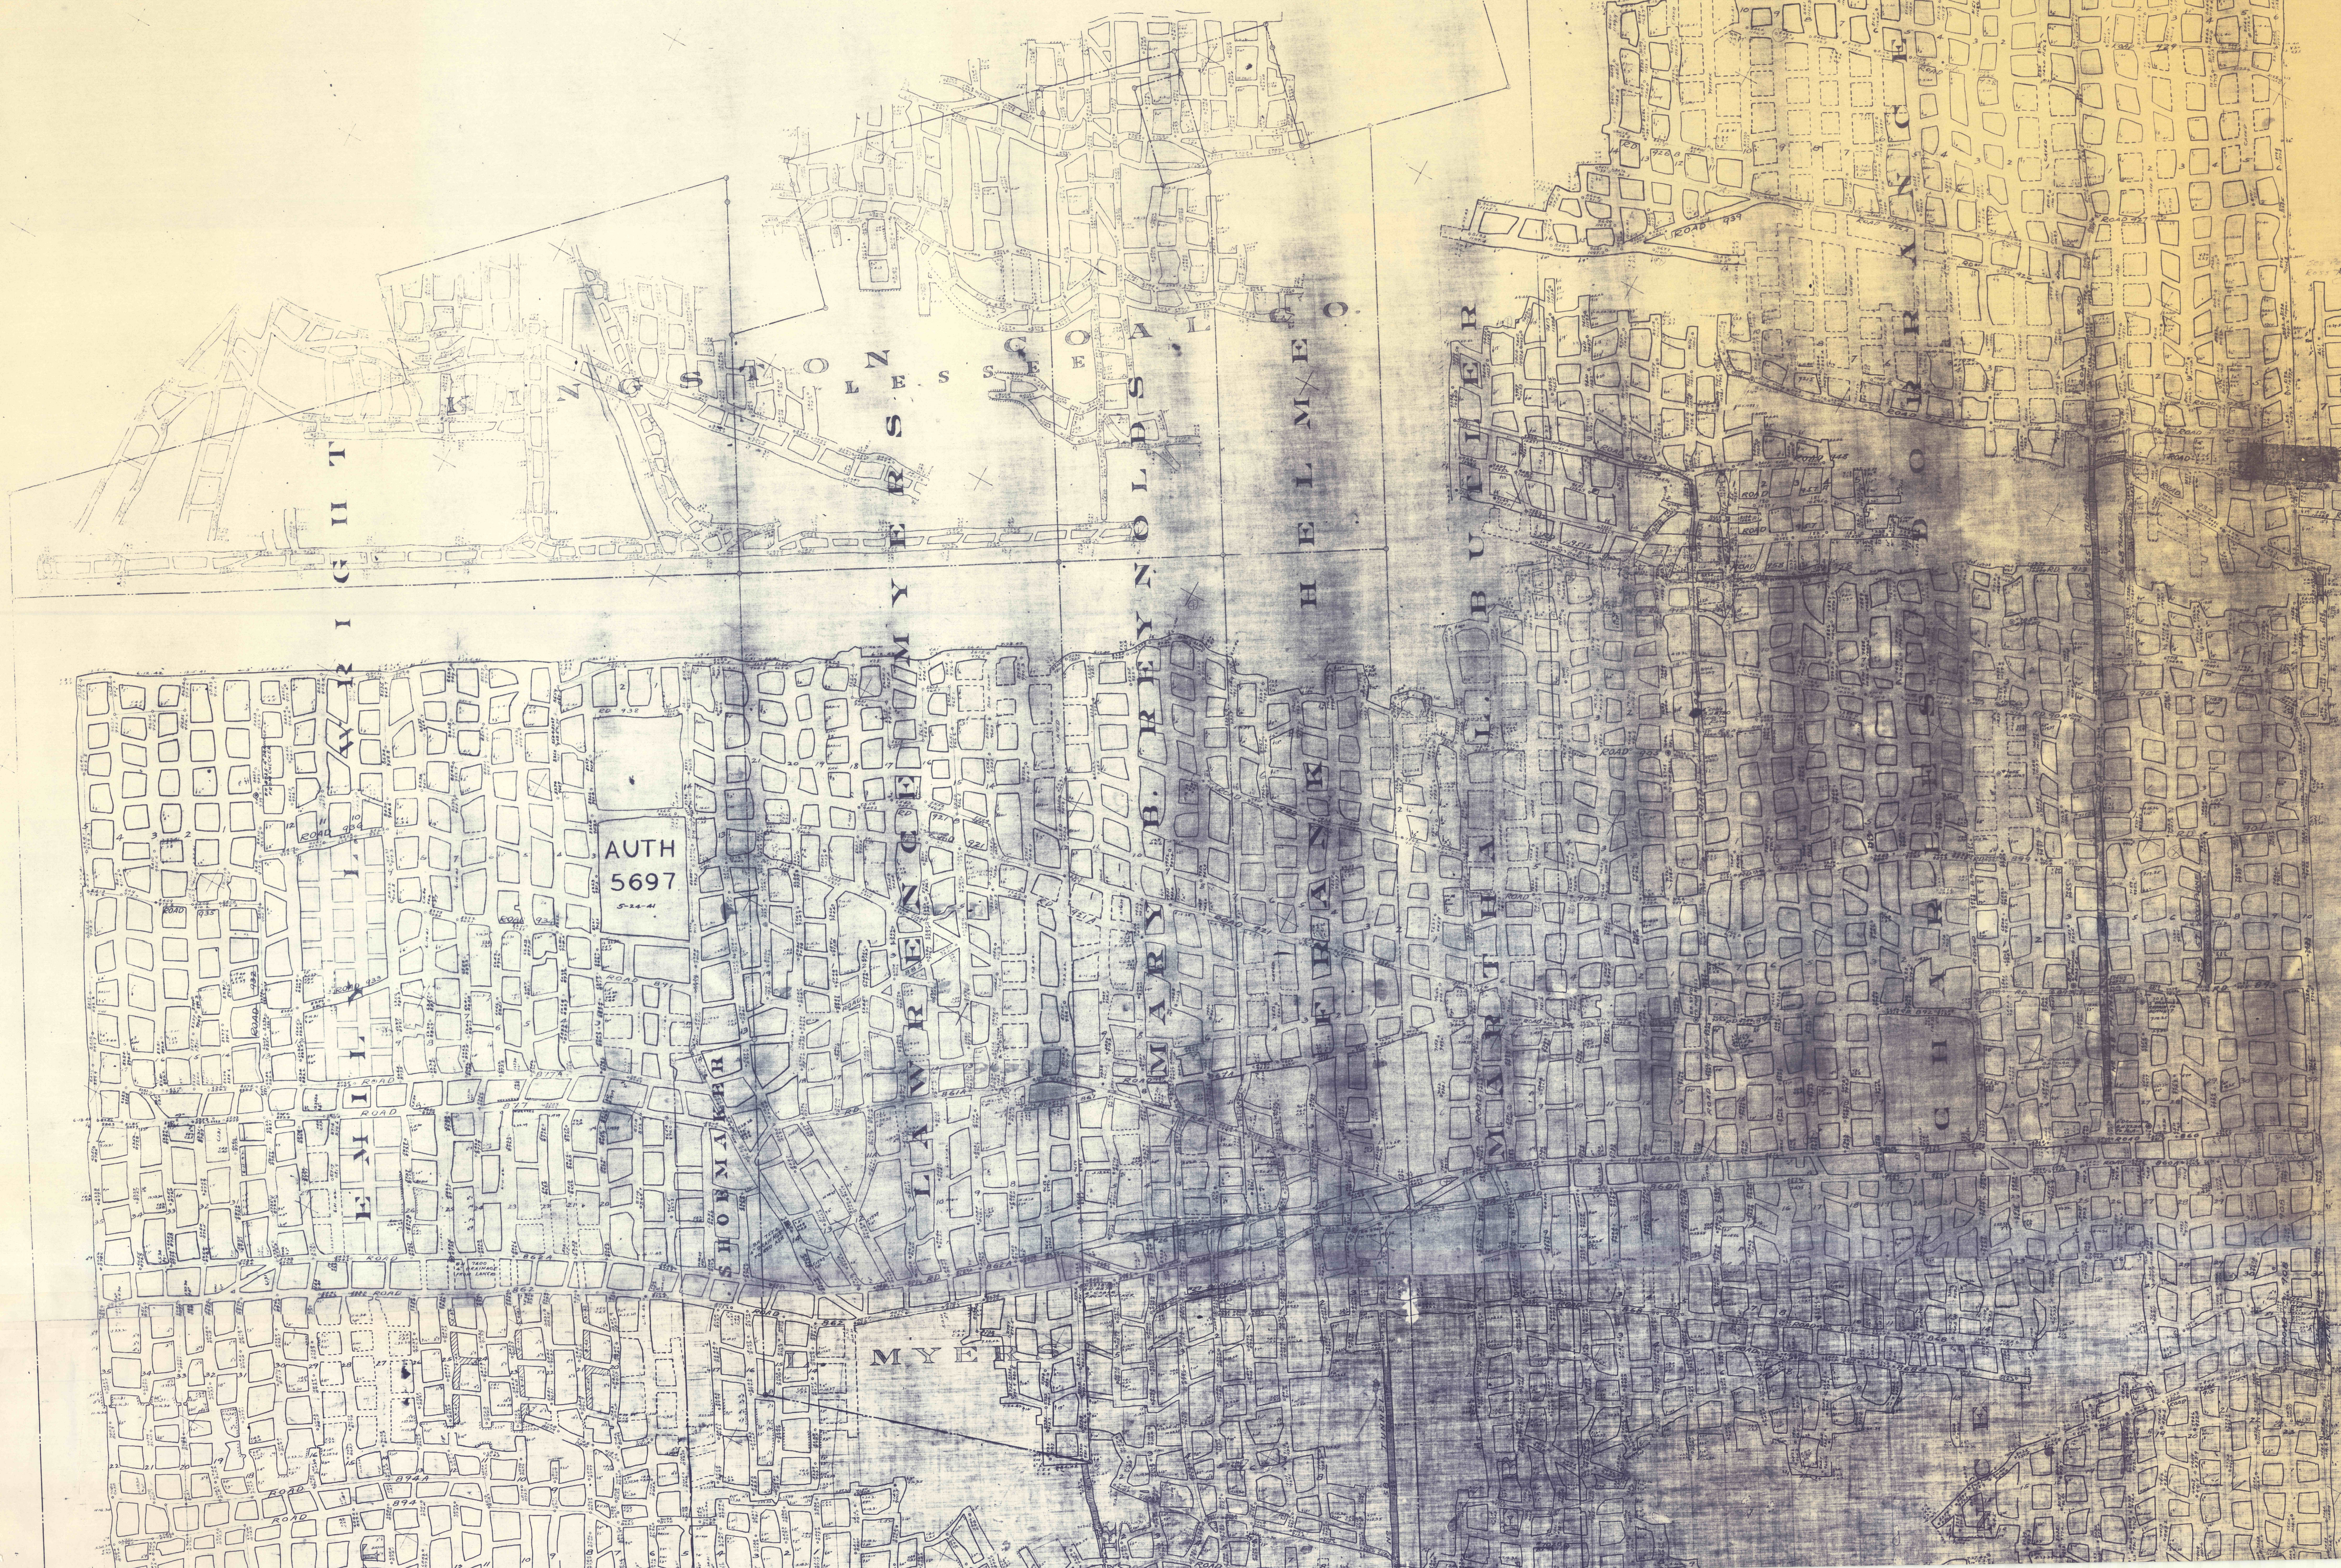

IGITT

FRS

OLDSP

HELMEO

BUFFIER

AUTH
5697

EM

SHOEM

MYE

LA WREN

MARY BRYN

FHANS

MAIN T

CH

ALCO
ERY

COAL
COLLIERY

