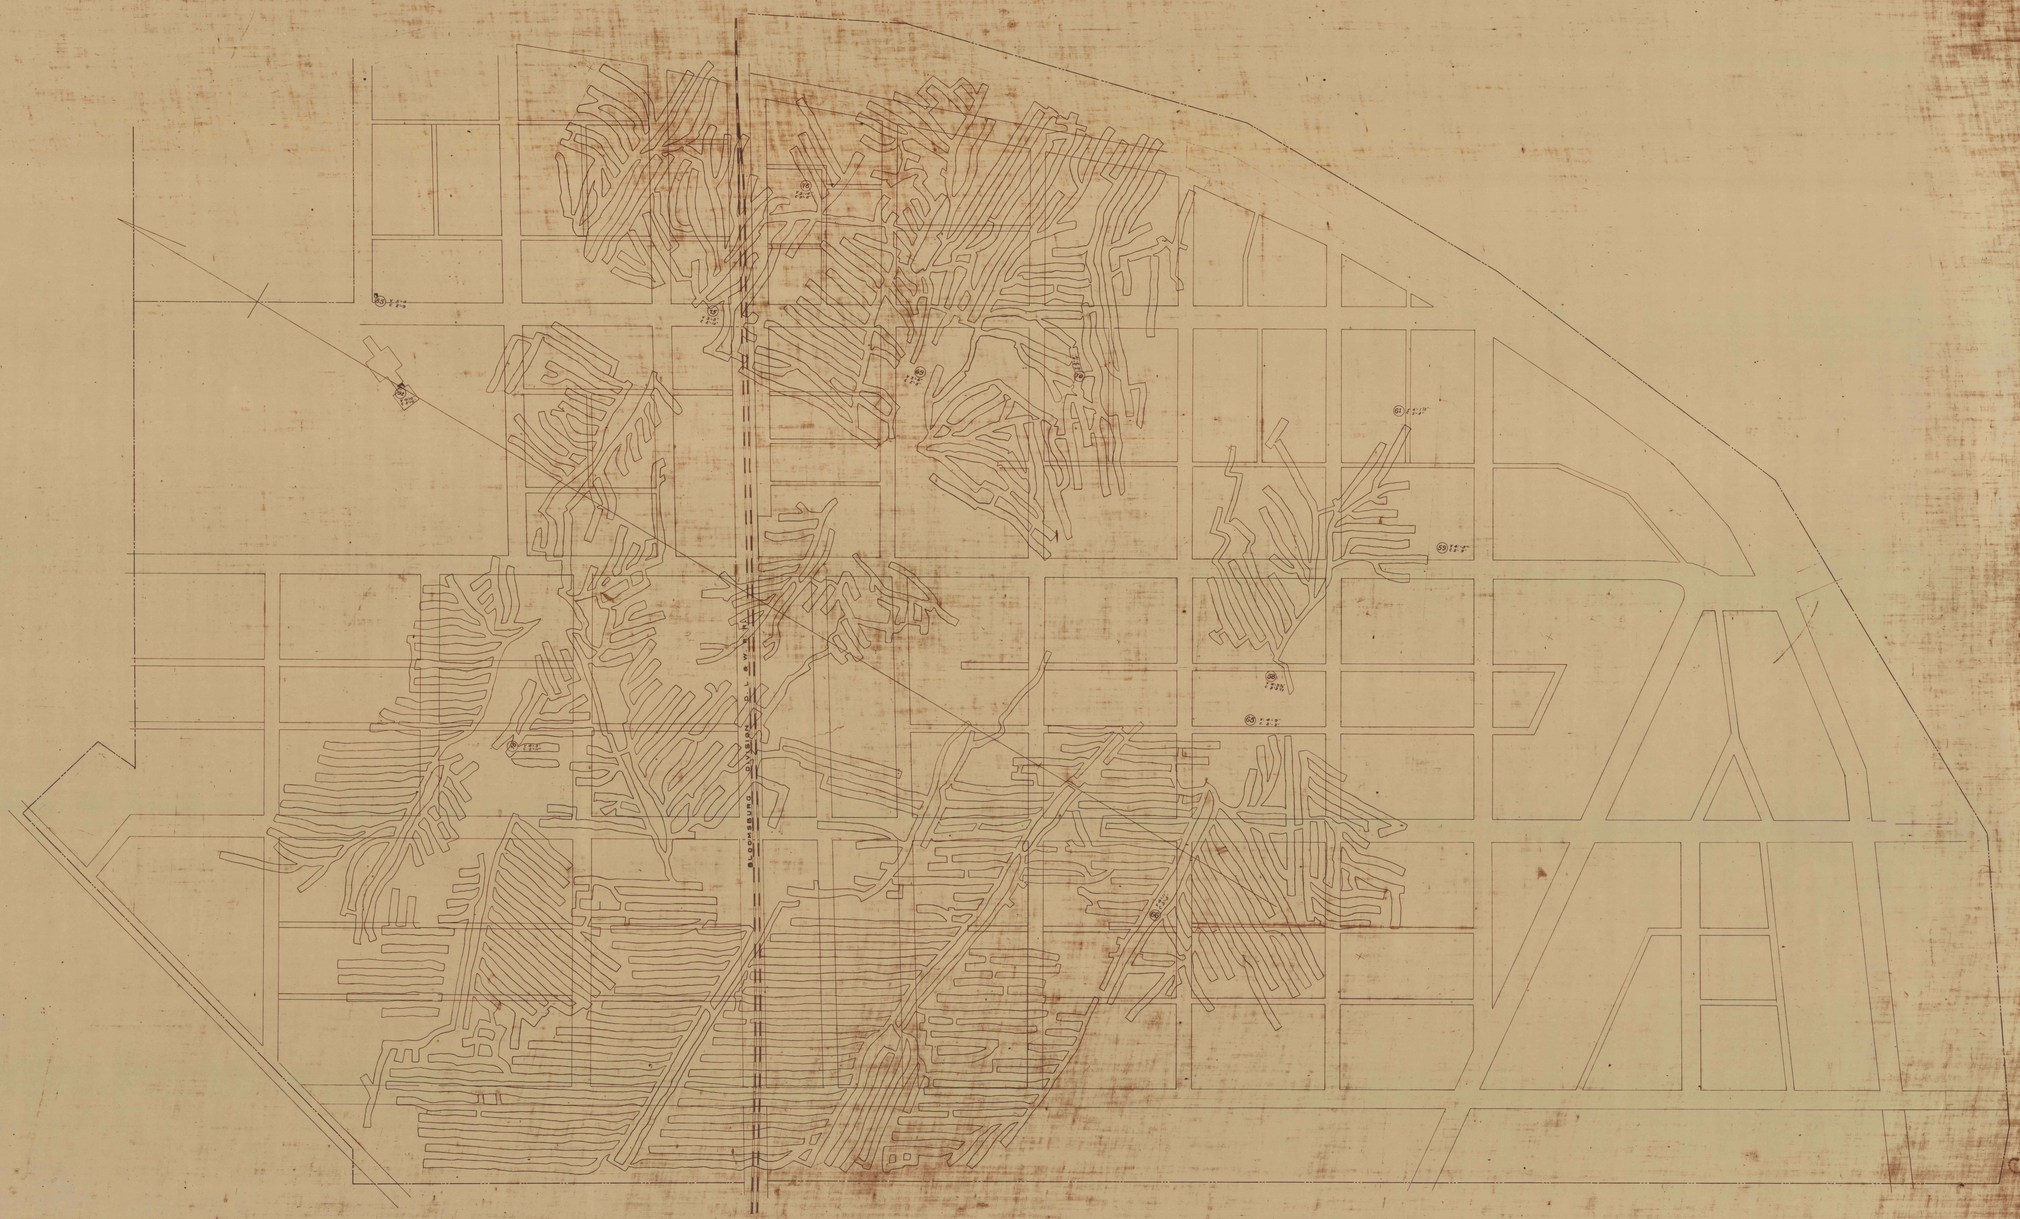

Clear Spring Coal
Middle Red Ash Vein