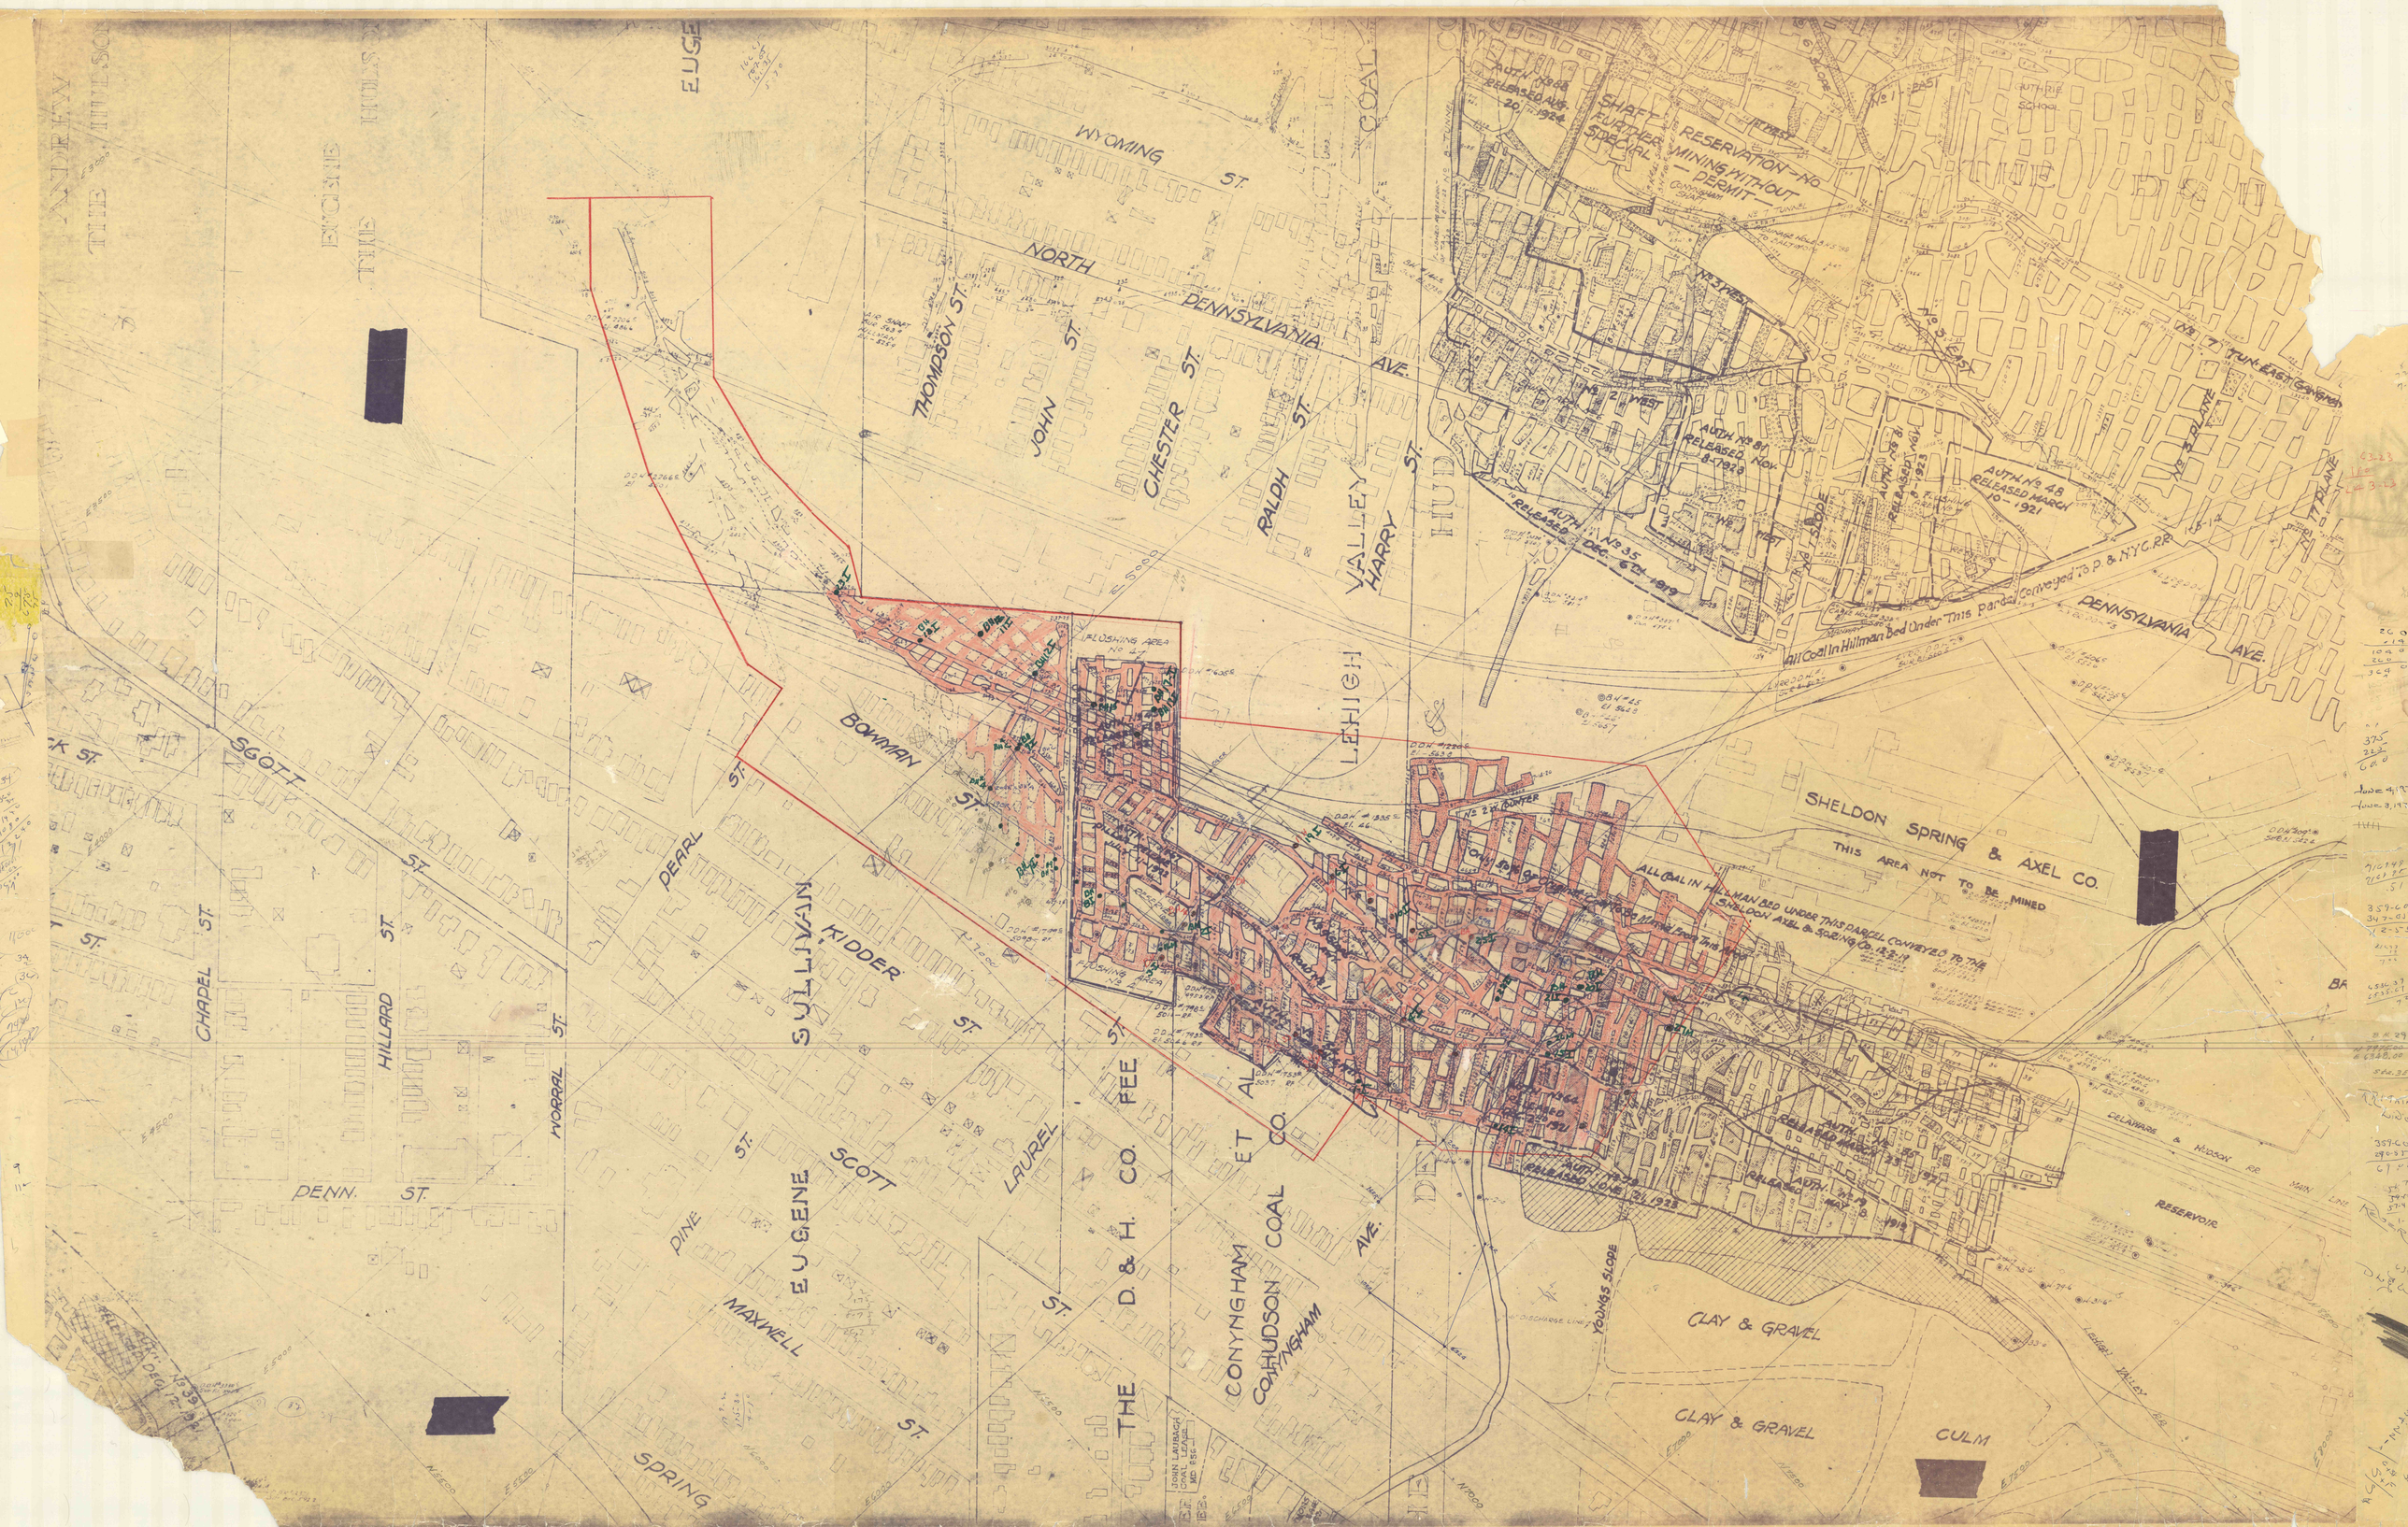

WYOMING ST.
NORTH PENNSYLVANIA AVE.
THOMPSON ST.
JOHN ST.
CHESTER ST.
RALPH ST.
HARRY ST.
LEHIGH VALLEY
COAL
SHAFT RESERVATION - NO FURTHER MINING WITHOUT SPECIAL PERMIT
AUTH. No 48 RELEASED MARCH 10 - 1921
All Coal In Hillman Bed Under This Parcel Conveyed To P. & N.Y.C.R.R.
PENNSYLVANIA AVE.
SHELDON SPRING & AXEL CO.
THIS AREA NOT TO BE MINED
ALL COAL IN HILLMAN BED UNDER THIS PARCEL CONVEYED TO THE SHELDON AXEL & SPRING CO.
FLUSHING AREA No 47
BOWMAN ST.
SCOTT ST.
PEARL ST.
KIDDER ST.
SULLIVAN
CHAPEL ST.
HILLARD ST.
WORRAL ST.
PENN. ST.
PINE ST.
EUGENE SCOTT
LAUREL ST.
MAXWELL ST.
SPRING
THE D. & H. CO. FEE
CONYNGHAM ET AL
HUDSON COAL CO.
CONYNGHAM AVE.
YOUNGS SLOPE
CLAY & GRAVEL
CLAY & GRAVEL
CULM
RESERVOIR
DELAWARE & HUDSON RR MAIN LINE