


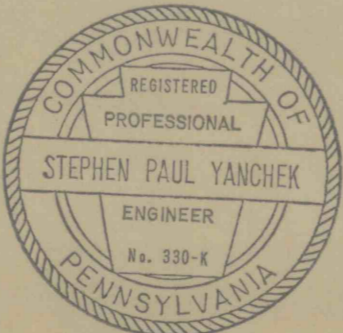


L-25			
As Built Boreholes			
NO.	DATE	REVISION	APPR.
SUBMITTED <i>Stephen P. Yanciek P. E.</i>			
APPROVED _____			
APPROVED _____			
			
COMMONWEALTH OF PENNSYLVANIA DEPARTMENT OF ENVIRONMENTAL RESOURCES OFFICE OF RESOURCES MANAGEMENT			

LEGEND


BORING HOLES THIS CONTRACT

COMMONWEALTH OF PENNSYLVANIA
 DEPARTMENT OF ENVIRONMENTAL RESOURCES
 OFFICE OF ENGINEERING AND CONSTRUCTION
DRILLING & CASING EXPLORATORY BOREHOLES
ABANDONED BALTIMORE COLLIERY SURFACE MAP

BOWMAN ST SUBSIDENCE AREA
CITY OF WILKES-BARRE
LUZERNE COUNTY
PENNSYLVANIA

DESIGNED _____
SUBM. *J.H. [Signature]*
DISTRICT ENGINEER

DRAWN _____
RECOM. *[Signature]*
DIRECTOR BUREAU OF CONST.

GROUP LEADER _____
APPR. *C. [Signature]*
DEPUTY SECRETARY OF ENR COUNTY

DATE _____

DWG. NO. FE4015-11